


RUSTIC ROAD NORTH
PHASES 1 & 2
CONSTRUCTION PLANS
RECORD DRAWINGS PHASE 2 WATER ONLY

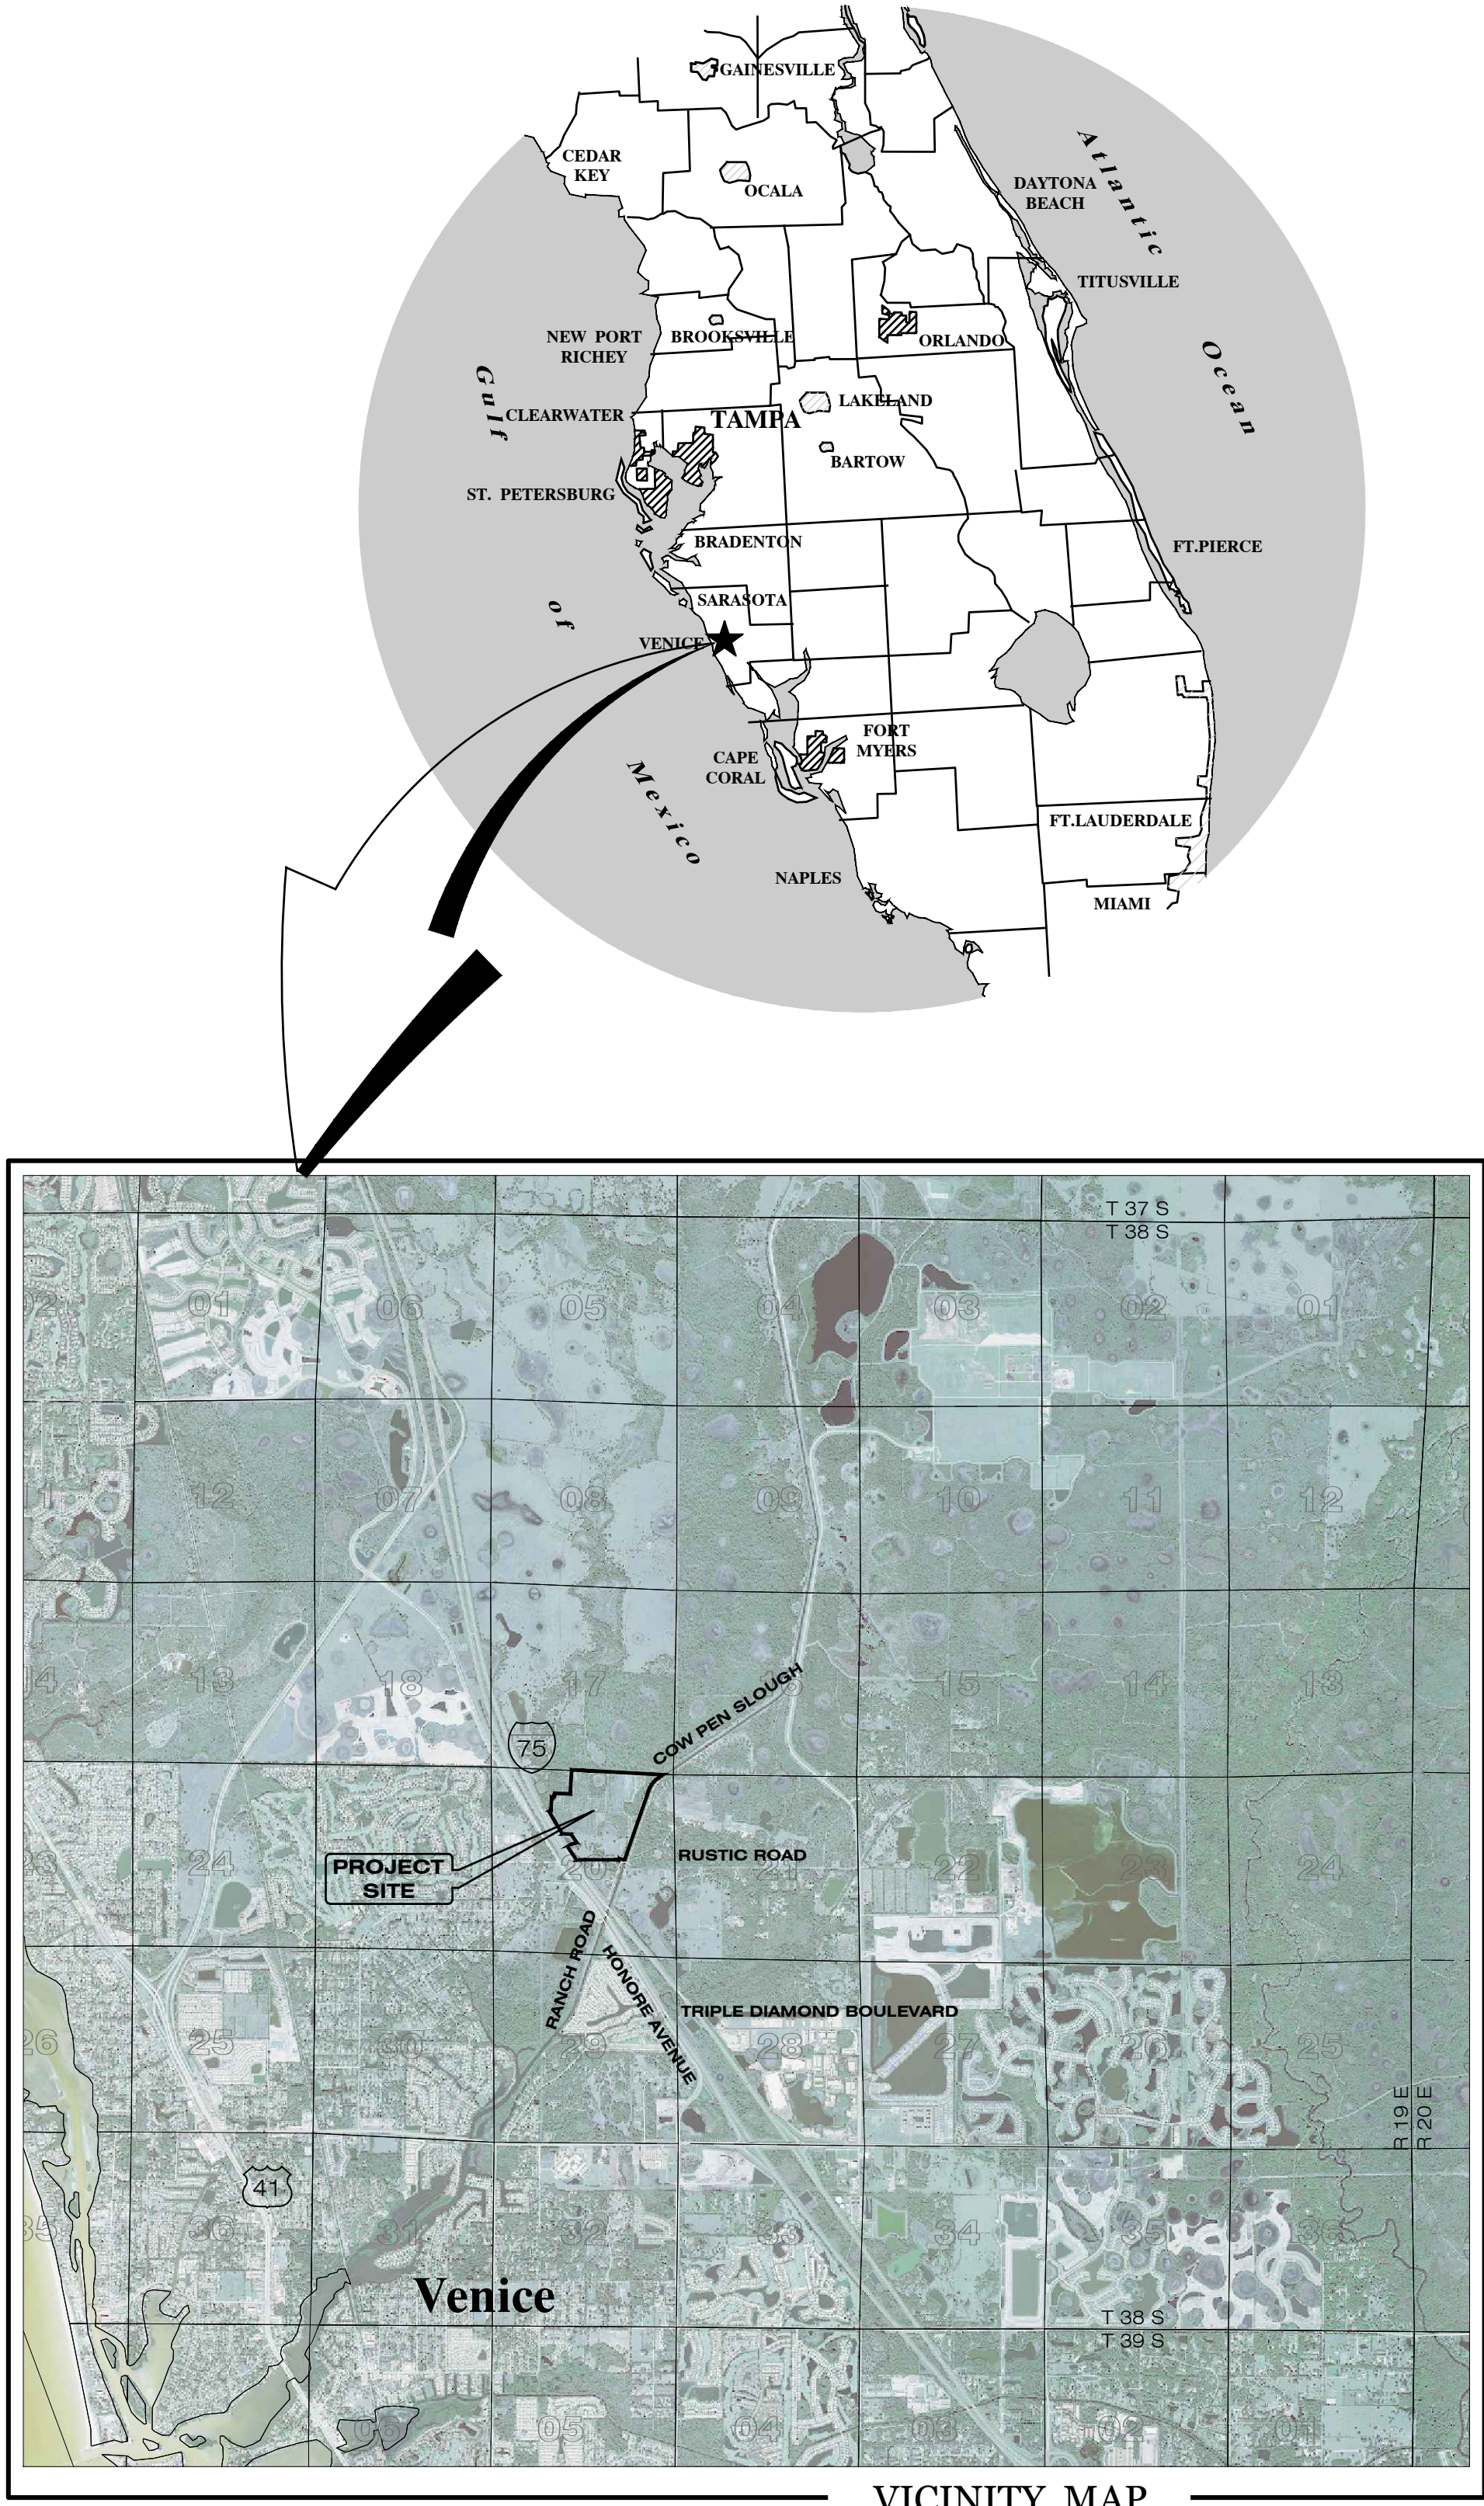

VICINITY MAP
CITY OF VENICE, FLORIDA
SECTION 20, TOWNSHIP 38 SOUTH, RANGE 19 EAST

PERMIT / FILE NOS.	
CITY OF VENICE PREL PLAT NO.	21-05PP
SWFWMD ERP/APPLICATION NO.	App No. 825345
WATER DEP.	
SEWER DEP.	
PARCEL ID NO.(S)	0362-00-1010, 0364-04-0002

CALL 48 HOURS
BEFORE YOU DIG

IT'S THE LAW!
DIAL 811

Know what's below.
Call before you dig.

SUNSHINE STATE ONE CALL OF FLORIDA, INC.

SHEET NO.	DESCRIPTION
1	COVER SHEET
2	GENERAL NOTES
3	AERIAL SITE PLAN
4	EXISTING SITE CONDITIONS
5-6	TYPICAL ROADWAY SECTIONS
7	DRAINAGE KEY MAP
8-10	MASTER DRAINAGE PLAN
11-12	DRAINAGE STRUCTURE DATA
13	CONTROL STRUCTURE DATA
14-18	DRAINAGE SECTIONS
19-26	NEIGHBORHOOD GRADING PLAN
27	MASTER WATER & SEWER PLAN
28	WATER & SEWER NOTES
29-33	WATER & SEWER PLAN
34	PLAN & PROFILE SHEET INDEX
35-51	ROADWAY & UTILITY PLAN & PROFILE
52-56	SIDEWALK, SIGNING & PAVEMENT MARKING PLAN
57	LIFT STATION DESIGN
58-59	LIFT STATION DETAILS
60-62	DRAINAGE DETAILS
63	GENERAL ENGINEERING DETAILS
64-65	SIDEWALK, SIGNING & PAVEMENT MARKING DETAILS
66	GENERAL UTILITY DETAILS
67	POTABLE WATER SYSTEM DETAILS
68	SANITARY SEWER SYSTEM DETAILS
69-70	DRAINAGE AREA MAP
71	SURFACE WATER MANAGEMENT PLAN
2C, 4-9, 12	SHEETS FROM PRELIMINARY PLAT (21-05PP)
L1-L18	SHEETS FROM PRELIMINARY PLAT (21-05PP)

UTILITY INFORMATION		
UTILITY	SOURCE	OWNERSHIP
POTABLE WATER	CITY OF VENICE	CITY OF VENICE
WASTEWATER	CITY OF VENICE	CITY OF VENICE

UTILITY CONTACT INFORMATION	
CITY OF VENICE UTILITIES DEPT. DAMIEN STILLINGS, PE 3510 LAUREL ROAD E VENICE, FL 34275 941-882-7311	FLORIDA POWER & LIGHT JOEL BRAY CONTACT BY PHONE 386-586-6403
FRONTIER COMMUNICATIONS TONI CANNON 3712 W WALNUT ST TAMPA, FL 33607 813-875-1014	COMCAST LEONARD MAXWELL-NEUBOLD 2601 SW 145TH AVE MIRAMAR, FL 33027 754-221-1254
SARASOTA COUNTY TRAFFIC MARK RICHMOND PO BOX 8 SARASOTA, FL 34230-0008 941-861-0942	TECO-PEOPLES GAS-SARASOTA JOAN DOMNING 8416 PALM RIVER RD TAMPA, FL 33619 813-275-3783

RECORD DRAWINGS
August 29, 2025
APPROVED

PREPARED FOR:
JEN TAMPA 1, LLC.
C/O BANYAN LAND CAPITAL, LLC.
1316 West Swann Ave
Tampa, Florida 33606
Phone: (813) 362-1137

PREPARED BY:
Clearview
LAND DESIGN, P.L.
Engineering Business C.A. No.: 28858
3010 W Azeele St., Suite 150, Tampa, Florida 33609
Office: 813-223-3919 Fax: 813-223-3975

RECORD DATA PROVIDED BY
GEOPOINT SURVEYING, INC.

RECORD DRAWING LEGEND

42.00
42.07
54.8
T0000

PROPOSED/DESIGN ELEVATION OR
DIMENSION LINED THROUGH,
"RECORD" ELEVATION OR
DIMENSION WRITTEN IN.

INDICATES RECORD ELEVATION

INDICATES "RECORD" ELEVATION,
DIMENSION, SLOPE, et cetera.

INDICATES "RECORD" ITEM NUMBER

RECORD DRAWINGS
SURVEYORS CERTIFICATION

I HEREBY CERTIFY THAT THE RECORD LOCATIONS
AND ELEVATIONS DEPICTED ON THESE RECORD
DRAWINGS ARE TRUE AND CORRECT AND WERE
COLLECTED IN THE FIELD BY THE SURVEYOR
AND MAPPER OR A REPRESENTATIVE UNDER THE
DIRECT SUPERVISION OF THE SURVEYOR AND
MAPPER.



DATE OF LAST FIELD SURVEY 05/30/2025

JUSTIN O. BRANTLEY, P.S.M.
FLORIDA CERTIFICATE NO. LS6837


				RUSTIC ROAD NORTH PHASES 1 & 2	
				This item has been digitally signed and sealed by JORDAN A. SCHRADER, P.E. on the date adjacent to the seal. Printed copies of this document are not considered signed and sealed and the signature must be verified on any electronic copies.	
06-03-2025 04-25-2024 05-18-2023 03-29-2023 12-20-2022 06-13-2022 05-05-2022 04-19-2022 04-04-2022 03-25-2022 11-05-2021 11-05-2021 10-22-2021 05-17-2021		RECORD DATA 45-51 27 519-26,29,33,35-56 29 8,11,19,35 57,58 11,12 27,29,31,35-37,42,43,57,58 11,50 12 1,5,35,45,46 1,29,30,33,35,37,42,45 1,6,18-20,27,29,32,33,35-52,57 INITIAL SUBMITTAL		JRD MMR JRD JRD RED MED DA TJF TJF TJF TJF DA DA DA JAS	
DATE		SHEET NO.		BY	
REVISIONS					

DATE: 06/03/2025		JORDAN A. SCHRADER, P.E. NO. 74798 FLORIDA PROFESSIONAL ENGINEER	
DATE: 06-03-2025		JOB NO. JEN-RU-008	
Elevations based on North American Vertical Datum 1988 (NAVD 88) Conversion from NAVD 88 to NGVD 29 = +1.11 Feet			
STREET & DRAINAGE		WATER & SANITARY SEWER	
DESIGNED BY: FERREIRA		DESIGNED BY: DUNCAN	
DRAWN BY: DUNCAN		DRAWN BY: DUNCAN	
FILE: CV		SHEET 1 OF 71	

DATE	SHEET NO.	BY
06-03-2025	RECORD DATA 45-51	JRD
04-25-2024	27	JRD
05-18-2023	519-26,29-33,35-56	JRD
03-29-2023	29	RR
12-20-2022	8,11,19,35	MED
06-13-2022	57,58	DA
05-05-2022	11,12	TJF
04-19-2022	27,29,31,35-37,42,43,57,58	TJF
04-04-2022	11,50	TJF
03-25-2022	12	TJF
11-15-2021	1,5,35,45,46	DA
11-05-2021	1,29,30,33,35,37,42,45	DA
10-22-2021	1,8,18-20,27,29,32,33,35-52,57	DA
05-17-2021	INITIAL SUBMITTAL	DA

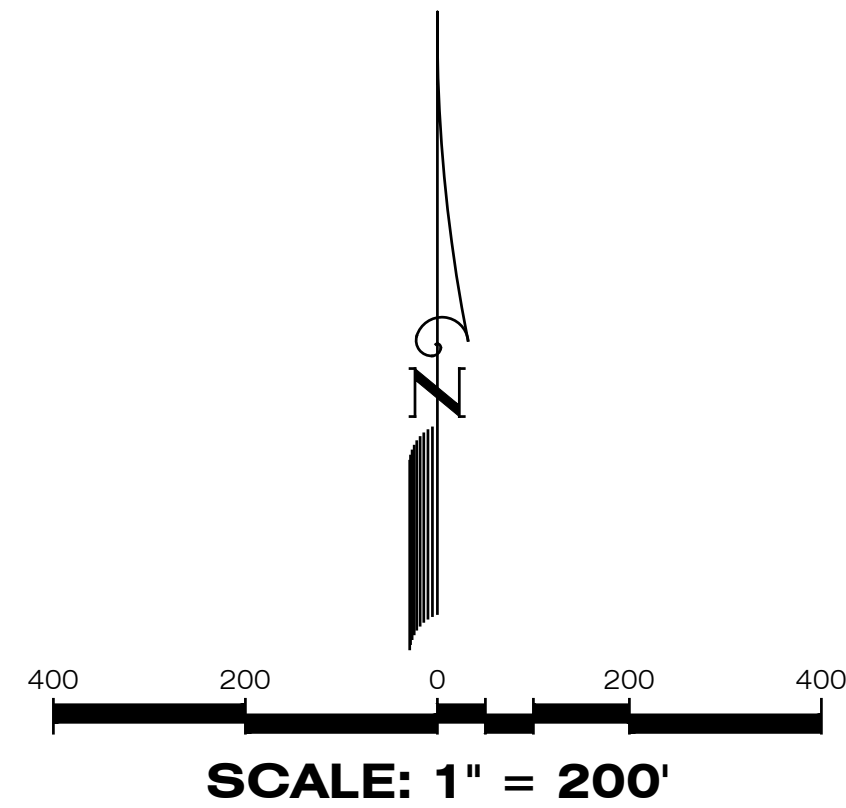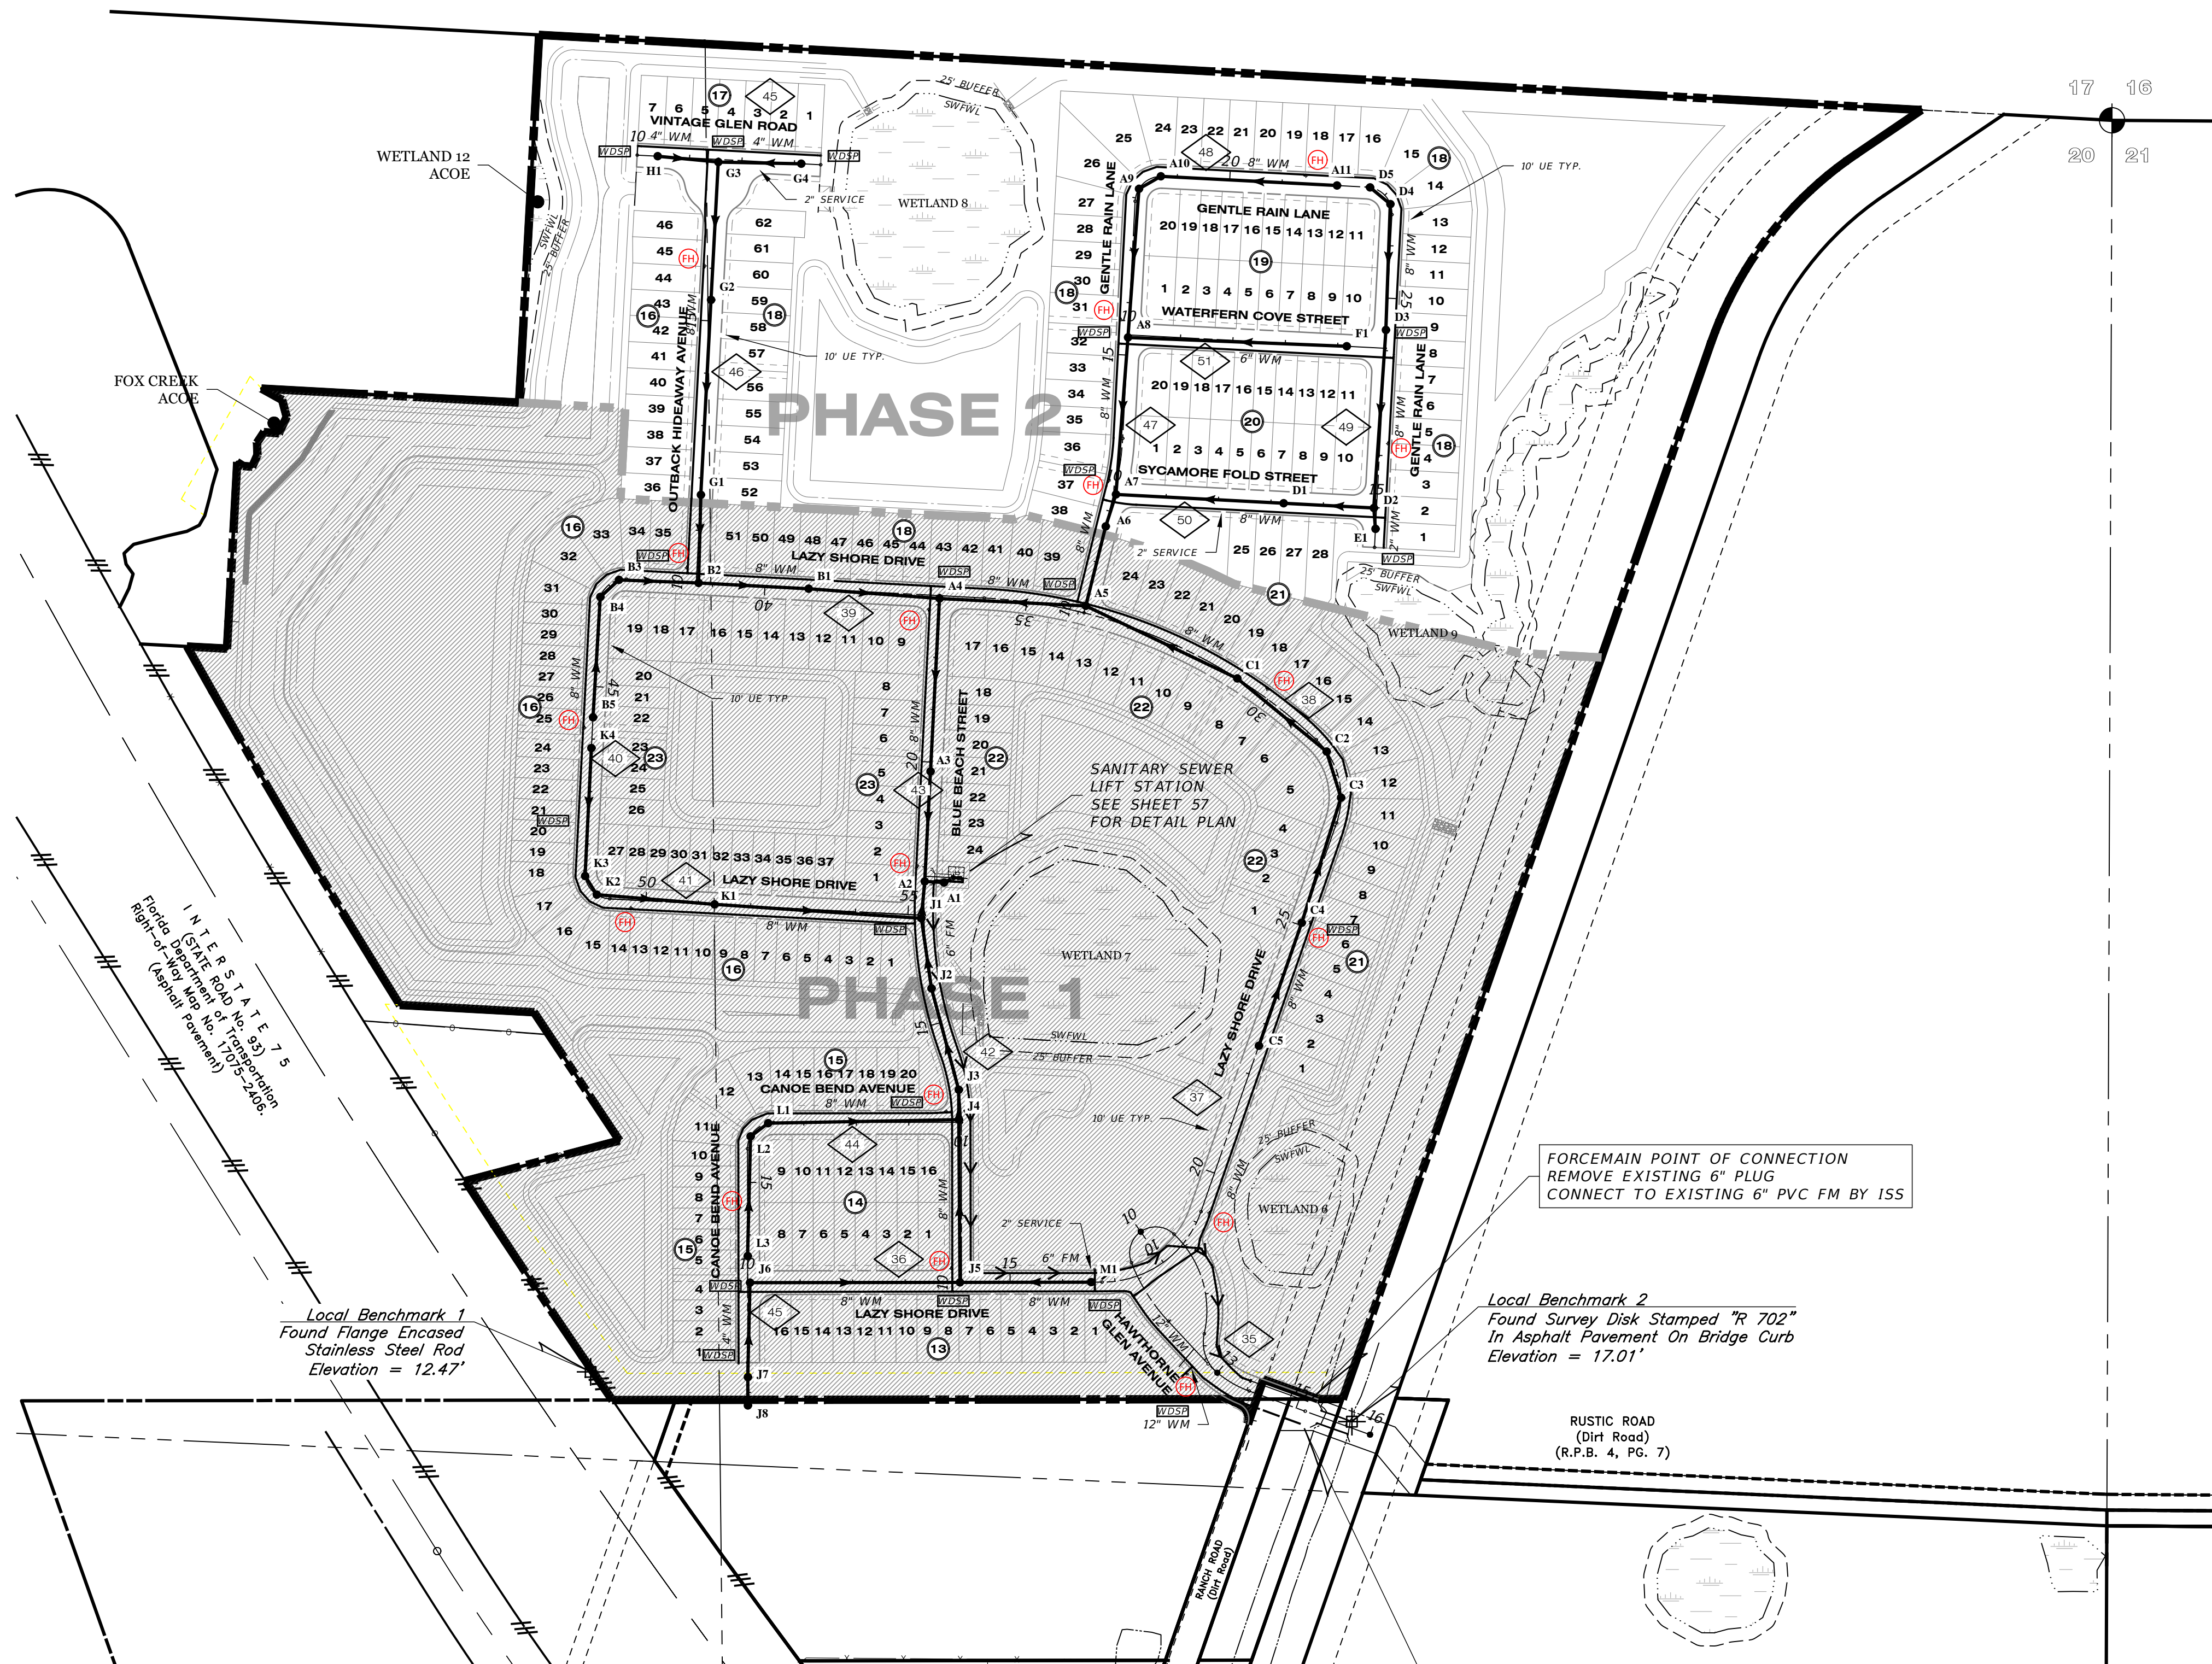

LEGEND	
EXISTING	PROPOSED

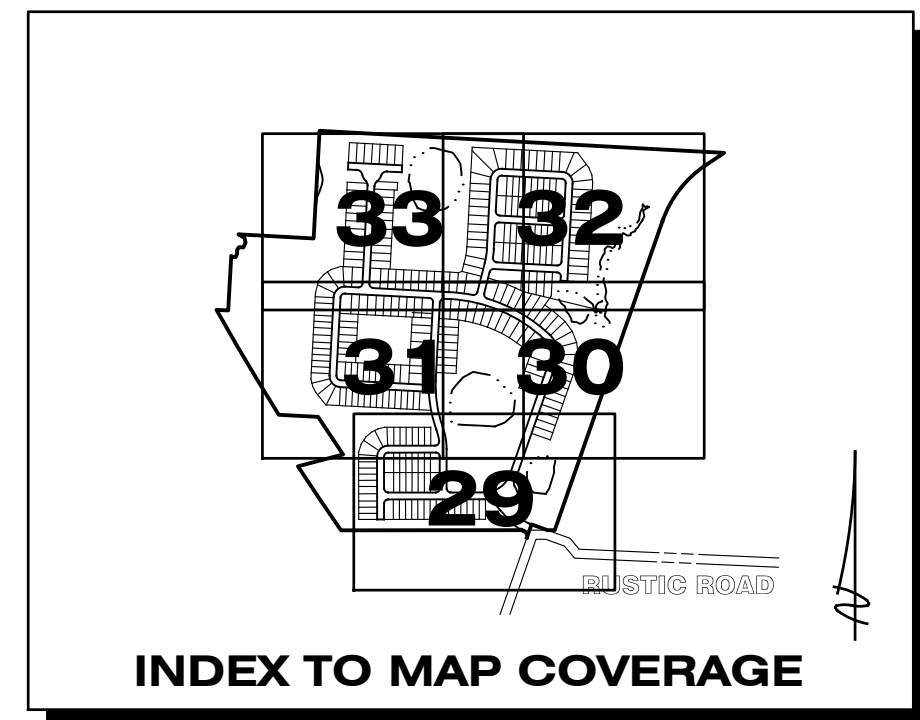

ALL MANHOLES AND SERVICES
ARE TO HAVE A MINIMUM
SEPARATION OF 5 FEET

REFER TO DRAINAGE KEY MAP
FOR WETLAND INFORMATION

HIGH-PRESSURE GAS MAIN
IN CONSTRUCTION AREA

REFER TO SHEET 28 FOR
WATER & SEWER NOTES

04-19-2022 10-22-2021 05-17-2021		4" FM REVISED TO 6" FM ADD MH 18 INITIAL SUBMITTAL	TJF DA JAS
DATE		DESCRIPTION	BY
		REVISIONS	
This item has been digitally signed and sealed by JORDAN A. SCHRADER, P.E. on the date adjacent to the seal. Printed copies of this document are not considered signed and sealed and the signature must be verified on any electronic copies.			
DATE: 06/03/2025 JORDAN A. SCHRADER, P.E. NO. 74798 FLORIDA PROFESSIONAL ENGINEER			
JOB NO. JEN-RU-008		MASTER WATER & SEWER PLAN	
DESIGN FERREIRA		RUSTIC ROAD NORTH PHASES 1 & 2	
DRAWN DUNCAN		PREPARED FOR: JEN TAMPA 1, LLC. C/O BANYAN LAND CAPITAL, LLC.	
DATE 06-03-2025		Elevations based on North American Vertical Datum 1988 (NAVD 88) Conversion from NAVD 88 to NGVD 29 = +1.11 Feet	
FILE WSKEY		SHEET 27 OF 71 SHEETS	



RECORD DRAWINGS

August 29, 2025

APPROVED

WATER AND SEWER CONSTRUCTION NOTES:

- Prior to construction, the Contractor shall obtain from the Engineer or Owner a copy of all pertinent permits related to this project. It is the Contractor's responsibility to assure that all construction activities are in compliance with the conditions of all permits and approvals.
- All construction, materials and workmanship are to be in accordance with City of Venice Standard Details and Sarasota County, General Notes and Testing Requirements Dated January 2018.
- Grass and mulch, or solid sod, all areas in existing rights-of-way disturbed by construction.
- In accordance with the Underground Facility Damage Prevention and Safety Act (Chapter 356, F.S.), the Contractor shall call the Sunshine State One Call of Florida (SSCOF) at 811 forty eight (48) hours in advance of any excavation.
- Contractor shall contact the engineer and/or the owner prior to any construction that may damage trees.
- Contractor shall verify locations and depths of existing water and sewer lines prior to beginning construction.
- Contractor shall be responsible for obtaining any and all road crossing and/or utility permits.
- The field-surveyed or reported locations of all existing underground and above-ground utilities known to exist at the time of plans production have been depicted hereon, however conflicts between existing and proposed utilities shall be brought to the attention of the Engineer of Record immediately.
- Adjusting manhole tops to match grade and slope of the finish paving shall be included in the respective contract unit price for manholes, payment of which will constitute full compensation for the construction and completion of the manhole, and no additional payment will be allowed or made for adjusting manhole tops.
- All Sanitary Sewer Manholes shall be constructed in unpaved areas shall have water tight ring and cover.
- The locations and elevation of all service lines are to be determined in the field by owner and/or contractor prior to construction of same.
- All sanitary sewer laterals shall be marked with an electronic 4" diameter ball marker compatible with the Water Resource Services Department's electronic locator and left in place after the connection is made to the building.
- All sanitary sewer gravity main pipe and fittings shall be PVC SDR-26, and shall comply with ASTM D 3034.
- All 6" sanitary sewer pipe shall be constructed at a 1.0% minimum slope.
- All 4" sanitary sewer pipe shall be constructed at a 1.2% minimum slope.
- All water main pressure pipe shall have a minimum 36" cover.
- All PVC water main pressure pipe shall conform to the requirements found in AWWA C-900, Class 200, DR-18 latest edition at the time of plan approval. All fittings and required appurtenances shall meet the requirements of the Standard Details, General Notes and Testing Requirements Dated January 2018.
- All DIP water main pressure pipe shall be Class 50 and conform to the requirements found in ANSI/AWWA C151/A 21.51.
- All water main pipe and fittings installed under this project shall be color coded or marked in accordance with subparagraph 62-555.320(21)(b)3, Florida Administrative Codes, using blue as the predominant color.
- Sanitary sewers, force and reclaimed mains and storm sewers shall cross under water mains. Sanitary sewers, force and reclaimed mains and storm sewers crossing water mains shall be laid to provide a minimum vertical distance of 18 inches between the invert of the upper pipe and the crown of the lower pipe whenever possible.
- When sanitary sewers, force and reclaimed mains and storm sewers must cross a water main with less than 18 inches vertical distance, the water main shall be constructed of ductile iron pipe (DIP) at the crossing. Sufficient lengths of DIP must be used to provide a minimum separation of 10 feet between any two joints. All joints on the water main within 20 feet of the crossing must be leak free and mechanically restrained. A minimum vertical clearance of 6 inches must be maintained at the crossing.
- Where there is no alternative to sewer and reclaimed pipes crossing over a water main, the criteria for minimum separation of 18 inches between lines and 10 feet between joints shall be required.
- All crossings shall be arranged so that the sewer and reclaimed pipes joints and the water main pipe joints are equidistant from the point of crossing (pipes centered on the crossing).
- Where a new pipe conflicts with an existing pipe, the new pipe shall be constructed of DIP and the crossing shall be arranged to meet the requirements above.
- A minimum 10-foot horizontal separation shall be maintained between any type of sewer and water main in parallel installations whenever possible. A minimum 5-foot horizontal separation shall be maintained between reclaimed water mains and water mains in parallel installation whenever possible.
- In cases where it is not possible to maintain a 10-foot horizontal separation between any type of parallel sewer and water main, the water main shall be laid in a separate trench or on an undisturbed earth shelf located on one side of the sewer or force main at such an elevation that the bottom of the water main is at least 18 inches above the top of the sewer.
- Where it is not possible to maintain a vertical distance of 18 inches or a horizontal distance of 10 feet in parallel installations, the water main shall be constructed of DIP and the sewer or the force main shall be constructed of DIP (if available in the size proposed) with a minimum vertical distance of 6 inches. The water main should always be above the sewer. Joints on the water main shall be located as far apart as possible from joints on the sewer or force main (staggered joints).
- All DIP shall be class 50 or higher. Adequate protective measures against corrosion shall be used.
- Water main shall be located 5' off right-of-way line unless otherwise noted.
- All PVC force main pressure pipe sizes 4" - 12" shall be AWWA C900 DR 18 PVC;

- sizes 16" and greater shall be AWWA C905 SDR 18 PVC.
- Force main shall be located 5' off right-of-way line unless otherwise noted.
- Force main depth of cover shall not be less than 48".
- Bends shall be installed in force main and/or water main to avoid unforeseen conflicts in existing or proposed structures.
- The joint deflection method shall be used where practical in lieu of installing bends.
- Fire hydrant, gate valve and blow-off valve assemblies shall consist of all pipe, valves, tees, fittings, and any and all other appurtenances comprising a complete, working unit.
- The location of new fire hydrants shall be identified with a blue reflective pavement marker installed on the roadway. The reflective marker shall be located perpendicular to the hydrant, in the center of the lane closest to the hydrant.
- The Engineer of Record and/or Contractor shall be responsible for the flow testing and color coding of all newly installed fire hydrants in the existing or proposed City of Venice right-of-way and utility easements that are to be dedicated to City of Venice prior to the final inspection of the project. The Engineer of Record and/or Contractor shall refer to NFPA Standard 291 for flow testing and color coding methods and procedures.
- On both water and sewer taps, contractor to provide and install tapping sleeve and valve and all appurtenances for City of Venice or Sarasota County.
- All valve box assemblies located within roadways or parking areas shall be protected from truck traffic by use of 6" thick reinforced concrete pads poured around valve boxes (see detail).

TRENCH NOTES

- Where water, reuse and/or sewer mains cross with less than eighteen inches (18") vertical clearance, one of the following methods of protection shall be utilized:
A. Should a conflict arise with an existing sewer or reuse main the proposed water main shall be minimum of twenty feet (20') of AWWA C-900 DR-14 PVC or CL-51 D.I.P. centered on the point of crossing.
B. Where a conflict arises with an existing water or reuse main, the proposed sewer main shall be a minimum of twenty feet (20') of AWWA C-900 DR-14 PVC, centered on the point of crossing.
C. Where a conflict arises with proposed water, reuse and/or sewer mains, the water and reuse main shall be a minimum of twenty feet (20') of AWWA C-900, DR-14 PVC, or CL-51 D.I.P., while the sewer main shall be a minimum of twenty feet (20') of AWWA C-900 DR-14 PVC, centered on the point of crossing.
- When a water main parallels a wastewater line, a horizontal separation of at least ten feet (10') from outside edge to outside edge, should be maintained. When separated by less than 10 feet (10') horizontally the water main shall be AWWA C-900 DR-14 PVC, or Class 51 D.I.P., and sewer lines shall be AWWA C-900 DR-14 PVC. Joints shall be staggered to maximize joint separation.
- When a water main or wastewater line parallels a reuse main, a horizontal separation of at least five feet (5') center of pipe to center of pipe, should be maintained. In no case shall the horizontal separation be less than three feet (3') from outside edge of pipe to outside edge of pipe.
- Trench shall be braced or shored in accordance with the "Florida Trench & Safety Act".
- Width of trench bottom shall be outside diameter of pipe plus twelve inches (12"). Each side, maximum.
- Contractor shall place metallic burial identification tape directly above water main in conformance with County Code.
- All well point holes shall be filled with coarse sand or other satisfactory granular material at time well points are pulled.
- Discharge from de-watering operation shall be disposed of in such a manner that 1) shall not interfere with the normal drainage of the area in which the work is being performed, create a public nuisance or form ponding. The operation shall not cause injury, to any portion of the work completed, or in progress, or to the surface of streets, or to private property.
- The proposed de-watering method(s) and schedule shall be coordinated with the utility and/or the Engineer of Record and other necessary regulatory agencies prior to construction, additionally, where private property shall be involved, advance permission shall be obtained by the contractor and/or developer.
- The contractor shall provide soil compaction testing in accordance with the project specification. If the specification does not address compaction tests, they shall be done in accordance with the City of Venice uniform water and wastewater system and the reuse code, latest edition. All soil compaction test results shall be submitted to the Engineer or Record.
- All subsurface construction shall comply with the "Trench Safety Act." The Contractor shall ensure that the method of trench protection and construction is in compliance with the Occupational Safety and Health Administration (OSHA) regulations.

Water Distribution General Notes

The following notes are intended as a supplement to the project specifications and are not intended to supersede the project specifications. It is assumed the irrigation mains are or will convey reuse waters.

- The Contractor shall investigate and verify before starting work. He shall be liable for any expense resulting from damage to same. Any conflicts with existing utilities shall be brought to the attention of the engineer as soon as possible.
- It shall be the responsibility of the contractor to notify the county, utility companies and the engineer 48 hours prior to any work at site. Water main tie-ins requiring water service to be shut off shall be made when required by the City of Venice.
- Water main installation shall be constructed with a minimum of 3 feet of cover below proposed grade and to the elevations and depths as indicated on the plans within 0.25 ft. Cost to relay main, if necessary, shall be borne by the contractor.
- All disturbed areas in existing lawns shall be replaced with sod equal to or better than existing and of the same type. Swale slopes and bottom shall be sodded to eliminate erosion. Restoration due to erosion occurring prior to grass rooting, shall be the responsibility of the contractor. The contractor shall water as necessary all sodded areas until grass roots.
- Due to the proximity of existing drainage structures, roadway pavement, golf cart paths, curbs, culverts, residential structures, mailboxes, etc., to the contractor shall use excavating methods which shall prevent any damage to same unless removal is required. The cost of any damage and the replacement of all private property damaged by the contractor's operations shall be borne by the contractor.
- All existing salvageable pipe fittings, etc., shall remain the property of the owner and be stored on site at the direction of the engineer.
- All PVC water mains shall be blue in color. Color-coded plastic-coated metal tape 3" wide with the word "water main" shall be placed 18 inches below finished ground and above DIP and PVC water main. Also attach a color-coded continuous number 12 insulated wire on top of the pipe and as indicated on the details for valves, hydrants, blowoffs, etc. The cost for color tape and copper tracing wire shall be included in the water main unit prices.
- The contractor shall coordinate holding of poles with utility companies in advance so unnecessary delays of project shall not be incurred. The cost for the holding of the power poles shall be included in the water main unit cost items contained in the proposal.
- All Construction shall meet the minimum requirements of City of Venice Ordinance #99-058 and #99-063 (uniform water, wastewater & reuse system code), latest revision, and exceed the requirements of that ordinance where indicated on these construction drawings or in the project specifications.
- Unless otherwise noted proposed water mains shall be adjusted to go over storm crossings wherever possible. Modifications to material and separation may be made to increase cover as approved by the EOR.
- Restoration of all existing roadways to City of Venice standards and the replacement of existing culverts and driveways etc., shall be included in the unit bid price of the water main items.
- Connections to existing water lines will not be permitted until all new water lines have successfully completed all pressure and bacteriological testing.
- The contractor shall notify City of Venice utilities department or the private utility regarding the disposition of any fittings, etc., that are to be removed.
- The contractor shall provide and utilize a metered jumper assembly between the existing potable water source piping and the new water main in order to provide backflow prevention while filling and flushing the new water main. Final tie-in shall be completed only after the new system has been flushed clean, pressure tested, disinfected, bacteriologically cleared, certified complete by the engineer, and a release is obtained from the health department. Engineer's representative to be present at final tie-in. The length of pipe required for final tie-in shall be limited to less than 20 feet. All work shall be completed in accordance with health department and local government rules and regulations.

Service Details

- All meter boxes have been calculated for location and shall be staked accordingly in the field. Boxes found not constructed to the proposed location shall be removed and relocated by the contractor at no additional charge. Those boxes shown in clusters shall be placed in a neat row and against each other.
- All existing and proposed valve boxes shall be adjusted to finished grades as established in the field. No additional compensation shall be made by the owner.
- Fire hydrants shall be constructed with "ground line" set to finished grades as established in the field. Normal bury is 3 feet of cover for water lines. If extensions are required, the cost shall be included in the price bid.
- Air release taps shall be installed in water mains at high points where required. These locations shall be located on the record drawings. No air releases shall be located on water services. Air Release Valves shall be minimized throughout the water system.
- 2 inches or smaller diameter services shall include the service saddle, corporation stop, variable length P.E. 3406 -- A.S.T.M. 2737 copper tube size service pipe, curb stop and meter box of the size for meter indicated.
- Vertical clearance between water and storm/reuse/wastewater lines shall be 18 inches minimum.
- A "V" or "Y" shall be stamped into curb where water service or water valve is located in accordance with county code. A measurement from edge of curb taken by the contractor, shall be shown on the record plans for reference in locating the service or the valve.

As-Builts

- The contractor shall locate valves, services, hydrants, air release valves, etc. By using a two (2) point swing measurement from permanent physical features that can readily be found on the drawing and in the field. These measurements shall be shown on the "as-built" drawing by the contractor and presented to the engineer at each partial payment application for permanent recording.
- The contractor shall furnish "as-built" top of pipe elevations of all water mains every 100', all fittings and all changes in grade.
- Record drawings, if prepared by the contractor or contractors surveyor. Draft copies of the record drawings shall be submitted to the engineer prior to finalizing the drawings. Once acceptable to the engineer, the contractor/surveyor will provide 9 sets of signed and sealed finalized drawings within 7 days of bacteriological clearance testing for submittal to the county. Once the drawings are approved by the county, contractor/surveyor is responsible to provide the engineer of record one set of Mylars and a digital copy of record drawings in AutoCAD 14 format. Record information shall be on unique layer(s), using text shape file that comes with standard AutoCAD. As-builts shall include a GIS submittal per COV standards

Joint Restraining

- The contractor shall provide all joint restraining as required. See restrained joint tables.
- Design criteria: 150 p.s.i. test pressure times 2 safety factor (300 p.s.i.) for water hammer with assumed soil bearing capacity of 1000 lbs. Per square foot.
- Completely coat exposed tie-bars or other uncoated steel after installation with two coats of porter tarseal max-build 7080 at 8 mils d.f.t. each (coat) used in accordance with manufacturer's recommendations.

Wastewater Collection General Notes

The following notes are intended as a supplement to the project specifications and are not intended to supersede the specifications.

- Elevations shown on the plans for flowlines of proposed wastewater mains shall be adhered to. In most cases the design grades are critical, and adjustments caused by misalignment or improper grades are impractical. Cost to relay main, if necessary, shall be borne by the contractor.
- The contractor shall investigate and verify or have verified the location of existing utilities and any other subsurface facilities before starting work. He shall be liable for any expense resulting from damage to same. Any conflicts with existing utilities shall be brought to the attention of the engineer as soon as possible.
- It shall be the responsibility of the contractor to notify the county, utility companies and the engineer 48 hours prior to any work at site and 48 hours prior to any testing. Please note that all scheduling for any inspections, testing, start of construction etc. shall be coordinated with Veronica Ford, vford@sgcnet.net and 941-861-6625.
- The contractor shall coordinate holding of poles with utility companies in advance so unnecessary delays of project shall not be incurred. The cost for the holding of the power poles shall be included in the wastewater main unit cost items contained in the proposal.
- All disturbed areas in existing lawns shall be replaced with sod equal to or better than existing and of the same type. Swale slopes and bottoms shall be sodded to eliminate erosion. Restoration due to erosion occurring prior to grass rooting, shall be the responsibility of the contractor. The contractor shall water as necessary all sodded areas until grass roots.
- Due to the proximity of existing drainage structures, roadway pavement, golf cart paths, curbs, culverts, residential structures, mailboxes, etc., the contractor shall use excavating methods which shall prevent any damage to same unless removal is required. The cost of any damage and the replacement of all private property damaged by the contractor's operations shall be borne by the contractor.
- For painting and surface finishing requirements, refer to appropriate division of the project specifications.
- Pipe and fittings for P.V.C. gravity pipe shall meet the requirements of A.S.T.M. specification D-3034 (SDR 26).
- Force mains shall be restrained joint in accordance with the water main details unless otherwise specified.
- All PVC force mains shall be green in color. Color-coded plastic-coated metal tape 3" wide with the word "force main" shall be placed 18 inches below finished ground and above force main. Also attach a color-coded continuous number 12 insulated wire on top of the pipe and as indicated on the details for valves, hydrants, blow offs, etc. The cost for color tape and copper tracing wire shall be included in the force main unit prices.

Sewer Testing

- Testing shall be in conformance with the City of Venice "Standard Details, General Notes, and Testing Requirements" Manual, or the specifications, whichever is stricter.
- The contractor shall include in his cost for the various items contained in the bid schedule, the additional costs involved with limping the newly laid sewer pipe, exfiltration or infiltration testing and pipe deflection tests, all as outlined in the Sarasota county "uniform water, wastewater and reuse systems code". Please note limping of sewer lines is not allowed.
- The contractor shall have the new sewer system TV. Inspected as per the City of Venice "Standard Details, General Notes, and Testing Requirements" Manual.

As-Builts:

- The contractor shall locate manholes, services, etc. By using a two (2) point swing measurement from permanent physical features that can readily be found on the drawing and in the field. These measurements shall be shown on the "as-built" drawing by the contractor.
- The contractor shall furnish "as-built" stationing of sewer wyes using each downstream manhole as station 0+000.
- Top of pipe elevations for all force mains are required at a maximum interval of every 100' and every fitting or change in grade.
- Record drawings, if prepared by the contractor or contractors' surveyor. Draft copies of the record drawings shall be submitted to the engineer prior to finalizing the drawings. Once acceptable to the engineer, the contractor/surveyor will provide 9 sets of signed and sealed finalized drawings for submittal to the county. Once approved by the county, contractor/surveyor is responsible to provide the engineer of record one set of Mylars and a digital copy of record drawings in AutoCAD 14 format, record information shall be on unique layer(s), using text shape file that comes with standard AutoCAD.

Sanitary Manhole Notes

- Lift holes through precast structures are not permitted. All openings shall be sealed and waterproofed as specified and directed by the engineer.
- Manholes shall comply with ASTM, specification C-478, Latest revision, "precast reinforced concrete manhole sections", except as exceeded by the details and specifications.
- Cement shall be Type II.
- Concrete shall be 4000 PSI. 6 28-day minimum strength, unless otherwise noted.
- Mortar shall be 2 parts clean sand and one (1) part cement with no more than ¼ part hydrated lime.
- Mortar joints shall be full and struck flush.
- Drop construction shall be provided for a wastewater pipe entering a manhole at an elevation of twenty-four inches (24") or more above the discharge channel flow line.
- No steps shall be used.
- Provide six (6) inch minimum base slab lip as shown in detail. For manhole depths greater than 13', contractor shall submit buoyancy calculations. Based on the calculations, additional concrete ballast or a base slab lip in excess of 6" may be required.
- Having the rubber gasket seal integrally poured into manhole sections at a non-plan position shall be cause for that section to be rejected. It is important for manufacturers of precast manholes to be informed by the contractor of the rejection possibility.
- Manhole ring and cover shall be as specified.
- Manhole rings and covers shall be adjusted to conform with finished surfaces including slope if any (using beveled adjustment rings). All adjustments shall be included in the price bid. No additional compensation shall be made by the owner. Manholes in grassed areas shall be set 0.1 above finished ground.

Clean-Out Notes

- Cleanouts are required on all services.
- Clean-outs shall be adjusted to conform with finished surfaces. All adjustments shall be included in the price bid. No additional compensation shall be made by the owner.

Sanitary Sewer Service Notes

- A "S", "V" or "M" shall be stamped in curb where sewer service, valve or manhole is in accordance with the County Code. A measurement from the edge of curb, taken by the contractor, shall be shown on the 'as built' plans for reference in location service, valve, or manhole.
- On uncurbed streets, the location for each installed service valve or manhole shall be marked by using and aluminum disc laded sewer, as supplied by national band and tag Co. The horizontal distance to the service, valve or Manhole is to be engraved on the tag and the tag shall be mounted in the pavement, within 6" from the edge.
- Metallic identification tape shall extend from the wye connection to the end of the service and terminate twelve inches (12") above ground at the location stake. In addition, the contractor shall bury a two-foot, (2') foot long #3 rebar at the end of the service parallel to the surface for electronic location purposes. Cost of tape and rebar to be included in the cost for service pipe installation.
- Where service wye connection exceeds either fee in dept, the wye and service pipe shall be encased in concrete. When the service pipe grad is 10% or greater, the encasement shall extend from the wye to a point where the service pipe grade is less than 10% as shown. Concrete shall be 3000 PSI at 28 days, minimum 6" thick.
- Where a house or other connection terminates, the contractor shall provide and install 2" x 4" stake with a minimum of four (4) feet above ground and two (2) feet below ground. The top twelve inches (12") are to be painted green.

Notes:

- Trench Width shall be approximately equal to the pipe dia. + 2 feet or as per AWWA and the manufacturers recommendations
- Provide sheeting and shoring as necessary in accordance with OSHA standards.
- Backfill materials shall be approved by the engineer where the pipe is undercut.
- Water, sewer, and reuse mains to be installed with a minimum 36 inches of cover.
- For County R/W, refer to land development regulations for roadway replacement, pavement overlay and density requirements.
- For state R/W, refer to F.D.O.T regulations for roadway replacement, pavement overlay and density requirements.

Sanitary Service General Notes


- Location of clean-out to be marked at curb or edge of asphalt with brass disc with number of feet. Refer to the general section 6.15.1 for specification on disc in uniform water, wastewater and reuse system code.
- The wastewater service lateral shall not be deeper than 5 feet from finished (final) grade, top back of curb, or edge of pavement.
- Wastewater service lateral cleanouts shall have a poured in place concrete pad. See detail S-4

PRIVATE SLEEVING LEGEND


- 2" DENOTES SLEEVE SIZE TYPE
DENOTES SLEEVE LOCATION
- 2" IRRIGATION
2" LIGHTING
2" TELECOMMUNICATION
2" GATE SYSTEM
2" ADDITIONAL SLEEVE

PRIVATE SLEEVING NOTES

- ALL SLEEVING TO BE SCHEDULE 40 PVC.
- THE TOP OF ANY SLEEVE SHALL BE BETWEEN 24" AND 42" BELOW THE BACK OF CURB.
- WHERE SEVERAL SLEEVES ARE REQUIRED, MAINTAIN 6" HORIZONTAL SEPARATION BETWEEN EACH SLEEVE. DO NOT STACK ONE ON TOP OF ANOTHER.
- ALL SLEEVES SHALL BE 2" DIAMETER MINIMUM UNLESS OTHERWISE NOTED.
- LOCATE ALL SLEEVES WITH PVC ELBOWS ABOVE GRADE. WHEN THERE ARE MULTIPLE SLEEVES ONLY (1) 2" SLEEVE NEEDS TO BE ELBOWED. STAKE WITH A 2x4 AND MARK WITH PAINT.
- CURBS AT AREA OF CROSSING TO BE MARKED USING CONCRETE SAW TO CREATE A TRIANGLE PATTERN ON THE TOP OF CURB.
- ALL SLEEVES SHALL EXTEND 24" MINIMUM BEYOND ALL CURBS OR WALKS.
- ADDITIONAL SLEEVING MAY BE REQUIRED FOR ADDITIONAL UTILITIES. SITE CONTRACTOR TO COORDINATE ADDITIONAL SLEEVING ONSITE.
- THE END OF ALL SLEEVES SHALL BE SEALED WITH DUCT TAPE.
- FIELD LOCATE SLEEVES TO ENSURE THEY DO NOT LINE UP WITH SIDEWALKS OR OTHER PROPOSED HARDSCAPE ELEMENTS. NOR IMPEDE OR CAUSE CONFLICT WITH ANY ACCESSWAY, VEHICULAR OR PEDESTRIAN CIRCULATION OR UTILITY SERVICE.

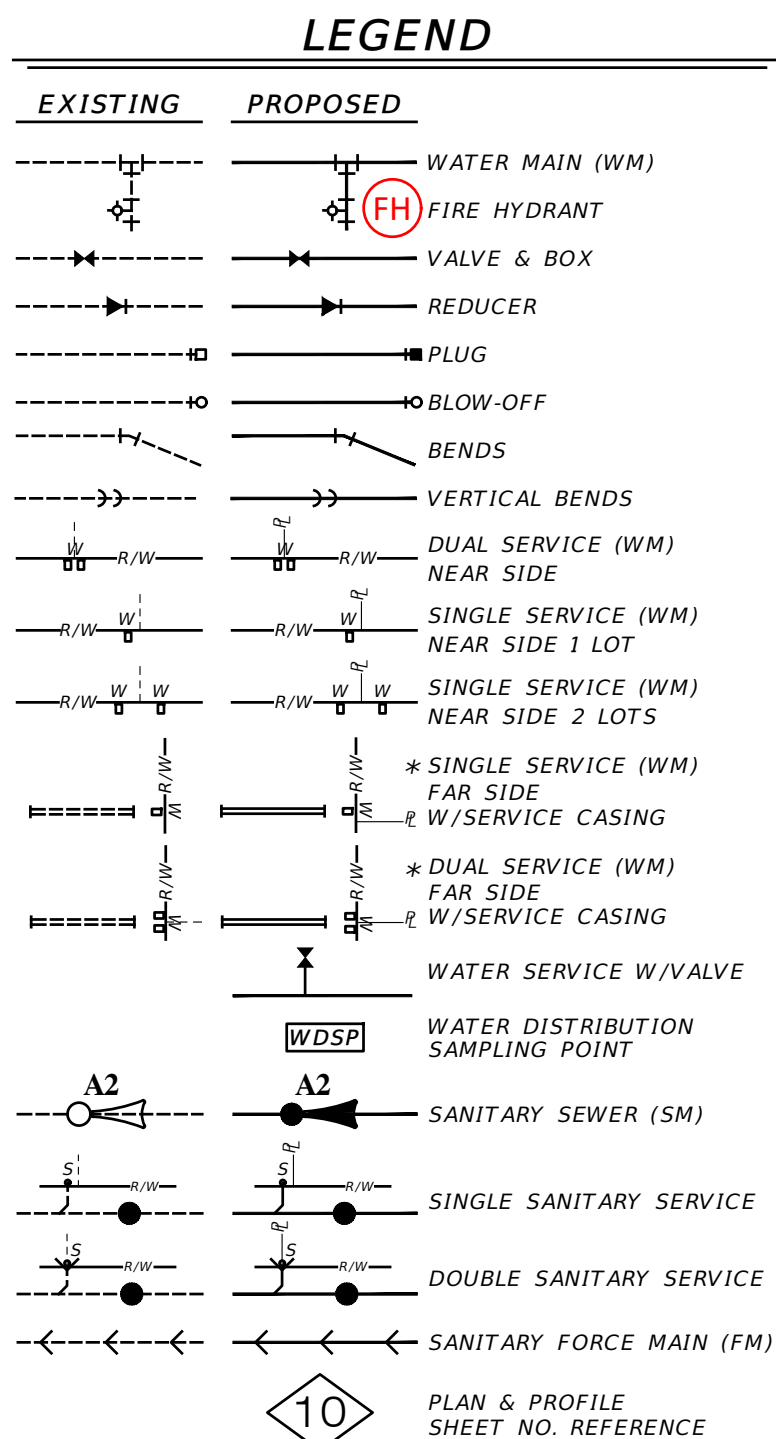

05-17-2021	INITIAL SUBMITTAL	JAS
DATE	DESCRIPTION	BY
REVISIONS		

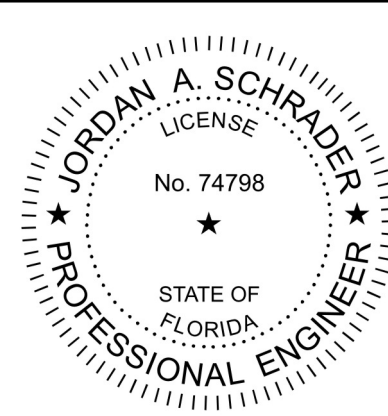


Clearview
LAND DESIGN, P.L.
Engineering Business C.A. No.: 28898
3010 W Azalea St., Suite 150, Tampa, Florida 33609
Office: 813-223-3919 Fax: 813-223-3975

This item has been digitally signed and sealed by JORDAN A. SCHRADER, P.E. on the date adjacent to the signature. This document are not considered signed and sealed and the signature must be verified on any electronic copies.


DATE: 06/03/2025
JORDAN A. SCHRADER, P.E. NO. 74798
FLORIDA PROFESSIONAL ENGINEER

WATER & SEWER NOTES

JOB NO. JEN-RU-008	RUSTIC ROAD NORTH PHASES 1 & 2	
DESIGN FERREIRA	JEN TAMPA 1, LLC.	
DRAWN DUNCAN	PREPARED FOR:	C/O BANYAN LAND CAPITAL, LLC.
DATE 06-03-2025	Elevations based on North American Vertical Datum 1988 (NAVD 88) Conversion from NAVD 88 to NGVD 29 = +1.11 Feet	
FILE WSNOTES	SHEET 28 OF 71 SHEETS	

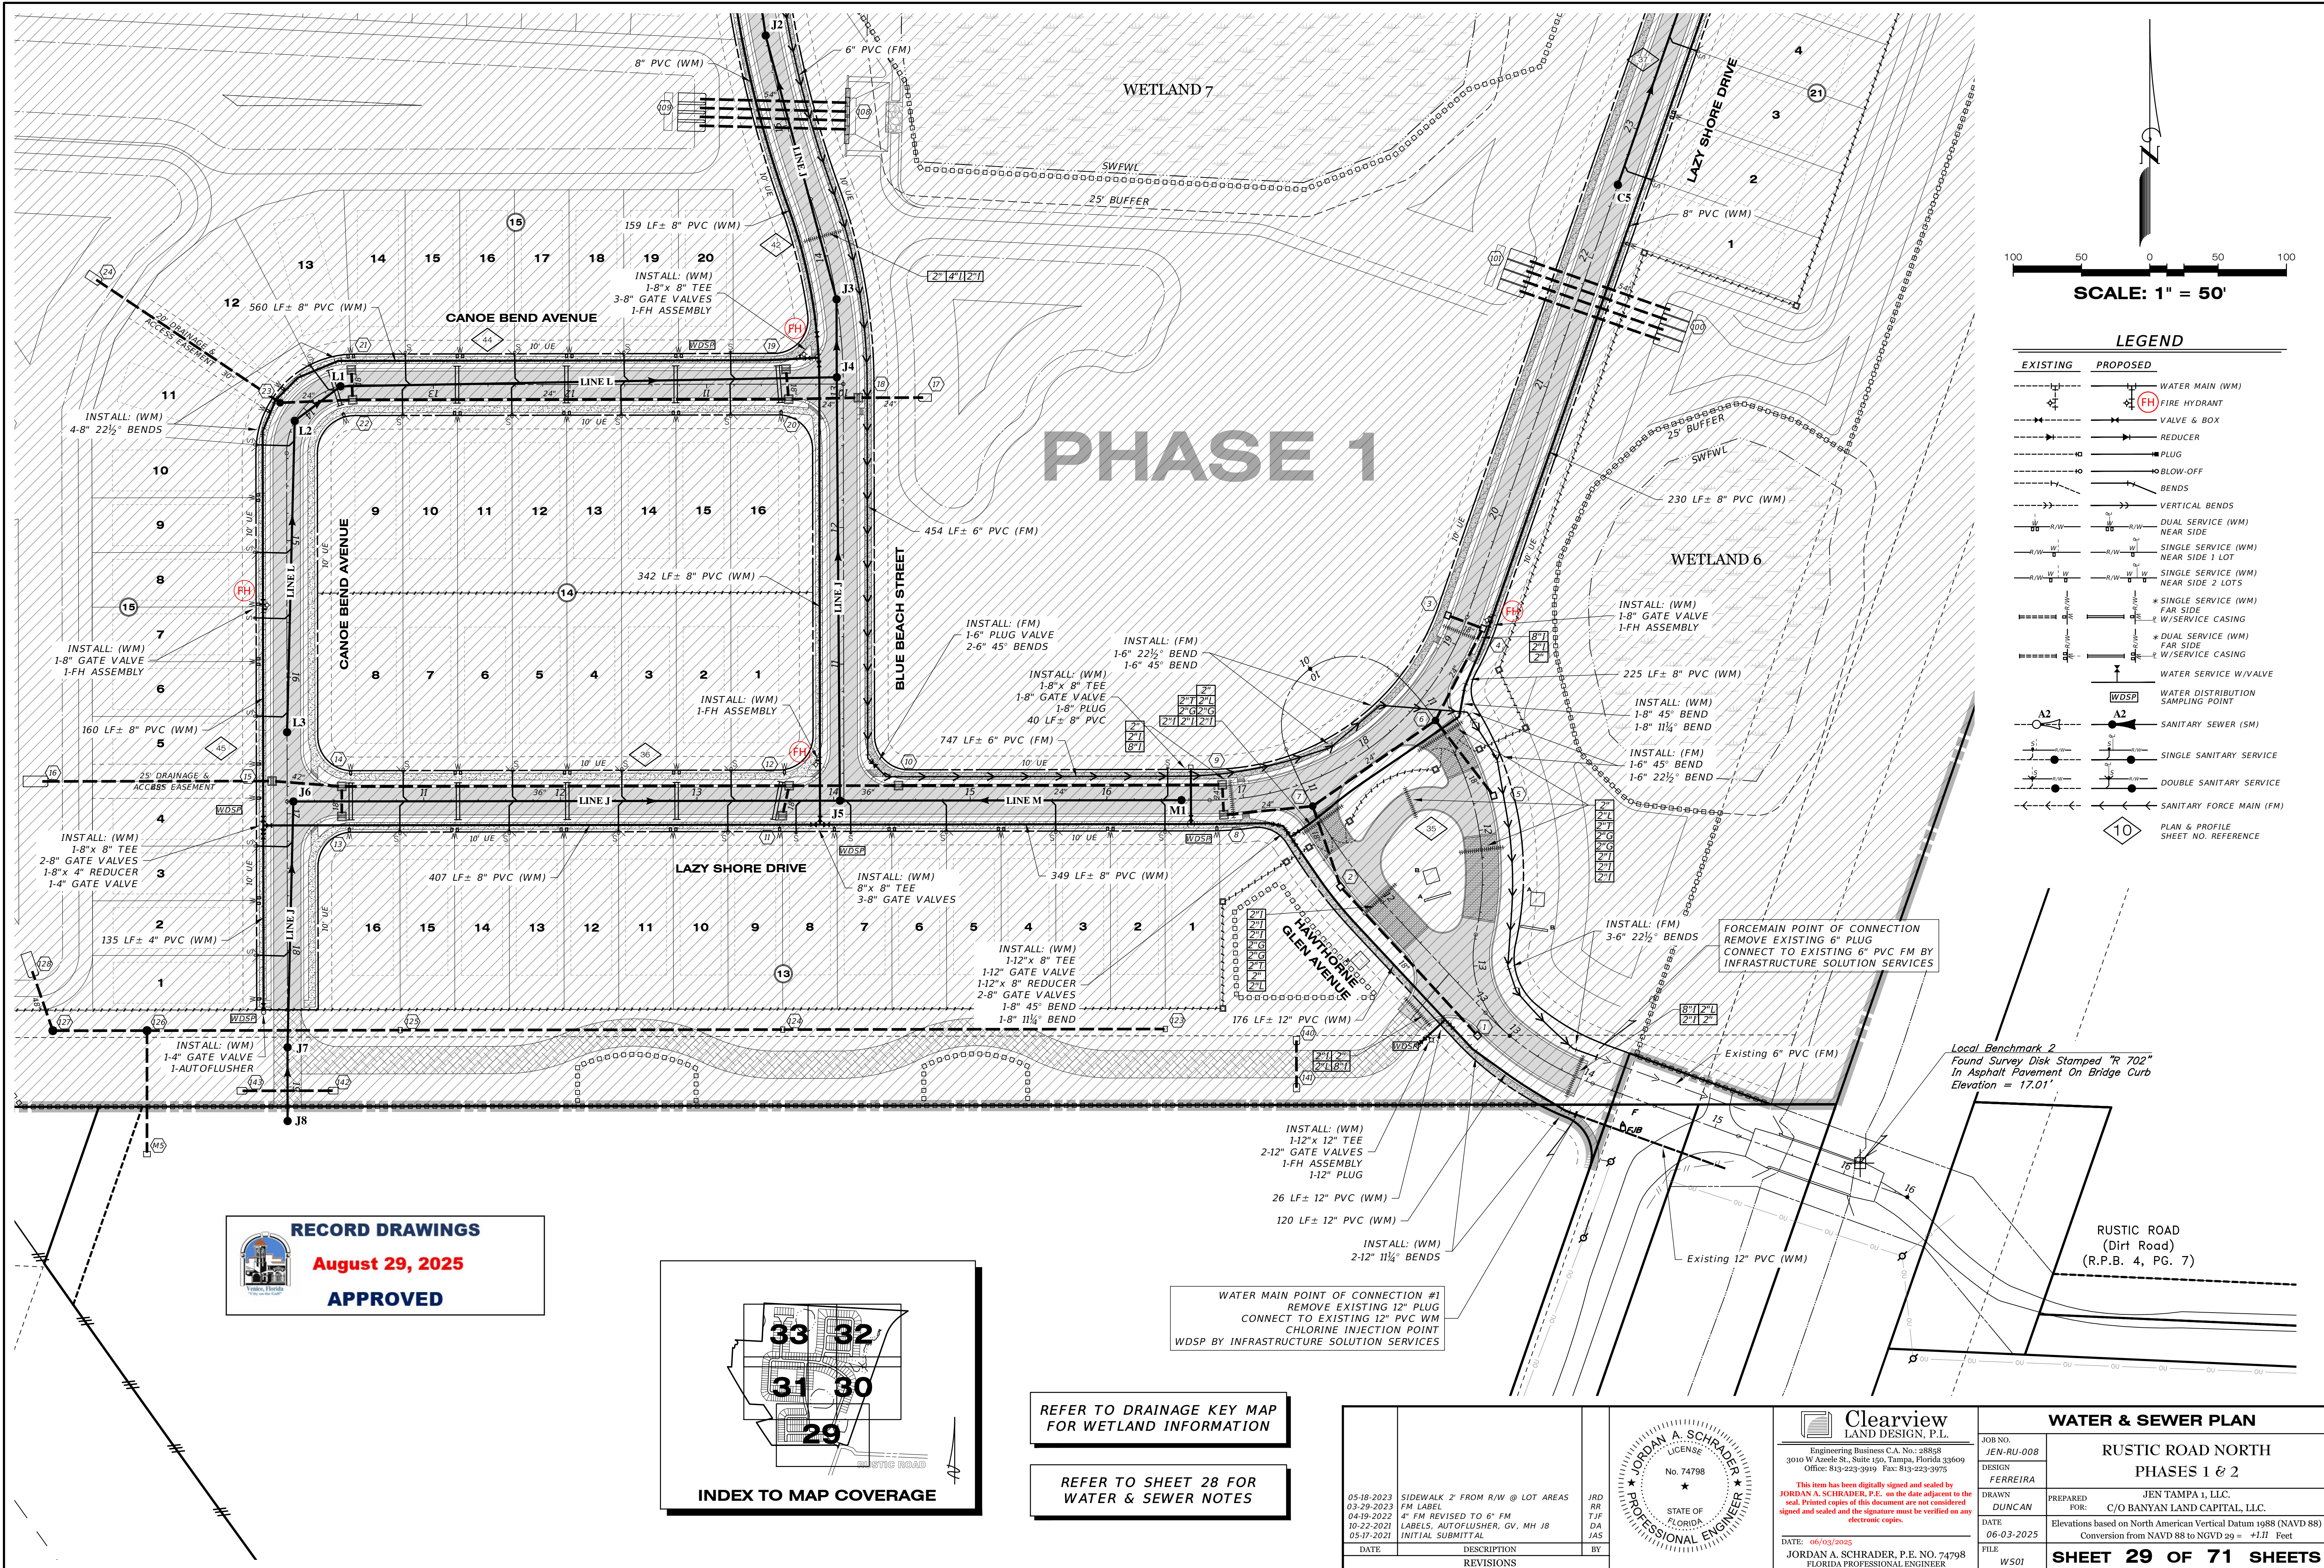



RECORD DRAWINGS
August 29, 2025
APPROVED

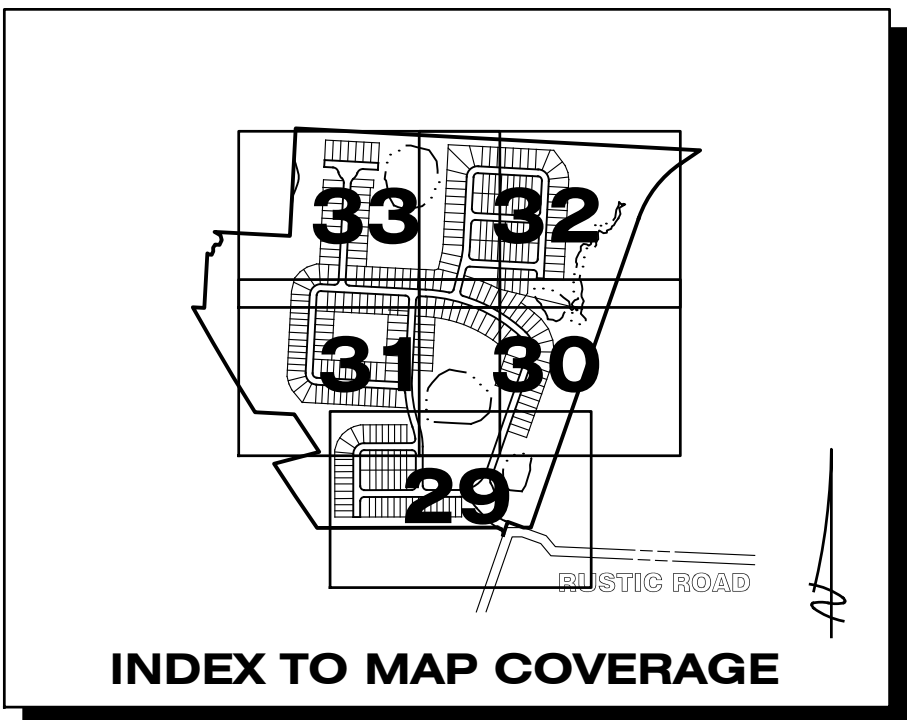


REFER TO DRAINAGE KEY MAP
FOR WETLAND INFORMATION

REFER TO SHEET 28 FOR
WATER & SEWER NOTES

05-18-2023 SIDEWALK 2' FROM R/W @ LOT AREAS JRD 03-29-2023 FM LABEL RR 04-19-2023 4" FM REVISED TO 6" FM TJF 10-22-2021 LABELS, AUTOFLUSHER, GV, MH J8 DA 05-17-2021 INITIAL SUBMITTAL JAS		JORDAN A. SCHRADER LICENSE No. 74798 STATE OF FLORIDA PROFESSIONAL ENGINEER		Clearview LAND DESIGN, P.L. Engineering Business C.A. No.: 88858 3010 W Azalea St., Suite 150, Tampa, Florida 33609 Office: 813-223-3919 Fax: 813-223-3975		WATER & SEWER PLAN	
05-18-2023 This item has been digitally signed and sealed by JORDAN A. SCHRADER, P.E. on the date adjacent to the seal. Printed copies of this document are not considered signed and sealed and the signature must be verified on any electronic copies.		DATE: 06/03/2025 JORDAN A. SCHRADER, P.E. NO. 74798 FLORIDA PROFESSIONAL ENGINEER		JOB NO. JEN-RU-008 DESIGN FERREIRA DRAWN DUNCAN DATE 06-03-2025 FILE WS01		RUSTIC ROAD NORTH PHASES 1 & 2	
				PREPARED FOR: JEN TAMPA 1, LLC. C/O BANYAN LAND CAPITAL, LLC. Elevations based on North American Vertical Datum 1988 (NAVD 88) Conversion from NAVD 88 to NGVD 29 = +1.11 Feet		SHEET 29 OF 71 SHEETS	

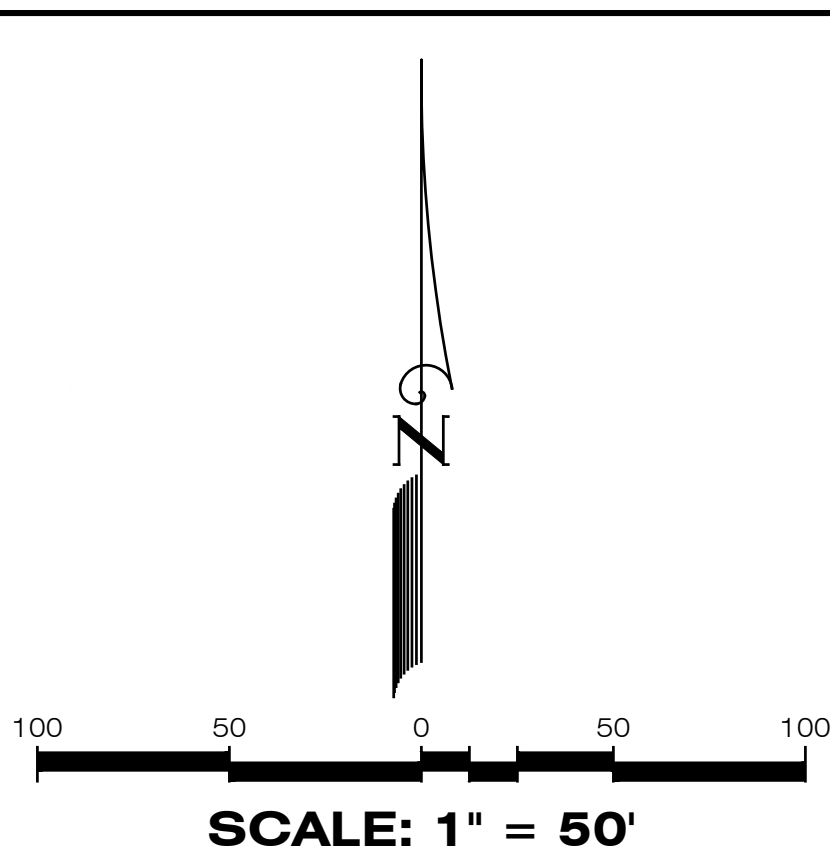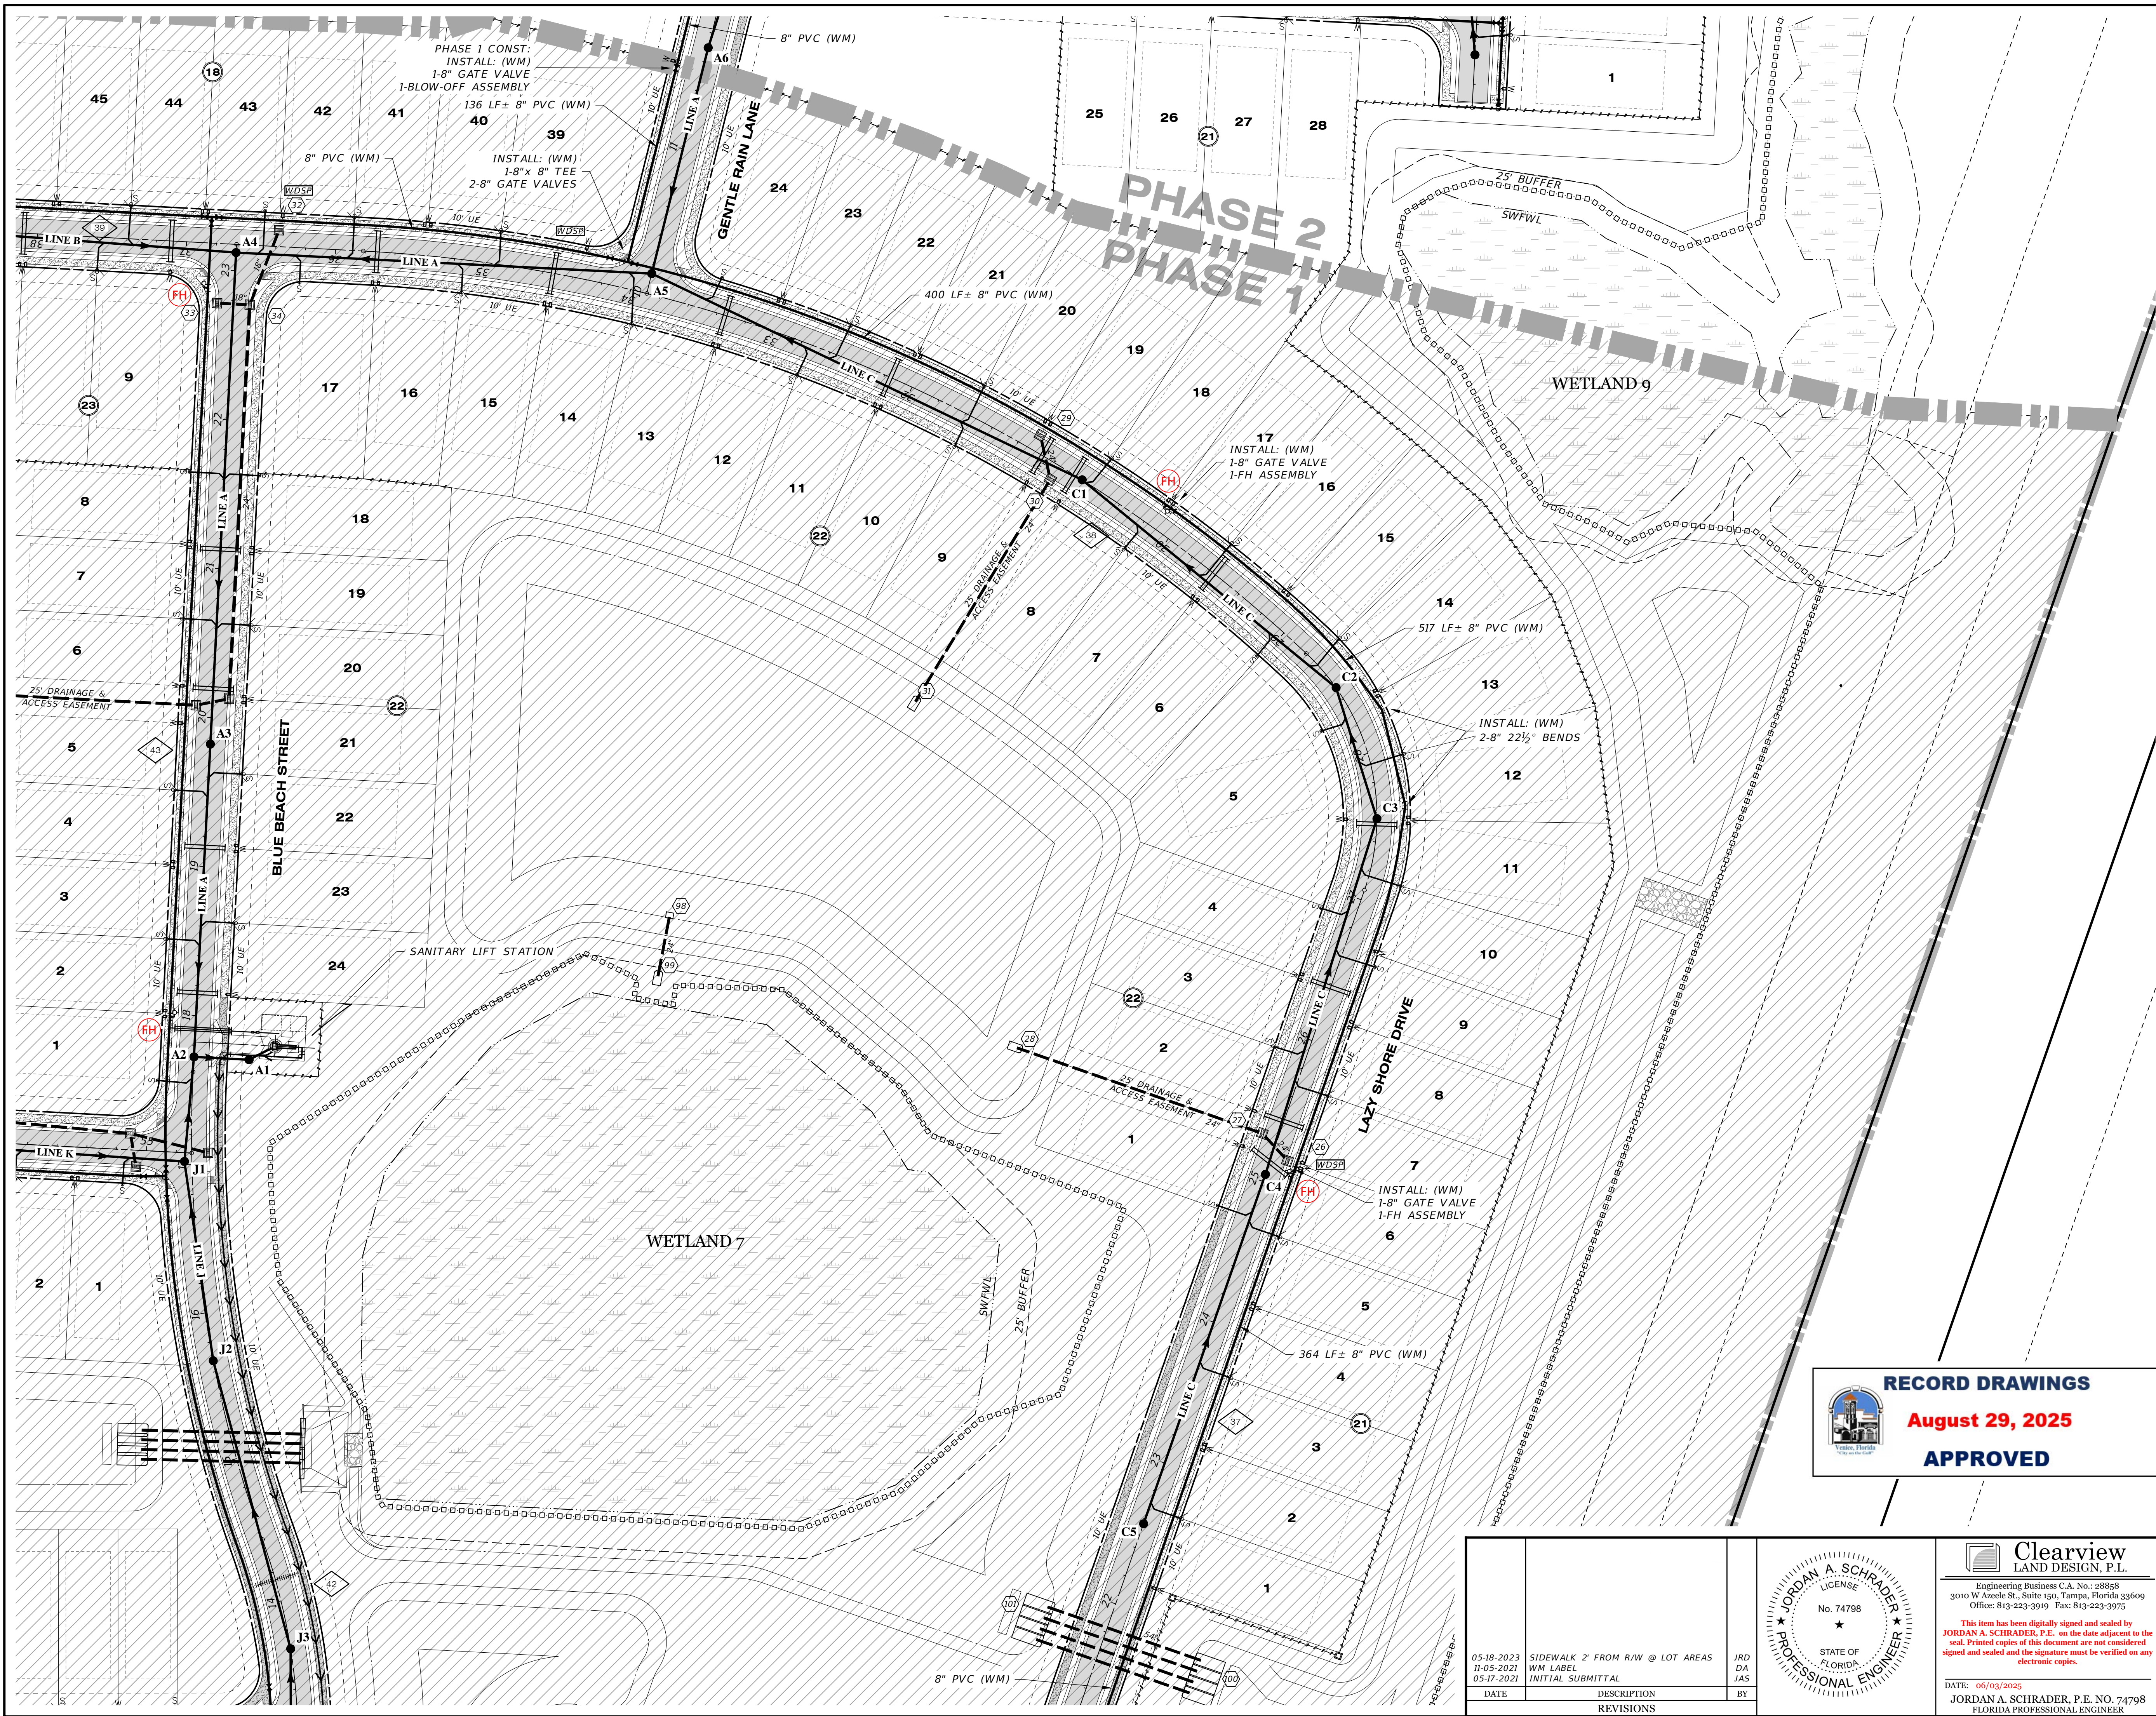

LEGEND	
EXISTING	PROPOSED


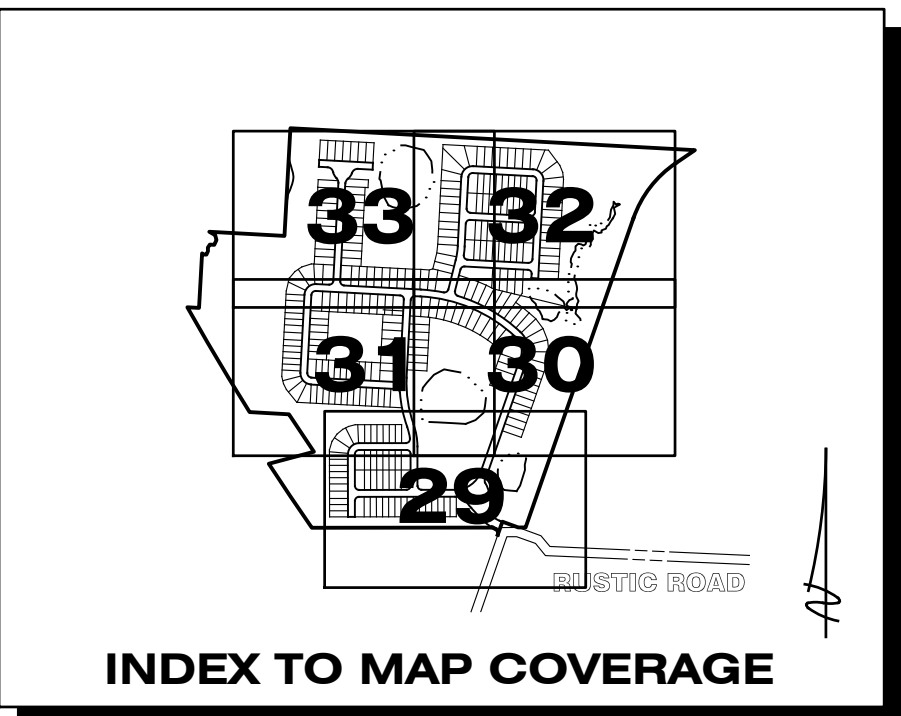


RECORD DRAWINGS
August 29, 2025
APPROVED

REFER TO DRAINAGE KEY MAP
FOR WETLAND INFORMATION


REFER TO SHEET 28 FOR
WATER & SEWER NOTES

05-18-2023 01-05-2021 05-17-2021 DATE DESCRIPTION REVISIONS JRD DA JAS BY			JORDAN A. SCHRADER LICENSE No. 74798 STATE OF FLORIDA PROFESSIONAL ENGINEER		Clearview LAND DESIGN, P.L. Engineering Business C.A. No.: 28858 3010 W Azule St., Suite 150, Tampa, Florida 33609 Office: 813-223-3919 Fax: 813-223-3975 This item has been digitally signed and sealed by JORDAN A. SCHRADER, P.E. on the date adjacent to the seal. Printed copies of this document are not considered signed and sealed and the signature must be verified on any electronic copies. DATE: 06/03/2025 JORDAN A. SCHRADER, P.E. NO. 74798 FLORIDA PROFESSIONAL ENGINEER		WATER & SEWER PLAN JEN-TU-008 DESIGN FERREIRA DRAWN DUNCAN DATE 06-03-2025 FILE WS02 RUSTIC ROAD NORTH PHASES 1 & 2 JEN TAMPA 1, LLC. FOR: C/O BANYAN LAND CAPITAL, LLC. Elevations based on North American Vertical Datum 1988 (NAVD 88) Conversion from NAVD 88 to NGVD 29 = +1.11 Feet SHEET 30 OF 71 SHEETS
---	--	--	--	--	--	--	--

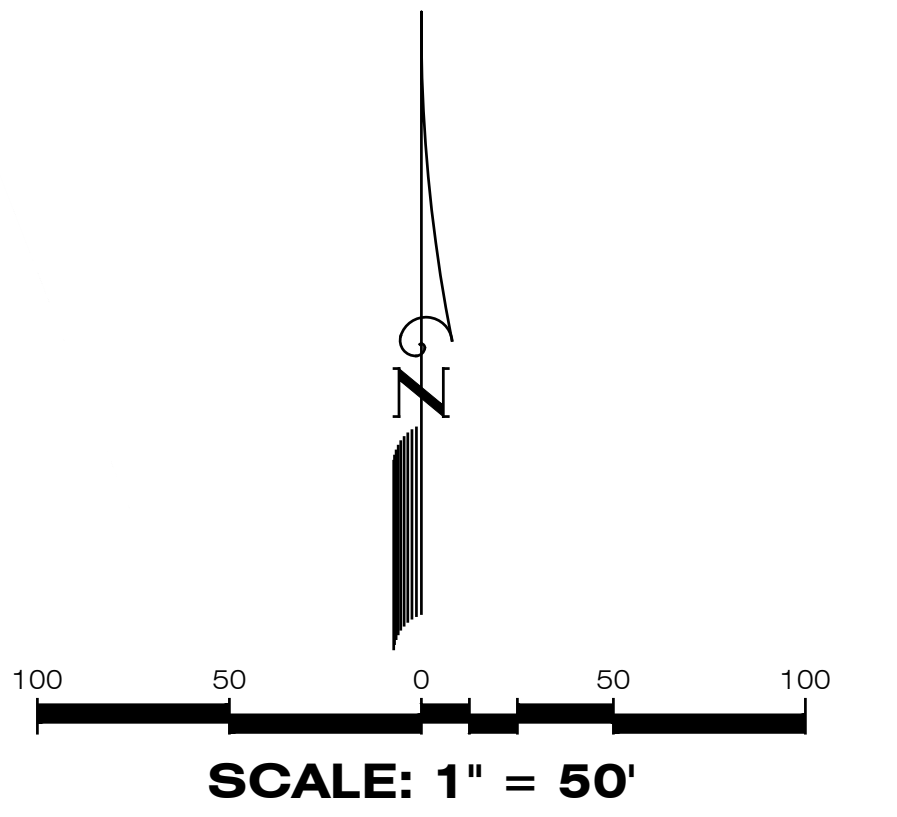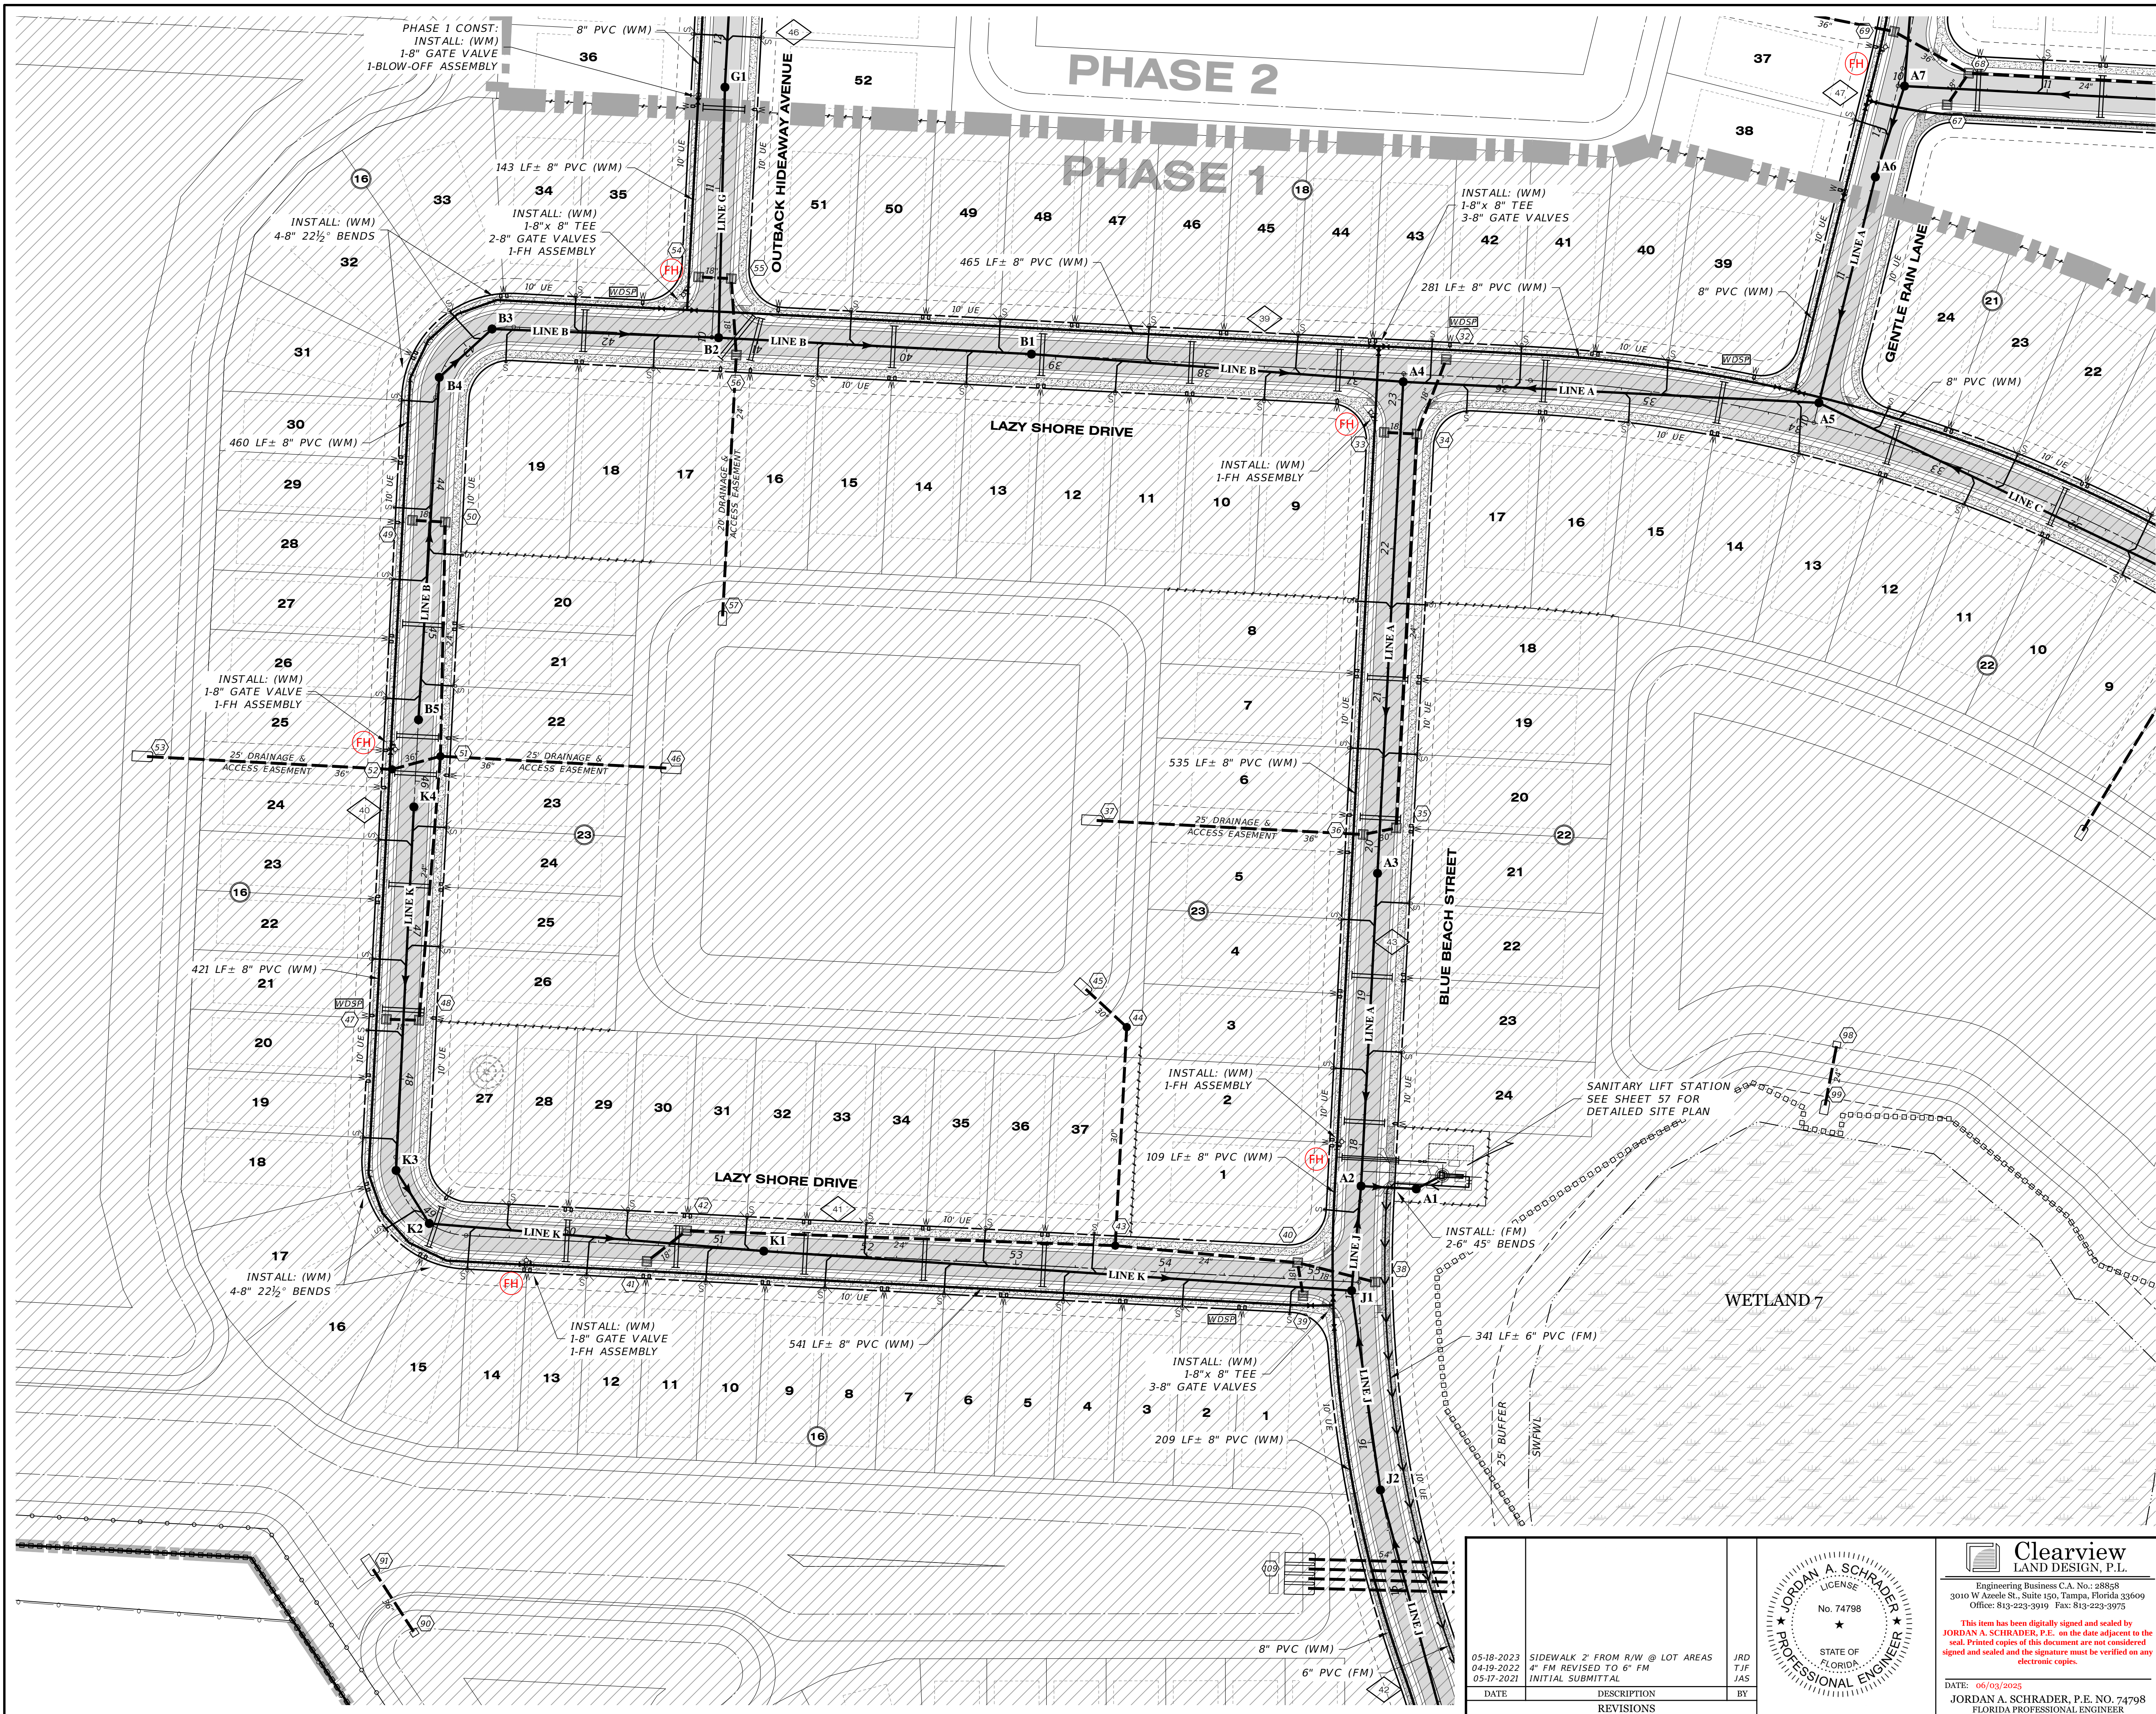

LEGEND	
EXISTING	PROPOSED

RECORD DRAWINGS
August 29, 2025
APPROVED

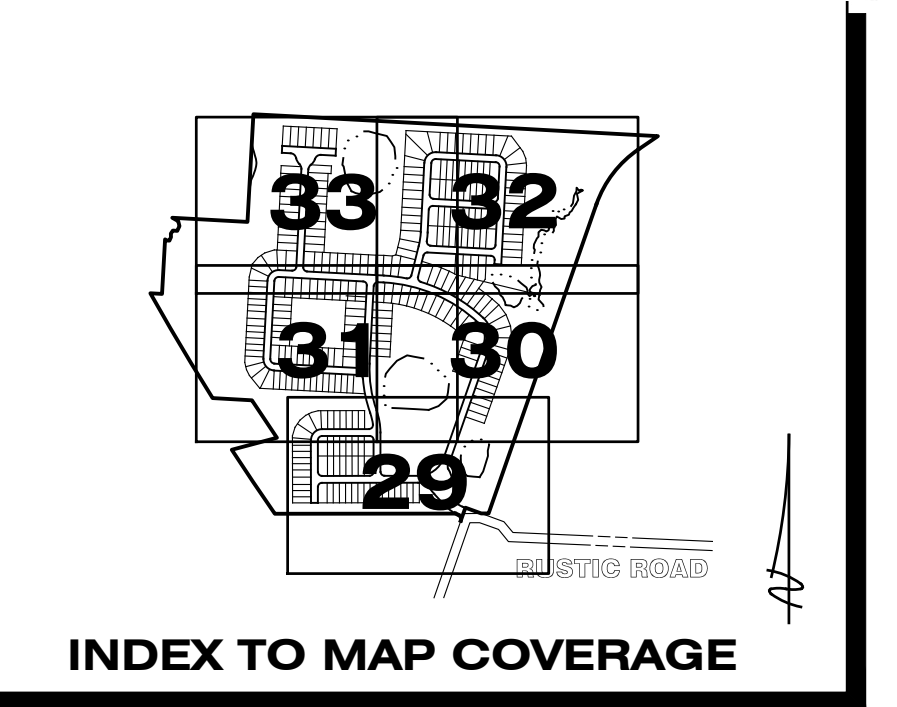

REFER TO DRAINAGE KEY MAP
FOR WETLAND INFORMATION

REFER TO SHEET 28 FOR
WATER & SEWER NOTES

WATER & SEWER PLAN	
RUSTIC ROAD NORTH PHASES 1 & 2	
JOB NO. JEN-RU-008	PREPARED FOR: JEN TAMPA 1, LLC.
DESIGN FERREIRA	FOR: C/O BANYAN LAND CAPITAL, LLC.
DRAWN DUNCAN	Elevations based on North American Vertical Datum 1988 (NAVD 88)
DATE 06-03-2025	Conversion from NAVD 88 to NGVD 29 = +1.11 Feet
FILE WS03	SHEET 31 OF 71 SHEETS

05-18-2023
04-19-2023
05-17-2021

SIDEWALK 2' FROM R/W @ LOT AREAS
4" FM REVISED TO 6" FM
INITIAL SUBMITTAL

JRD
TJF
JAS



BY

JORDAN A. SCHRADER
LICENSE
No. 74798
STATE OF
FLORIDA
PROFESSIONAL ENGINEER

Clearview
LAND DESIGN, P.L.
Engineering Business C.A. No.: 28898
3010 W Azalea St., Suite 150, Tampa, Florida 33609
Office: 813-223-3919 Fax: 813-223-3975

This item has been digitally signed and sealed by
JORDAN A. SCHRADER, P.E. on the date adjacent to the
seal. Printed copies of this document are not considered
signed and sealed and the signature must be verified on any
electronic copies.

DATE: 06/03/2025
JORDAN A. SCHRADER, P.E. NO. 74798
FLORIDA PROFESSIONAL ENGINEER

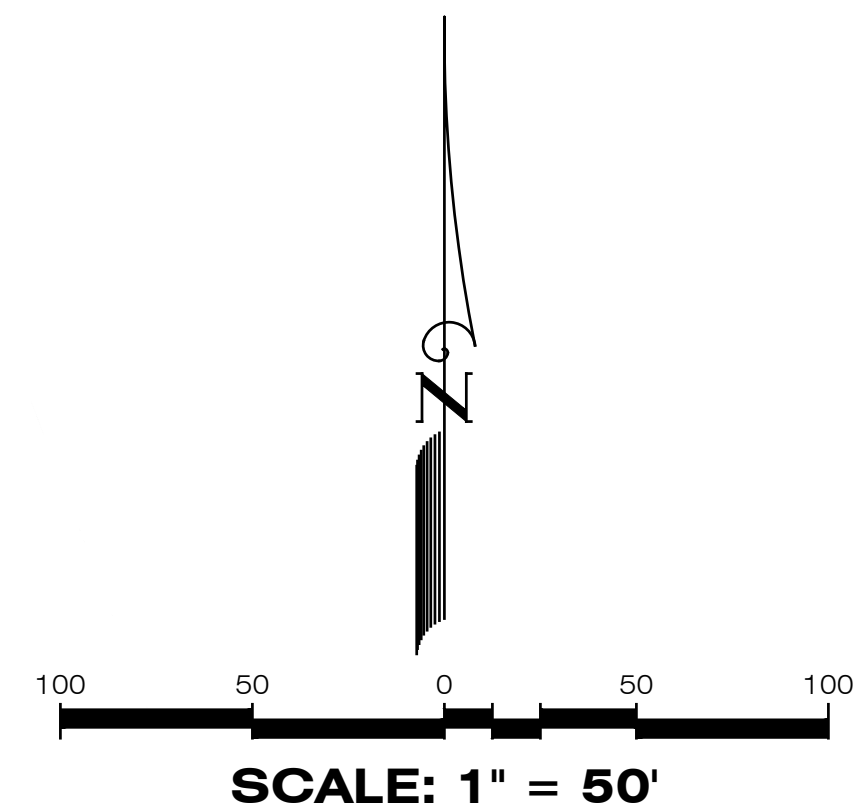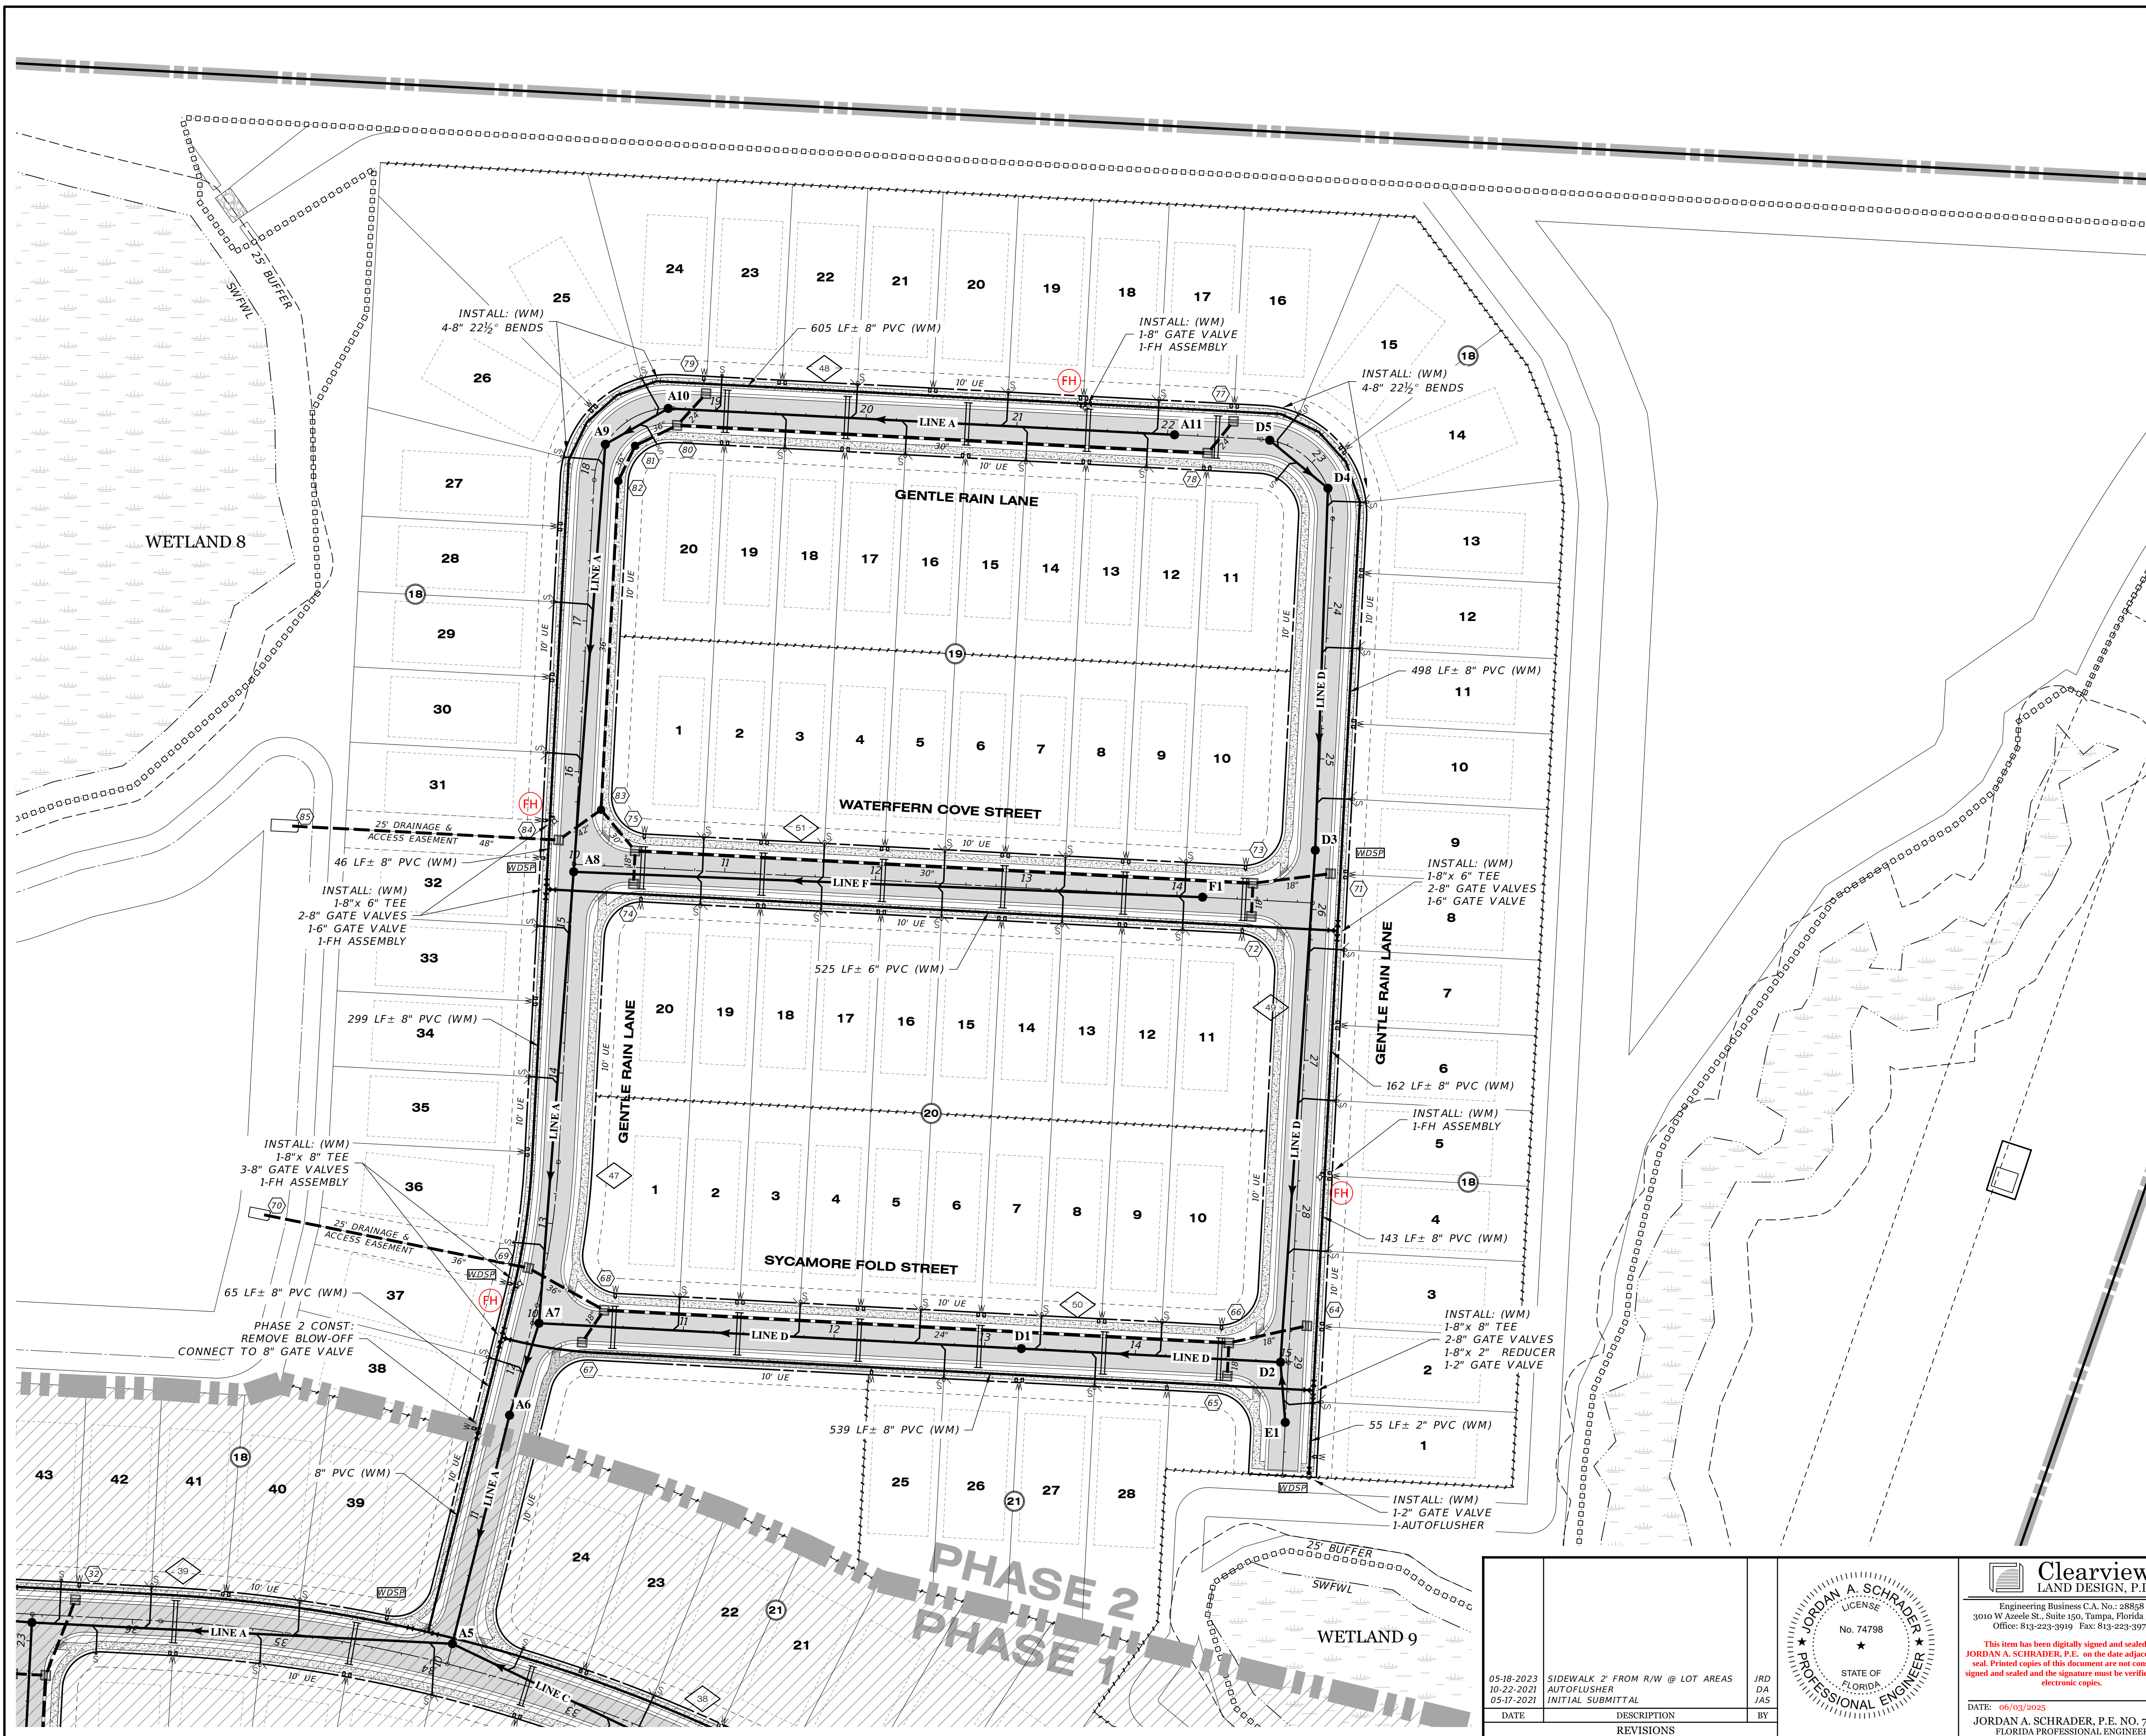

LEGEND	
EXISTING	PROPOSED

RECORD DRAWINGS
August 29, 2025
APPROVED

INDEX TO MAP COVERAGE

REFER TO DRAINAGE KEY MAP
FOR WETLAND INFORMATION

REFER TO SHEET 28 FOR
WATER & SEWER NOTES

WATER & SEWER PLAN		
RUSTIC ROAD NORTH PHASES 1 & 2		
JOB NO. JEN-RU-008	JEN TAMPA 1, LLC.	
DESIGN FERREIRA	FOR: C/O BANYAN LAND CAPITAL, LLC.	
DRAWN DUNCAN	Elevations based on North American Vertical Datum 1988 (NAVD 88)	
DATE 06-03-2025	Conversion from NAVD 88 to NGVD 29 = +1.11 Feet	
FILE WS04	SHEET 32 OF 71 SHEETS	

05-18-2023
10-22-2023
05-17-2021

SIDEWALK 2' FROM R/W @ LOT AREAS
AUTOFLOUSER
INITIAL SUBMITTAL

DATE

JRD
DA
JAS

BY


REVISIONS

JORDAN A. SCHRADER, P.E.
FLORIDA PROFESSIONAL ENGINEER

Engineering Business C.A. No.: 28898
3010 W. Azalea St., Suite 150, Tampa, Florida 33609
Office: 813-223-3919 Fax: 813-223-3975

This item has been digitally signed and sealed by JORDAN A. SCHRADER, P.E. on the date adjacent to the seal. Printed copies of this document are not considered signed and sealed and the signature must be verified on any electronic copies.

DATE: 06/03/2025
JORDAN A. SCHRADER, P.E. NO. 74798
FLORIDA PROFESSIONAL ENGINEER

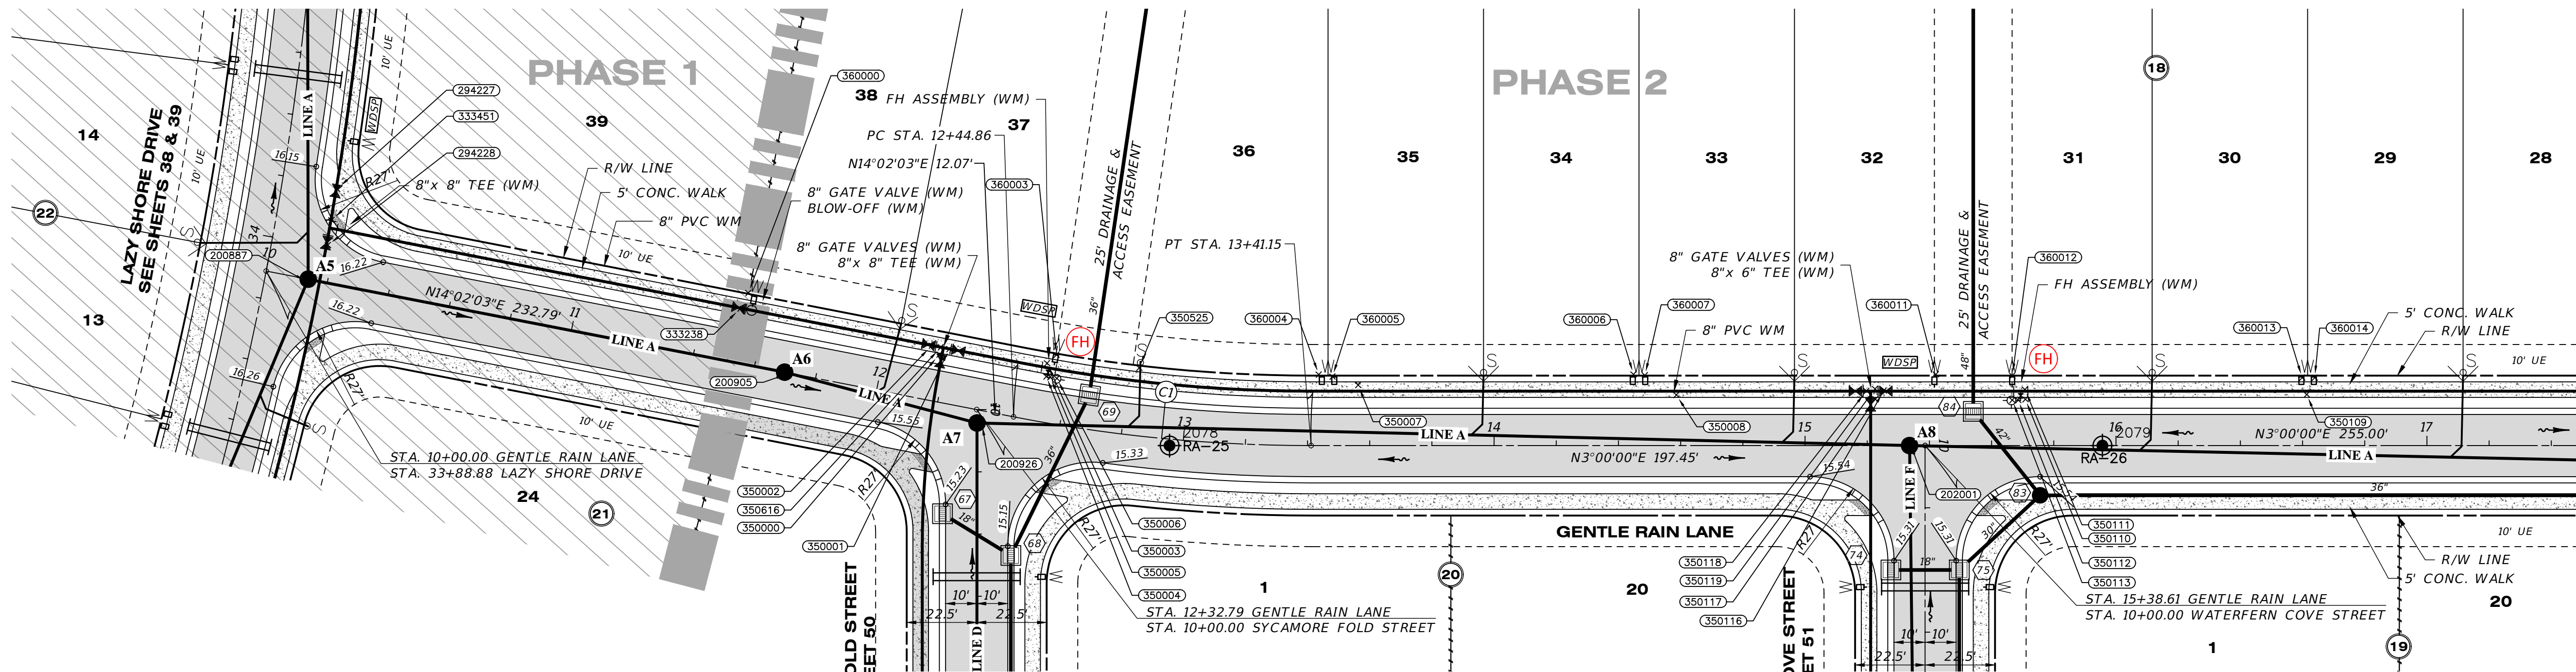

Curve Table: Alignments										
Curve #	Radius	Length	Chord	Delta	Tan	Deg (Arc)	PC Sta.	PT Sta.	PI Sta.	
C1	500.00'	96.29'	N08°31'01"E 96.14'	11°02'03"	48.29'	11°27'33"	12+44.86	13+41.15	12+93.16	

SWING TIE TABLE										
LOCATION 1			LOCATION 2							
POINT - #	DESCRIPTION	ELEVATION	POINT - #	DESCRIPTION	ELEVATION					
294227	WATER MAIN GATE VALVE 8"	13.765	350000	WATER MAIN GATE VALVE 8"	13.765					
333451	WATER MAIN GATE VALVE 8"	13.46	350003	WATER MAIN GATE VALVE 8"	13.46					
294228	WATER MAIN GATE VALVE 8"	13.382	350004	WATER MAIN GATE VALVE 8"	13.382					
333238	WATER MAIN GATE VALVE 8"	14.5	350005	WATER MAIN GATE VALVE 8"	14.5					
350002	WATER MAIN GATE VALVE 8"	14.143	350006	WATER MAIN GATE VALVE 8"	14.143					
350016	WATER MAIN GATE VALVE 8"	14.11	350007	WATER MAIN GATE VALVE 8"	14.11					
350000	WATER MAIN GATE VALVE 8"	14.019	350008	WATER MAIN GATE VALVE 8"	14.019					
350001	WATER MAIN GATE VALVE 8"	14.075	350009	WATER MAIN GATE VALVE 8"	14.075					
350003	WATER MAIN GATE VALVE 8"	12.154	350010	WATER MAIN GATE VALVE 8"	12.154					
350004	WATER MAIN GATE VALVE 8"	11.983	350011	WATER MAIN GATE VALVE 8"	11.983					
350010	WATER MAIN GATE VALVE 8"	11.332	350022	WATER MAIN GATE VALVE 8"	11.332					
350013	WATER MAIN GATE VALVE 8"	18.328	350023	WATER MAIN GATE VALVE 8"	18.328					
350019	WATER MAIN GATE VALVE 8"	14.074	350024	WATER MAIN GATE VALVE 8"	14.074					

SWING TIE TABLE										
LOCATION 1			LOCATION 2							
POINT - #	DESCRIPTION	ELEVATION	POINT - #	DESCRIPTION	ELEVATION					
360000	WATER SINGLE SERVICE	16.111	360000	WATER SINGLE SERVICE	16.111					
360003	WATER SINGLE SERVICE	15.235	360001	WATER SINGLE SERVICE	15.235					
360004	WATER SINGLE SERVICE	16.287	360002	WATER SINGLE SERVICE	16.287					
360005	WATER SINGLE SERVICE	16.079	360003	WATER SINGLE SERVICE	16.079					
360006	WATER SINGLE SERVICE	15.926	360004	WATER SINGLE SERVICE	15.926					
360007	WATER SINGLE SERVICE	15.804	360005	WATER SINGLE SERVICE	15.804					
360011	WATER SINGLE SERVICE	15.865	360006	WATER SINGLE SERVICE	15.865					
360012	WATER SINGLE SERVICE	15.648	360007	WATER SINGLE SERVICE	15.648					
360013	WATER SINGLE SERVICE	16.207	360008	WATER SINGLE SERVICE	16.207					
360014	WATER SINGLE SERVICE	16.479	360009	WATER SINGLE SERVICE	16.479					

RECORD DATA PROVIDED BY GEOPOINT SURVEYING, INC.

RECORD DRAWING LEGEND	
42.00	PROPOSED/DESIGN ELEVATION OR DIMENSION LINED THROUGH.
42.07	"RECORD" ELEVATION OR DIMENSION WRITTEN IN.
54.8	INDICATES RECORD ELEVATION
✓	INDICATES "RECORD" ELEVATION, DIMENSION, SLOPE, et cetera.
10000	INDICATES "RECORD" ITEM NUMBER


RECORD DRAWING SURVEYORS CERTIFICATION

I HEREBY CERTIFY THAT THE RECORD LOCATIONS AND ELEVATIONS DEPICTED ON THESE RECORD DRAWINGS ARE TRUE AND CORRECT AND WERE COLLECTED IN THE FIELD BY THE SURVEYOR AND MAPPER OR A REPRESENTATIVE UNDER THE DIRECT SUPERVISION OF THE SURVEYOR AND MAPPER.

DATE OF LAST FIELD SURVEY 05/30/2025

JUSTIN O. BRANTLEY, P.S.M.
FLORIDA CERTIFICATE NO. 158837

SCALE: 1" = 30' HORIZONTAL
1" = 3' VERTICAL

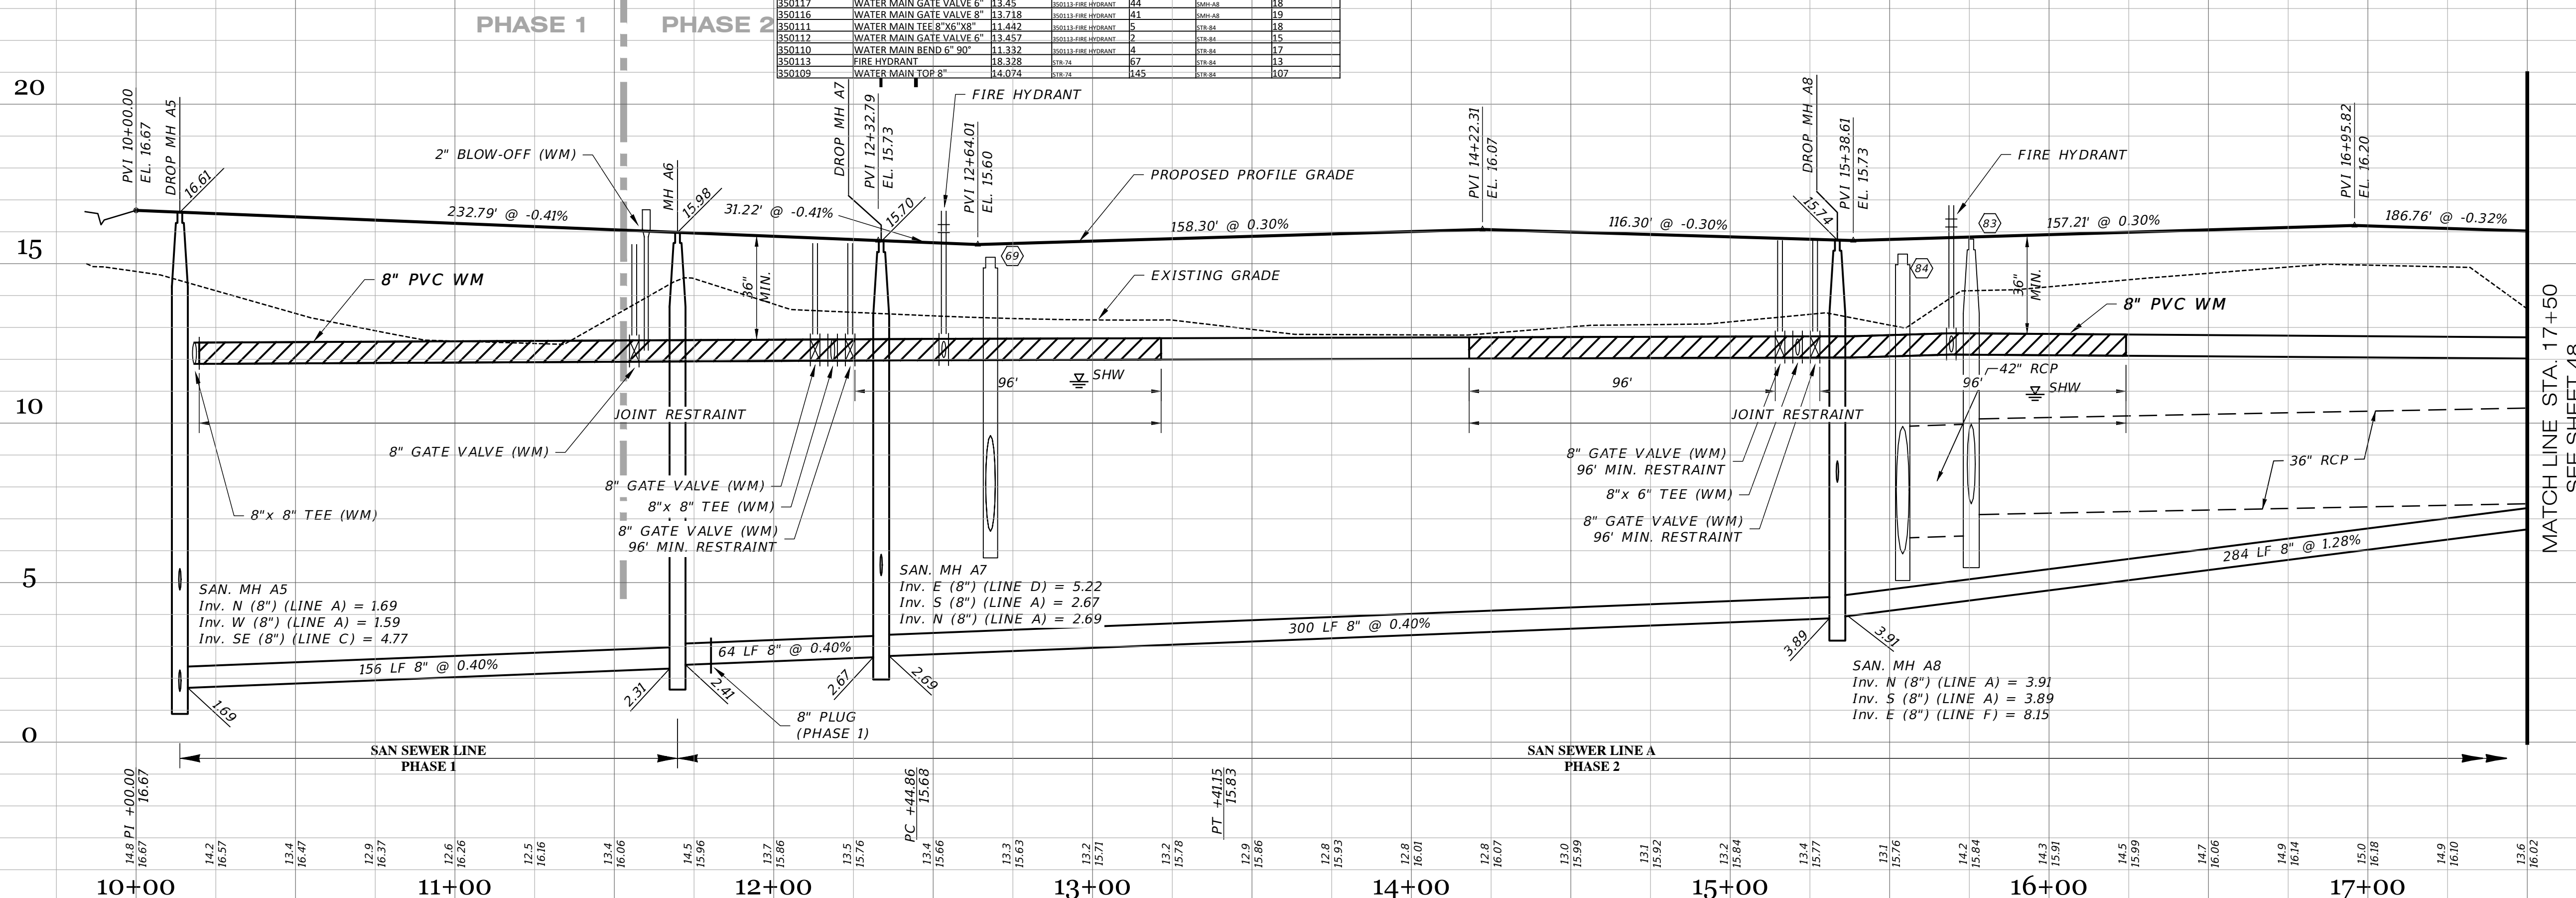


06-03-2025 04-25-2024 05-18-2023 10-22-2021 05-17-2021		UTIL RECORD DATA BY GEOPOINT REMOVED EXTRA MHS SIDEWALK 2' FROM R/W @ LOT AREAS REST. JOINTS, REMOVED GV INITIAL SUBMITTAL		JRD MMR JRD DA JAS
DATE	DESCRIPTION	BY		
	REVISIONS			

JORDAN A. SCHRADER
LICENSE
No. 74798
STATE OF FLORIDA
PROFESSIONAL ENGINEER

Clearview
LAND DESIGN, P.L.
Engineering Business C.A. No.: 28898
3010 W Azalea St., Suite 150, Tampa, Florida 33609
Office: 813-223-3919 Fax: 813-223-3975

ROADWAY & UTILITY PLAN & PROFILE	
JOB NO. JEN-RU-008	RUSTIC ROAD NORTH PHASES 1 & 2
DESIGN FERREIRA	
DRAWN DUNCAN	JEN TAMPA 1, LLC. FOR: C/O BANYAN LAND CAPITAL, LLC.
DATE 06-03-2025	
FILE RP14	Elevations based on North American Vertical Datum 1988 (NAVD 88) Conversion from NAVD 88 to NGVD 29 = +1.1 Feet

SHEET 47 OF 71 SHEETS

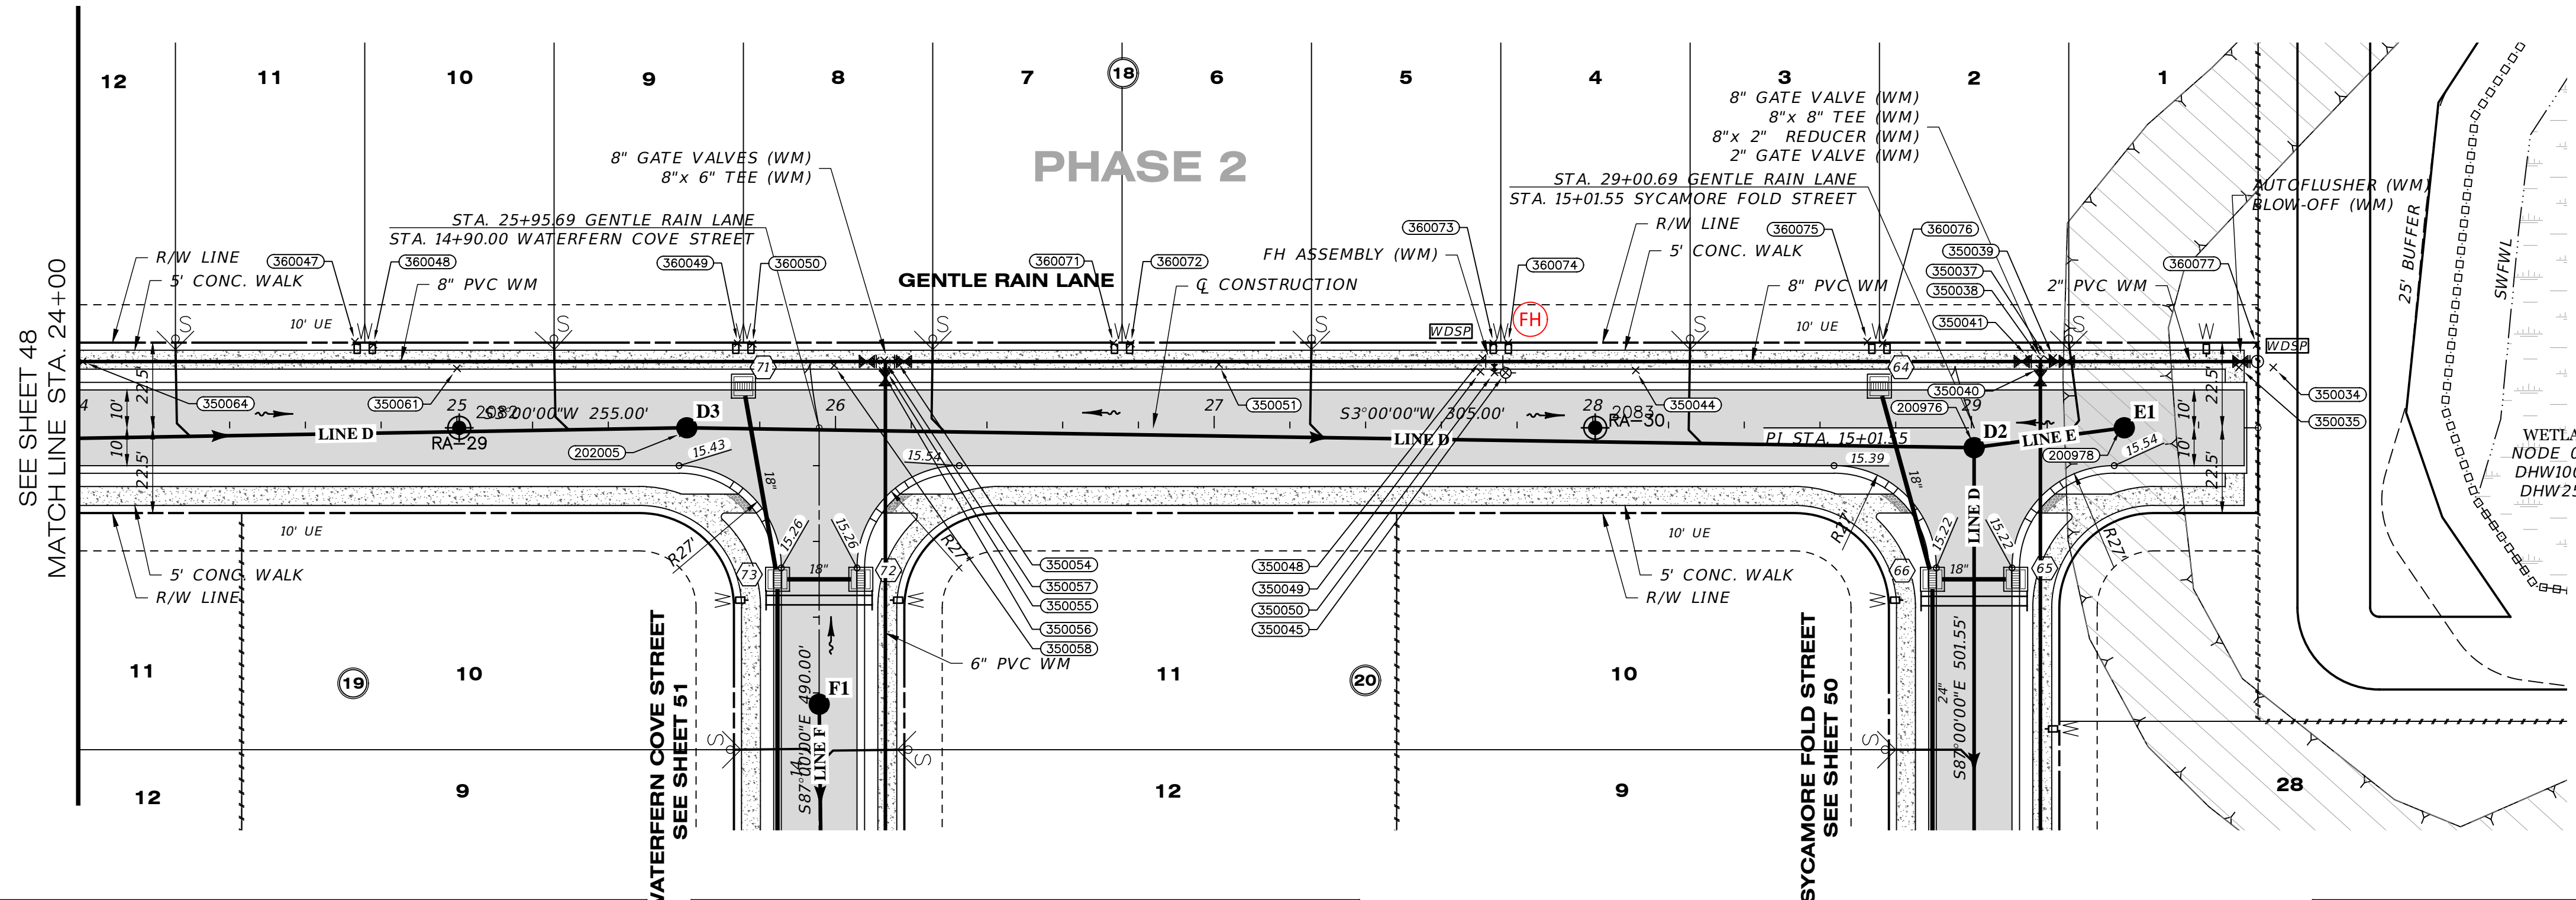

**RECORD DATA PROVIDED BY
GEOPOINT SURVEYING, INC.**

RECORD DRAWING LEGEND	
42.00	PROPOSED/DESIGN ELEVATION OR DIMENSION LINED THROUGH, "RECORD" ELEVATION OR DIMENSION WRITTEN IN.
42.07	INDICATES RECORD ELEVATION
54.8	INDICATES "RECORD" ELEVATION, DIMENSION, SLOPE, et cetera.
10000	INDICATES "RECORD" ITEM NUMBER

**RECORD DRAWING
SURVEYORS CERTIFICATION**

I HEREBY CERTIFY THAT THE RECORD LOCATIONS AND ELEVATIONS DEPICTED ON THESE RECORD DRAWINGS ARE TRUE AND CORRECT AND WERE COLLECTED IN THE FIELD BY THE SURVEYOR AND MAPPER OR A REPRESENTATIVE UNDER THE DIRECT SUPERVISION OF THE SURVEYOR AND MAPPER.

DATE OF LAST FIELD SURVEY 05/30/2025

JUSTIN O. BRANTLEY, P.S.M.
FLORIDA CERTIFICATE NO. LS6837


SWING TIE TABLE					
POINT #		LOCATION 1		LOCATION 2	
350064	WATER MAIN TOP 8"	12.075	160	17.75	75
350061	WATER MAIN TOP 8"	12.439	62	17.75	76
350058	WATER MAIN TOP 8"	13.394	44	17.75	76
350056	WATER MAIN GATE VALVE 8"	13.904	54	17.75	38
350057	WATER MAIN TEE 8"x6"x8"	13.516	57	17.75	38
350055	WATER MAIN GATE VALVE 8"	13.539	55	17.75	38
350054	WATER MAIN GATE VALVE 8"	13.592	59	17.75	41
350051	WATER MAIN TOP 8"	13.317	76	17.75	126
350048	WATER MAIN TEE 8"x6"x8"	12.621	7	17.75	195
350049	WATER MAIN BEND 90°	12.421	7	17.64	105
350050	WATER MAIN GATE VALVE 6"	13.738	3	17.64	102
350045	FIRE HYDRANT	18.559	125	17.64	99
350044	WATER MAIN TOP 8"	11.845	91	17.64	65
350041	WATER MAIN GATE VALVE 8"	13.839	27	17.64	40
350038	WATER MAIN TEE 8"x8"x8"	12.632	79	17.64	28
350040	WATER MAIN GATE VALVE 8"	13.828	27	17.64	26
350037	WATER MAIN REDUCER 8"x2"	12.675	30	17.64	26
350039	WATER MAIN GATE VALVE 2"	12.929	31	17.64	25
350035	WATER MAIN GATE VALVE 2"	12.307	79	17.64	25
350034	WATER MAIN BLOW-OFF 2"	15.379	82	17.64	143

SWING TIE TABLE					
POINT #		LOCATION 1		LOCATION 2	
360047	WATER SINGLE SERVICE	16.139	80	17.75	103
360048	WATER SINGLE SERVICE	15.936	85	17.75	98
360049	WATER SINGLE SERVICE	15.788	28	17.75	11
360050	WATER SINGLE SERVICE	15.763	30	17.75	11
360071	WATER SINGLE SERVICE	16.318	91	17.75	28
360072	WATER SINGLE SERVICE	16.335	95	17.75	103
360073	WATER SINGLE SERVICE	16.053	8	17.64	103
360074	WATER SINGLE SERVICE	16.087	8	17.64	99
360075	WATER SINGLE SERVICE	15.748	39	17.64	12
360076	WATER SINGLE SERVICE	15.821	36	17.64	11
360077	WATER SINGLE SERVICE	15.934	79	17.64	142

SWING TIE TABLE - SANITARY MANHOLES	
SWING TIE POINT #	DESCRIPTION
202005	SANITARY MANHOLE-D3
200976	SANITARY MANHOLE-D2
200978	SANITARY MANHOLE-E1

GENTLE RAIN LANE

SCALE: 1" = 30' HORIZONTAL
1" = 3' VERTICAL

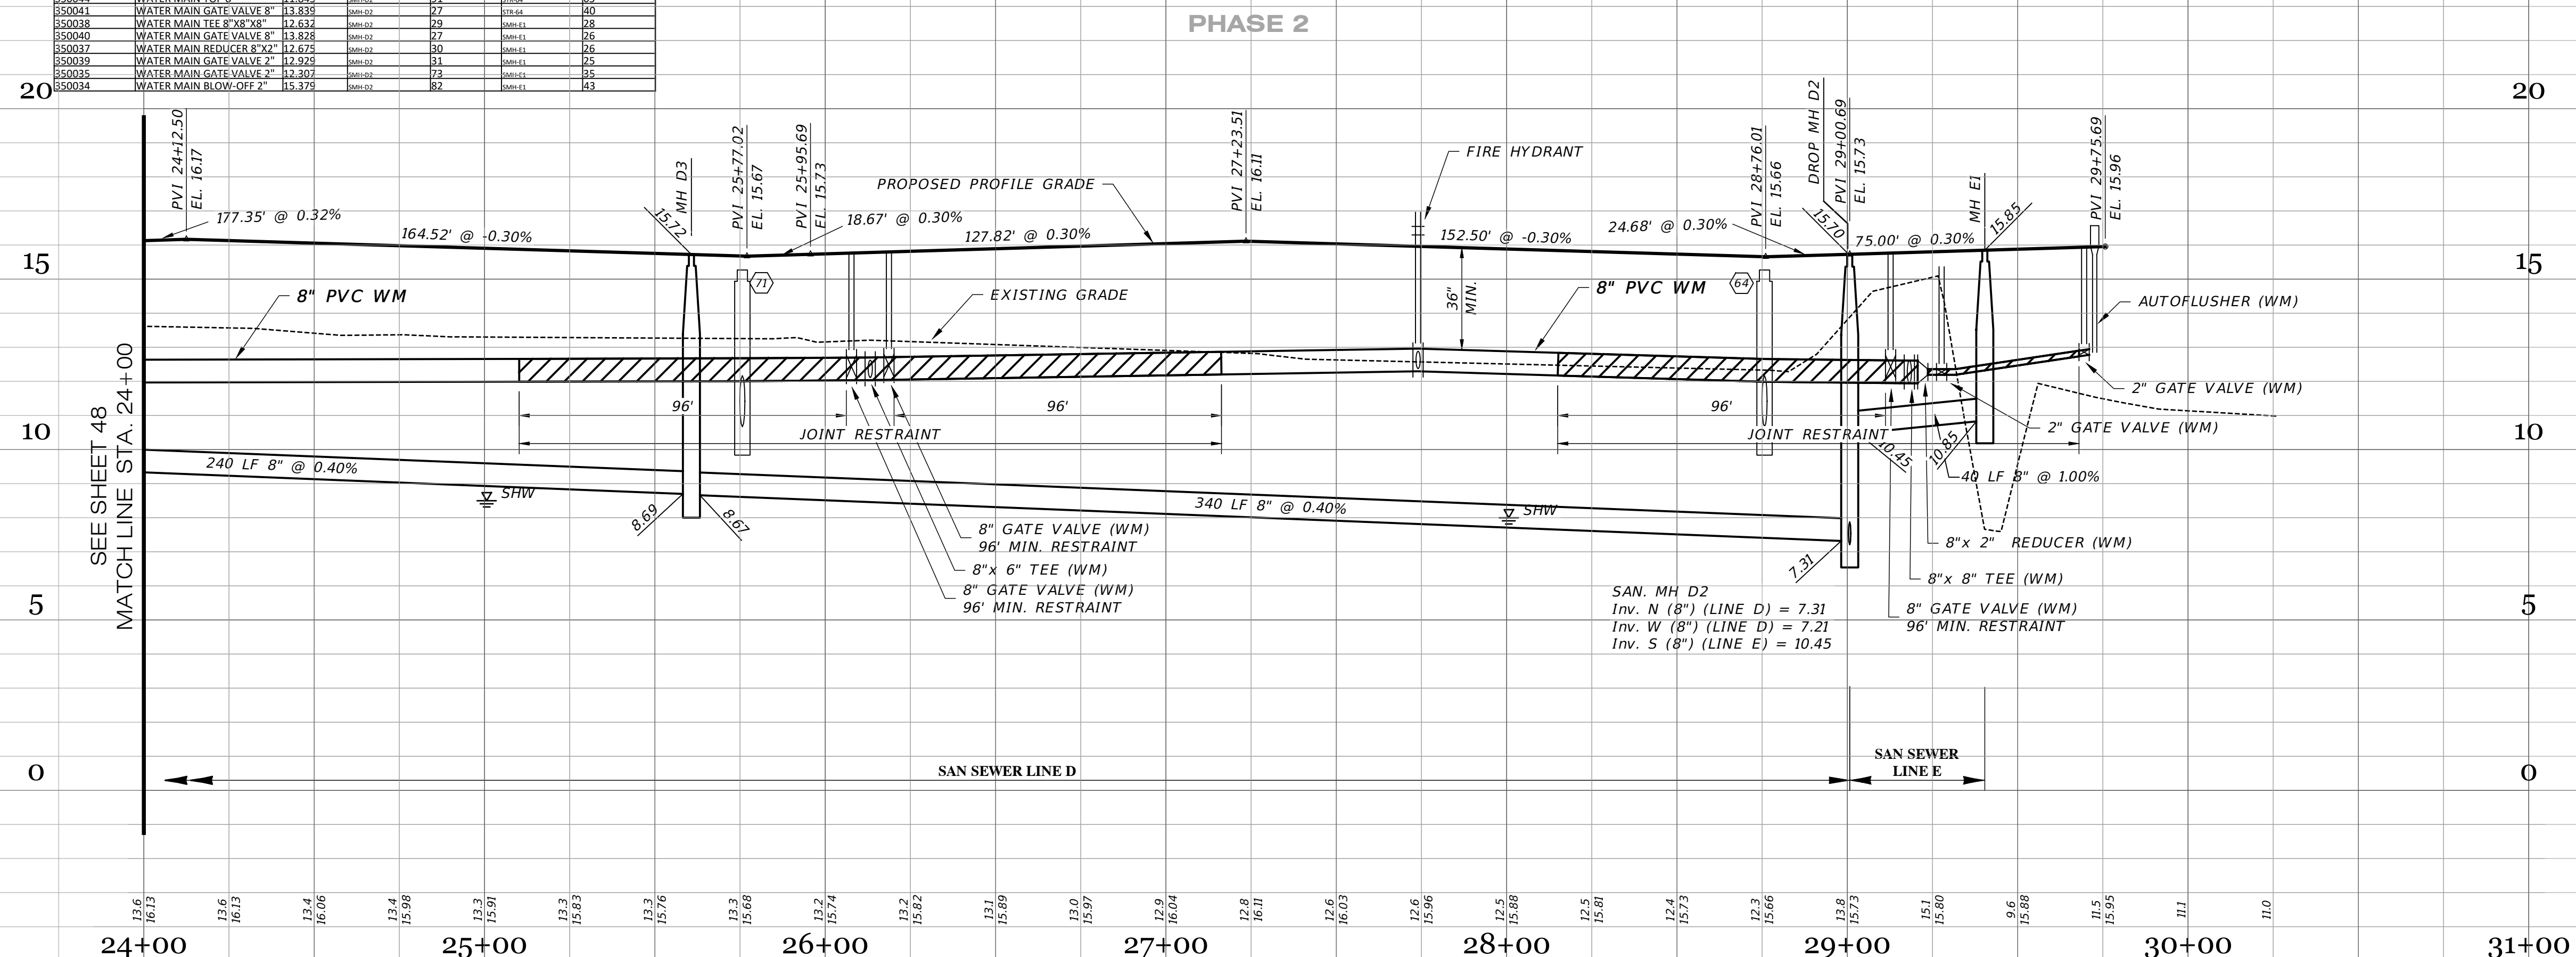

RECORD DRAWINGS
August 29, 2025
APPROVED

06-03-2023 UTIL RECORD DATA BY GEOPOINT 05-18-2023 SIDEWALK 2' FROM R/W @ LOT AREAS 10-22-2021 REST. JOINTS, AUTOFLUSHER 05-17-2021 INITIAL SUBMITTAL		JRD JRD DA JAS		JORDAN A. SCHRADER LICENSE No. 74798 STATE OF FLORIDA PROFESSIONAL ENGINEER		Clearview LAND DESIGN, P.L. Engineering Business C.A. No.: 28898 3010 W. Azalea St., Suite 150, Tampa, Florida 33609 Office: 813-223-3919 Fax: 813-223-3975		ROADWAY & UTILITY PLAN & PROFILE							
06-03-2025 DATE		DESCRIPTION REVISIONS		JRD JRD DA JAS		This item has been digitally signed and sealed by JORDAN A. SCHRADER, P.E. on the date adjacent to the seal. Printed copies of this document are not considered signed and sealed and the signature must be verified on any electronic copies.		JOB NO. JEN-RU-008 DESIGN FERREIRA DRAWN DUNCAN DATE 06-03-2025 FILE RP16		RUSTIC ROAD NORTH PHASES 1 & 2		PREPARED FOR: JEN TAMPA 1, LLC. C/O BANYAN LAND CAPITAL, LLC. Elevations based on North American Vertical Datum 1988 (NAVD 88) Conversion from NAVD 88 to NGVD 29 = +1.11 Feet		SHEET 49 OF 71 SHEETS	

RECORD DATA PROVIDED BY
GEOPPOINT SURVEYING, INC.

RECORD DRAWING LEGEND


- 42.00 PROPOSED/DESIGN ELEVATION OR
DIMENSION LINED THROUGH,
"RECORD" ELEVATION OR
DIMENSION WRITTEN IN.
42.07
54.8
INDICATES RECORD ELEVATION
INDICATES "RECORD" ELEVATION,
DIMENSION, SLOPE, et cetera.
100000 INDICATES "RECORD" ITEM NUMBER

RECORD DRAWING
SURVEYORS CERTIFICATION

I HEREBY CERTIFY THAT THE RECORD LOCATIONS
AND ELEVATIONS DEPICTED ON THESE RECORD
DRAWINGS ARE TRUE AND CORRECT AND WERE
COLLECTED IN THE FIELD BY THE SURVEYOR
AND MAPPER OR A REPRESENTATIVE UNDER THE
DIRECT SUPERVISION OF THE SURVEYOR AND
MAPPER.

DATE OF LAST FIELD SURVEY 05/30/2025

JUSTIN O. BRANTLEY, P.S.M.
FLORIDA CERTIFICATE NO. LS6837

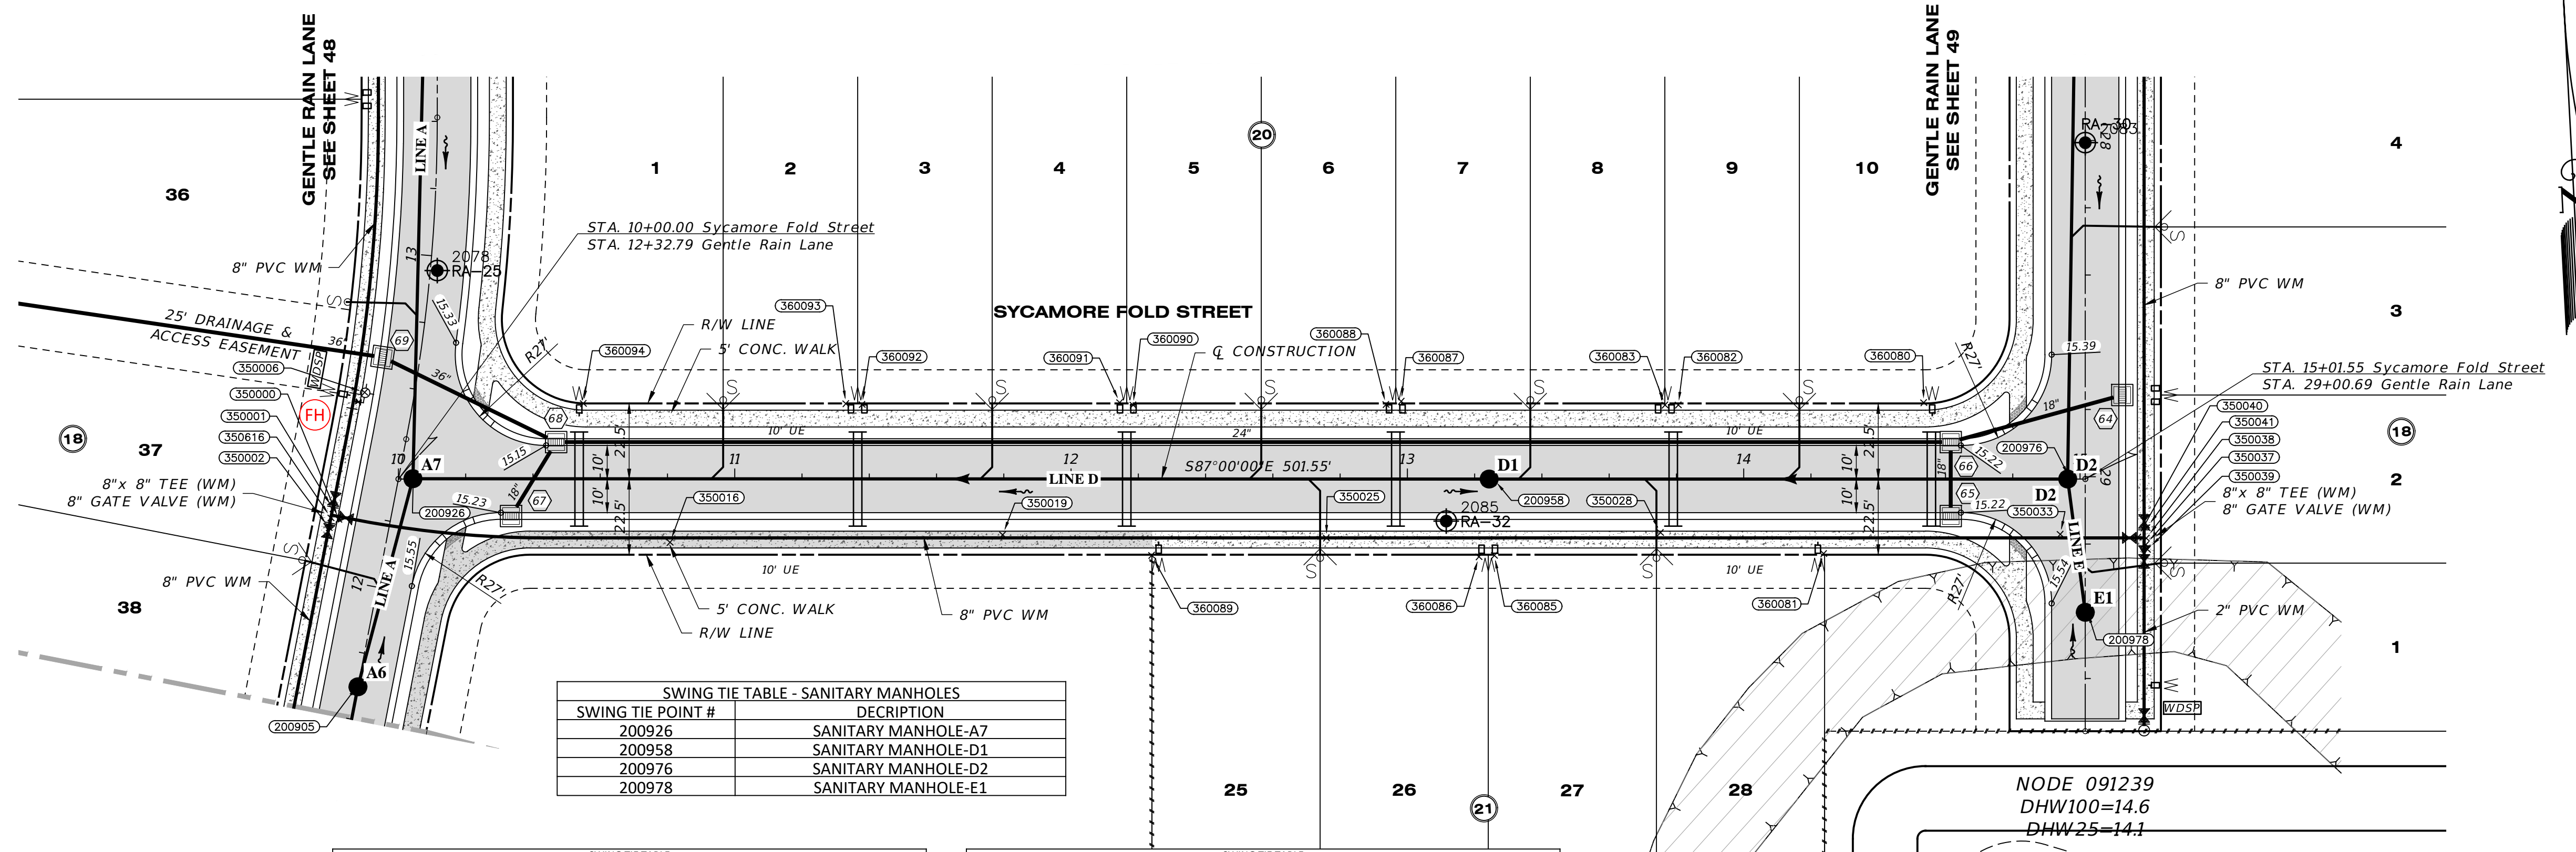


SWING TIE TABLE - SANITARY MANHOLES	
SWING TIE POINT #	DESCRIPTION
200926	SANITARY MANHOLE-A7
200958	SANITARY MANHOLE-D1
200976	SANITARY MANHOLE-D2
200978	SANITARY MANHOLE-E1

SWING TIE TABLE					
WATER MAIN			LOCATION 2		
POINT #	DESCRIPTION	ELEVATION	DESCRIPTION	DISTANCE 1	DISTANCE 2
350001	WATER MAIN GATE VALVE 8"	14.075	350001	36	26
350016	WATER MAIN TEE 8"X8"	14.11	350016	39	28
350002	WATER MAIN GATE VALVE 8"	14.143	350002	42	30
350000	WATER MAIN GATE VALVE 8"	14.019	350000	39	26
350016	WATER MAIN TOP 8"	11.74	350016	45	48
350019	WATER MAIN TOP 8"	11.756	350019	136	146
350025	WATER MAIN TOP 8"	12.917	350025	186	53
350028	WATER MAIN TOP 8"	11.744	350028	86	52
350033	WATER MAIN TOP 8"	11.516	350033	17	43
350040	WATER MAIN GATE VALVE 8"	13.828	350040	27	62
350044	WATER MAIN TEE 8"X8"	13.839	350044	27	40
350038	WATER MAIN TEE 8"X8"	12.632	350038	28	43
350037	WATER MAIN REDUCER 8"X2"	12.675	350037	26	45
350039	WATER MAIN GATE VALVE 2"	12.929	350039	45	47


SWING TIE TABLE					
WATER SERVICE			LOCATION 2		
POINT #	DESCRIPTION	ELEVATION	DESCRIPTION	DISTANCE 1	DISTANCE 2
360004	WATER SINGLE SERVICE	15.653	360004	14	40
360093	WATER SINGLE SERVICE	16.312	360093	87	205
360002	WATER SINGLE SERVICE	16.183	360002	92	110
360001	WATER SINGLE SERVICE	16.647	360001	168	113
360090	WATER SINGLE SERVICE	16.469	360090	172	209
360089	WATER SINGLE SERVICE	16.257	360089	180	104
360088	WATER SINGLE SERVICE	16.628	360088	171	39
360087	WATER SINGLE SERVICE	16.512	360087	167	36
360086	WATER SINGLE SERVICE	16.192	360086	141	24
360085	WATER SINGLE SERVICE	16.244	360085	136	23
360083	WATER SINGLE SERVICE	16.118	360083	91	56
360082	WATER SINGLE SERVICE	16.399	360082	119	59
360081	WATER SINGLE SERVICE	16.245	360081	77	50
360080	WATER SINGLE SERVICE	15.768	360080	69	14

SYCAMORE FOLD STREET

SCALE: 1" = 30' HORIZONTAL
1" = 3' VERTICAL

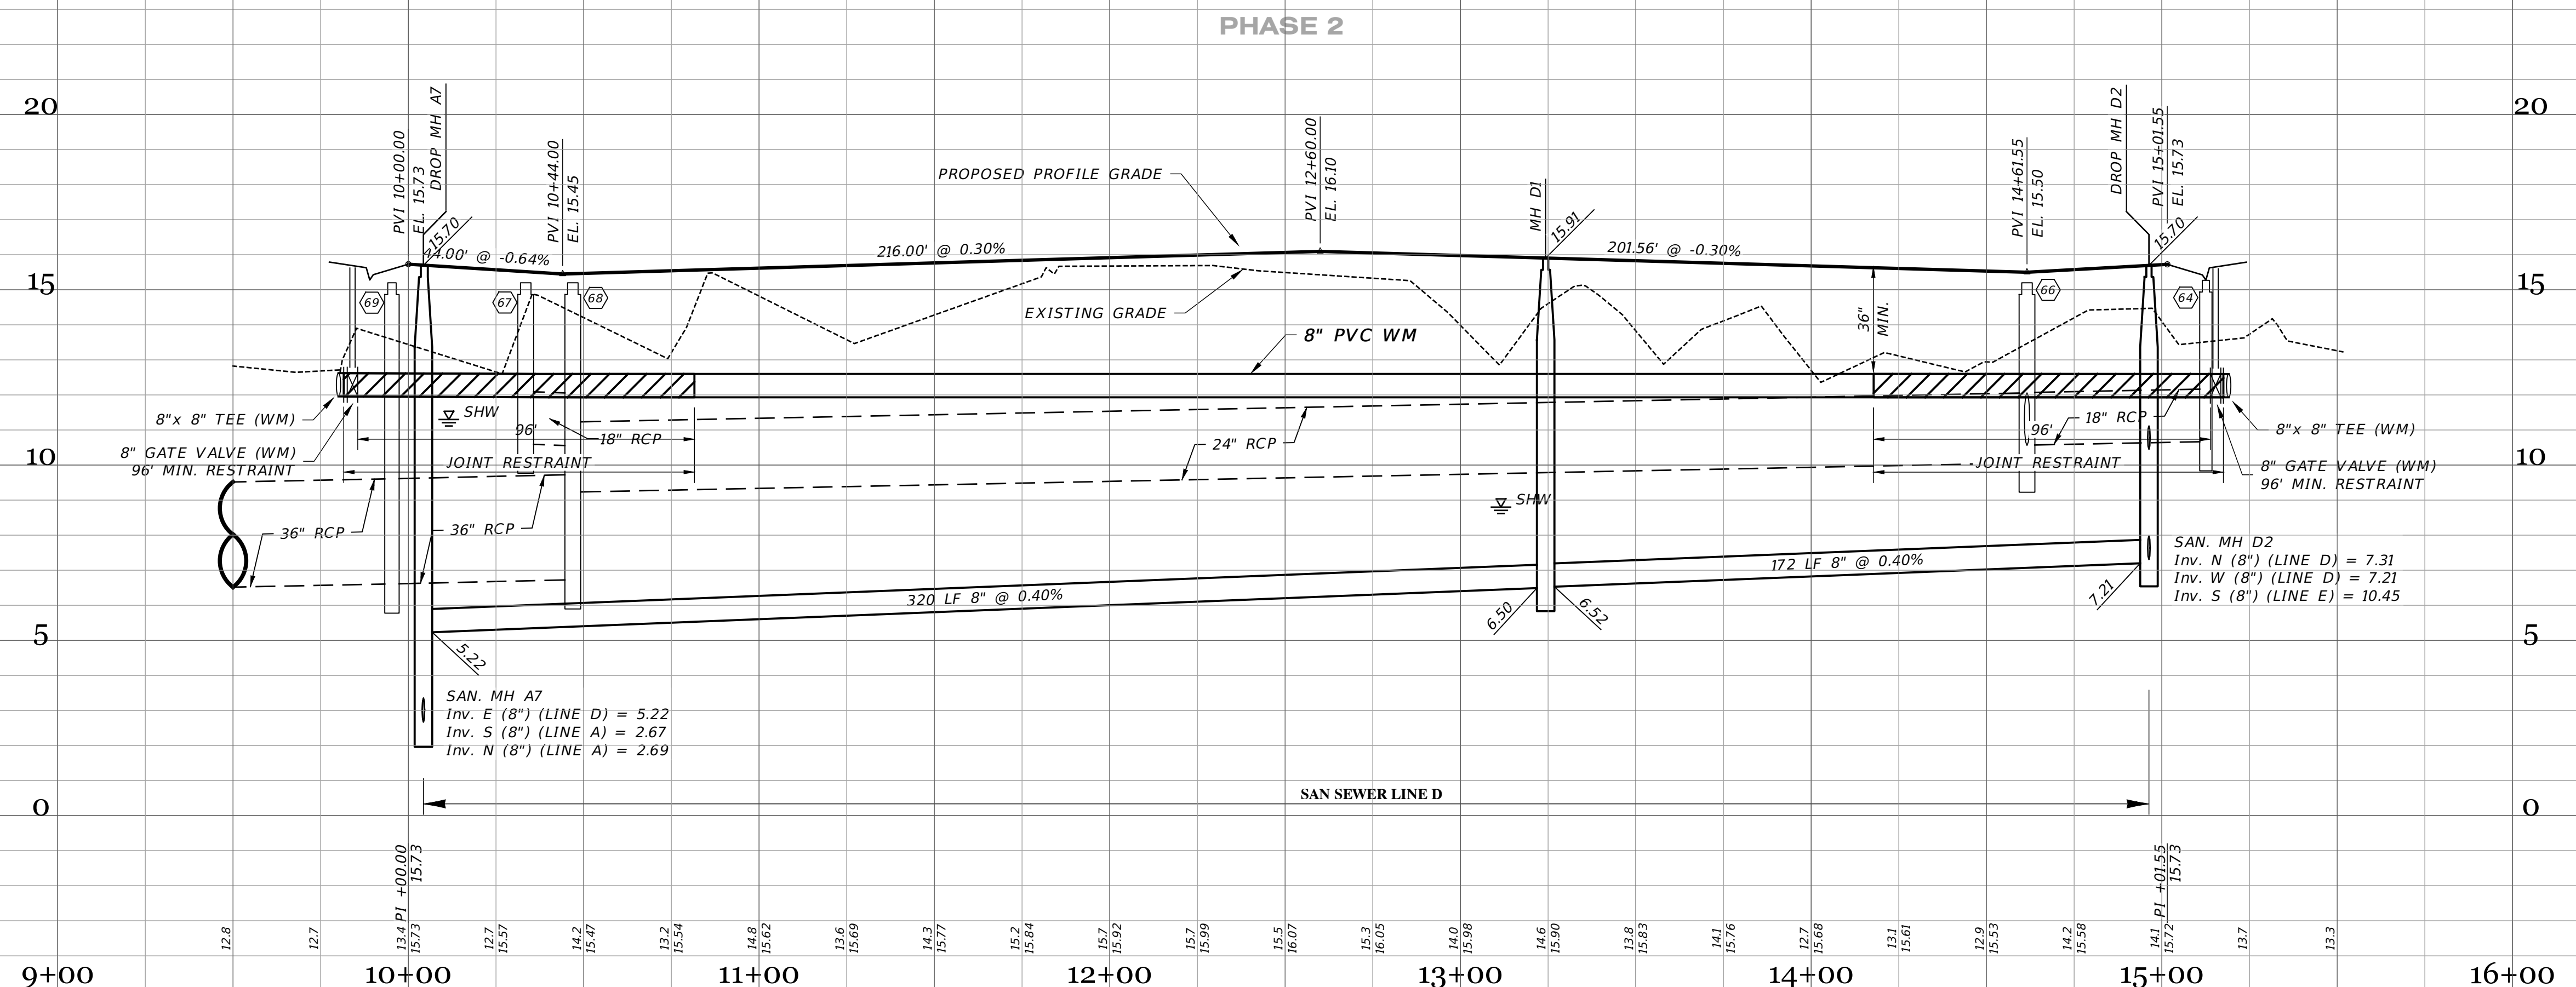

DATE	DESCRIPTION	BY
06-03-2025	UTIL RECORD DATA BY GEOPPOINT	JRD
05-18-2023	SIDEWALK 2' FROM R/W @ LOT AREAS	JRD
04-04-2022	MOD STORM 66-68-69 PIPE SIZE	TJF
10-22-2021	REST JOINTS	DA
05-17-2021	INITIAL SUBMITTAL	JAS
REVISIONS		

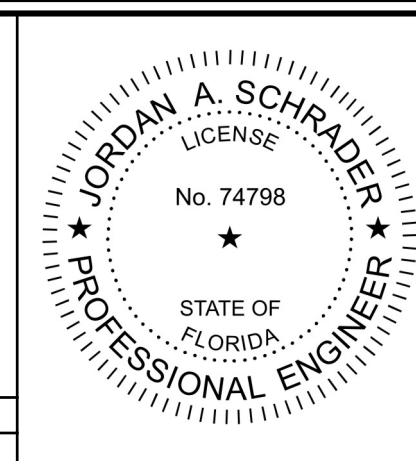

Clearview
LAND DESIGN, P.L.
Engineering Business C.A. No.: 28898
3010 W Azalea St., Suite 150, Tampa, Florida 33609
Office: 813-223-3919 Fax: 813-223-3975
This item has been digitally signed and sealed by
JORDAN A. SCHRADER, P.E. on the date adjacent to the
seal. Printed copies of this document are not considered
signed and sealed and the signature must be verified on any
electronic copies.
DATE: 06/03/2025
JORDAN A. SCHRADER, P.E. NO. 74798
FLORIDA PROFESSIONAL ENGINEER

ROADWAY & UTILITY PLAN & PROFILE	
JOB NO. JEN-RU-008	FOR: JEN TAMPA 1, LLC.
DESIGN FERREIRA	FOR: C/O BANYAN LAND CAPITAL, LLC.
DRAWN DUNCAN	Elevations based on North American Vertical Datum 1988 (NAVD 88)
DATE 06-03-2025	Conversion from NAVD 88 to NGVD 29 = +1.11 Feet
FILE RP17	SHEET 50 OF 71 SHEETS

RECORD DATA PROVIDED BY
GEOPOINT SURVEYING, INC.

RECORD DRAWING LEGEND

- 42.00
42.07
54.8
- PROPOSED/DESIGN ELEVATION OR
DIMENSION LINED THROUGH,
"RECORD" ELEVATION OR
DIMENSION WRITTEN IN.
- INDICATES RECORD ELEVATION
- INDICATES "RECORD" ELEVATION,
DIMENSION, SLOPE, et cetera.
- (10000) INDICATES "RECORD" ITEM NUMBER


RECORD DRAWING
SURVEYORS CERTIFICATION

I HEREBY CERTIFY THAT THE RECORD LOCATIONS
AND ELEVATIONS DEPICTED ON THESE RECORD
DRAWINGS ARE TRUE AND CORRECT AND WERE
COLLECTED IN THE FIELD BY THE SURVEYOR
AND MAPPER OR A REPRESENTATIVE UNDER THE
DIRECT SUPERVISION OF THE SURVEYOR AND
MAPPER.

DATE OF LAST FIELD SURVEY 05/30/2025

JUSTIN O. BRANTLEY, P.S.M.
FLORIDA CERTIFICATE NO. LS6837

SWING TIE TABLE - SANITARY MANHOLES	
SWING TIE POINT #	DESCRIPTION
202001	SANITARY MANHOLE-A8
202000	SANITARY MANHOLE-F1
202005	SANITARY MANHOLE-D3

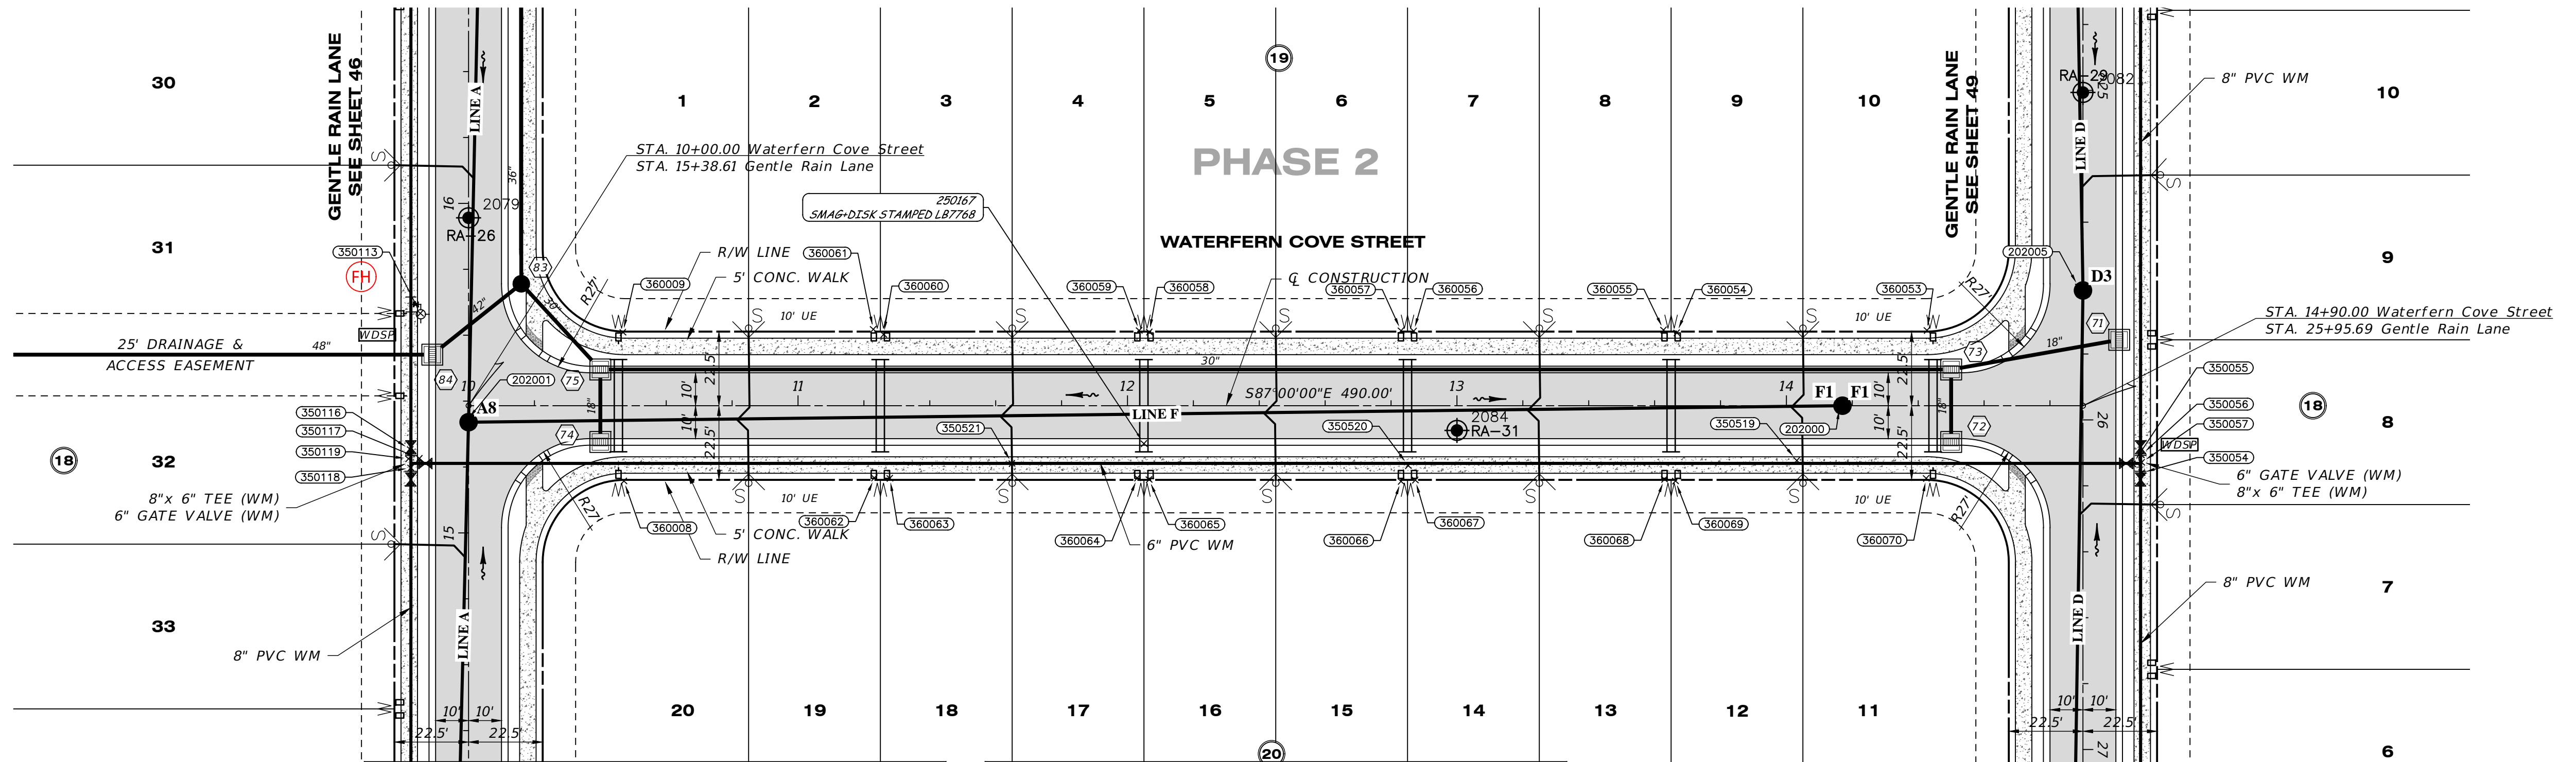


SWING TIE TABLE	
POINT #	DESCRIPTION
350116	WATER MAIN GATE VALVE 8"
350119	WATER MAIN TEE 8"x8"
350118	WATER MAIN GATE VALVE 8"
350117	WATER MAIN GATE VALVE 6"
350221	WATER MAIN TOP 8"
350220	WATER MAIN TOP 8"
350519	WATER MAIN TOP 8"
350055	WATER MAIN GATE VALVE 8"
350057	WATER MAIN TEE 8"x8"
350056	WATER MAIN GATE VALVE 8"
350054	WATER MAIN GATE VALVE 8"

SWING TIE TABLE	
POINT #	DESCRIPTION
360009	WATER SINGLE SERVICE
360008	WATER SINGLE SERVICE
360061	WATER SINGLE SERVICE
360080	WATER SINGLE SERVICE
360082	WATER SINGLE SERVICE
360083	WATER SINGLE SERVICE
360059	WATER SINGLE SERVICE
360058	WATER SINGLE SERVICE
360084	WATER SINGLE SERVICE
360055	WATER SINGLE SERVICE
360057	WATER SINGLE SERVICE
360056	WATER SINGLE SERVICE
360066	WATER SINGLE SERVICE
360054	WATER SINGLE SERVICE
360055	WATER SINGLE SERVICE
360058	WATER SINGLE SERVICE
360059	WATER SINGLE SERVICE
360053	WATER SINGLE SERVICE
360070	WATER SINGLE SERVICE

WATERFERN COVE STREET

SCALE: 1" = 30' HORIZONTAL
1" = 3' VERTICAL

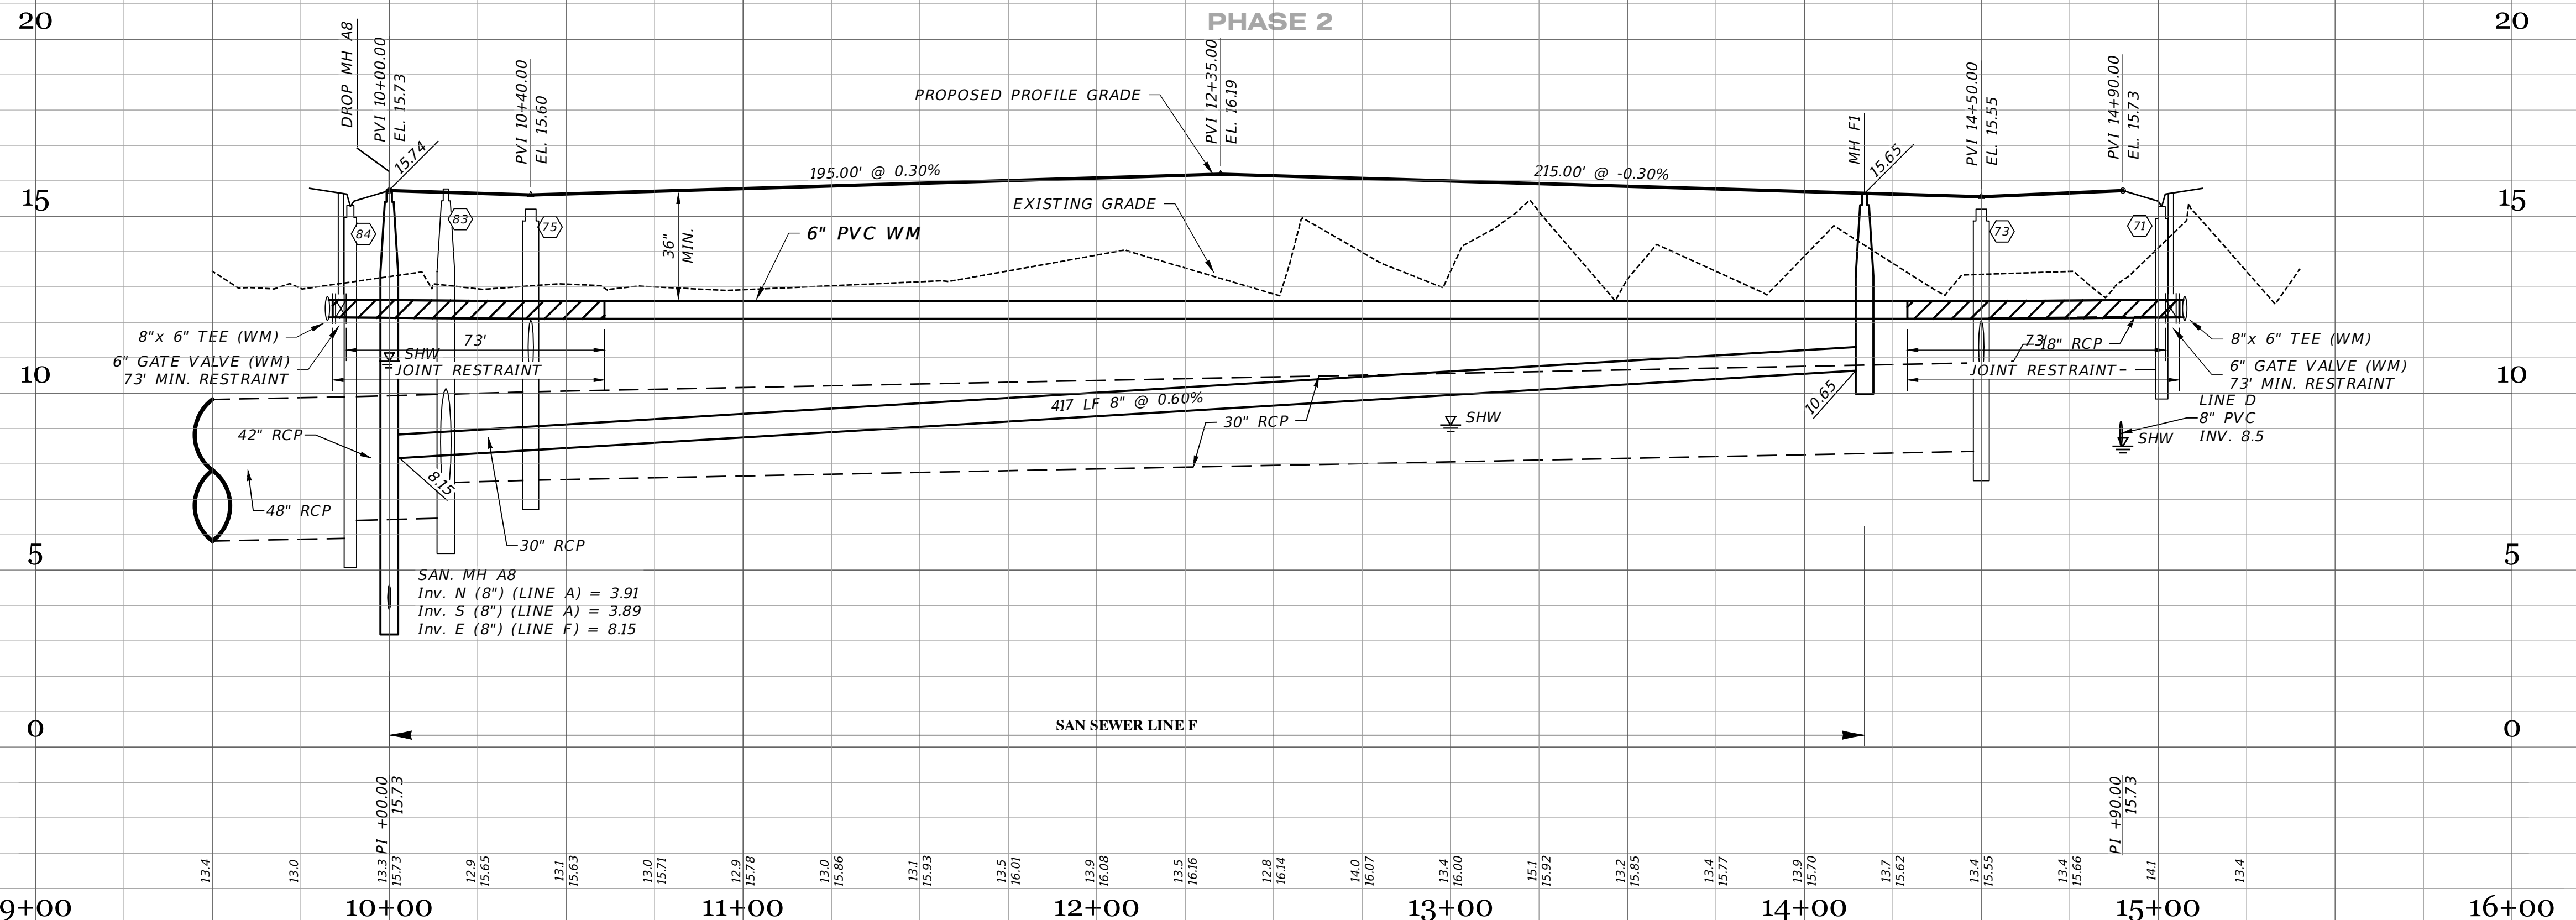

RECORD DRAWINGS
August 29, 2025
APPROVED

06-03-2025 05-18-2023 10-22-2021 05-17-2021		UTIL RECORD DATA BY GEOPOINT SIDEWALK, 2' FROM R/W @ LOT AREAS REST. JOINTS INITIAL SUBMITTAL	JRD JRD DA JAS
DATE		DESCRIPTION	BY
06-03-2025		REVISIONS	









JORDAN A. SCHRADER
LICENSE
No. 74798
STATE OF FLORIDA
PROFESSIONAL ENGINEER

Clearview
LAND DESIGN, P.L.
Engineering Business C.A. No.: 28898
3010 W Azeele St., Suite 150, Tampa, Florida 33609
Office: 813-223-3919 Fax: 813-223-3975


This item has been digitally signed and sealed by
JORDAN A. SCHRADER, P.E. on the date adjacent to the
seal. Printed copies of this document are not considered
signed and sealed and the signature must be verified on any
electronic copies.

DATE: 06/03/2025
JORDAN A. SCHRADER, P.E. NO. 74798
FLORIDA PROFESSIONAL ENGINEER

JOB NO. JEN-RU-008		RUSTIC ROAD NORTH PHASES 1 & 2	
DESIGN FERREIRA	FOR: C/O BANYAN LAND CAPITAL, LLC.	JEN TAMPA 1, LLC.	
DRAWN DUNCAN	DATE 06-03-2025	Elevations based on North American Vertical Datum 1988 (NAVD 88) Conversion from NAVD 88 to NGVD 29 = +1.11 Feet	
FILE RP18	SHEET 51 OF 71 SHEETS		

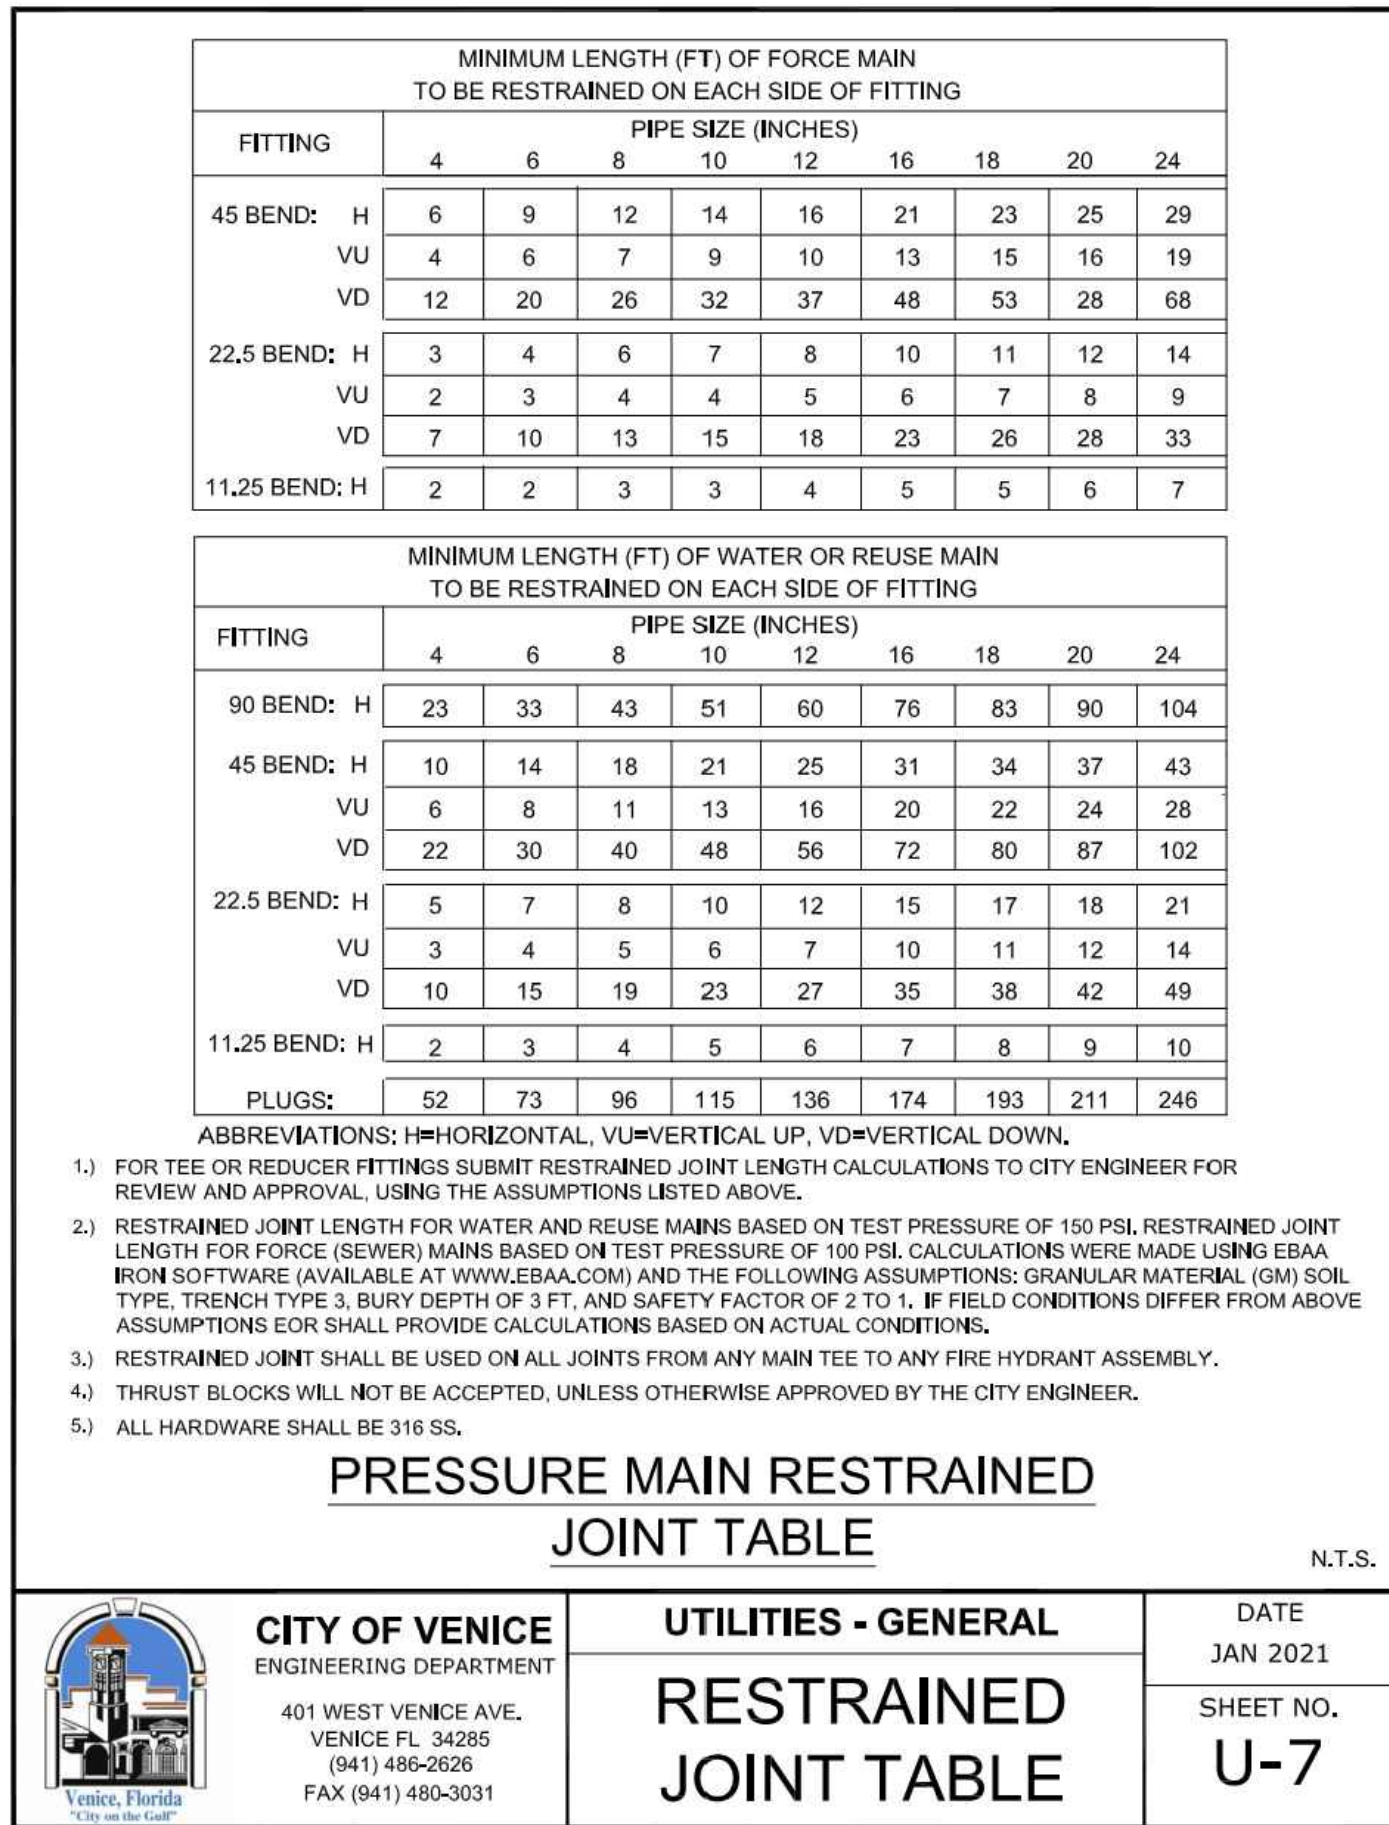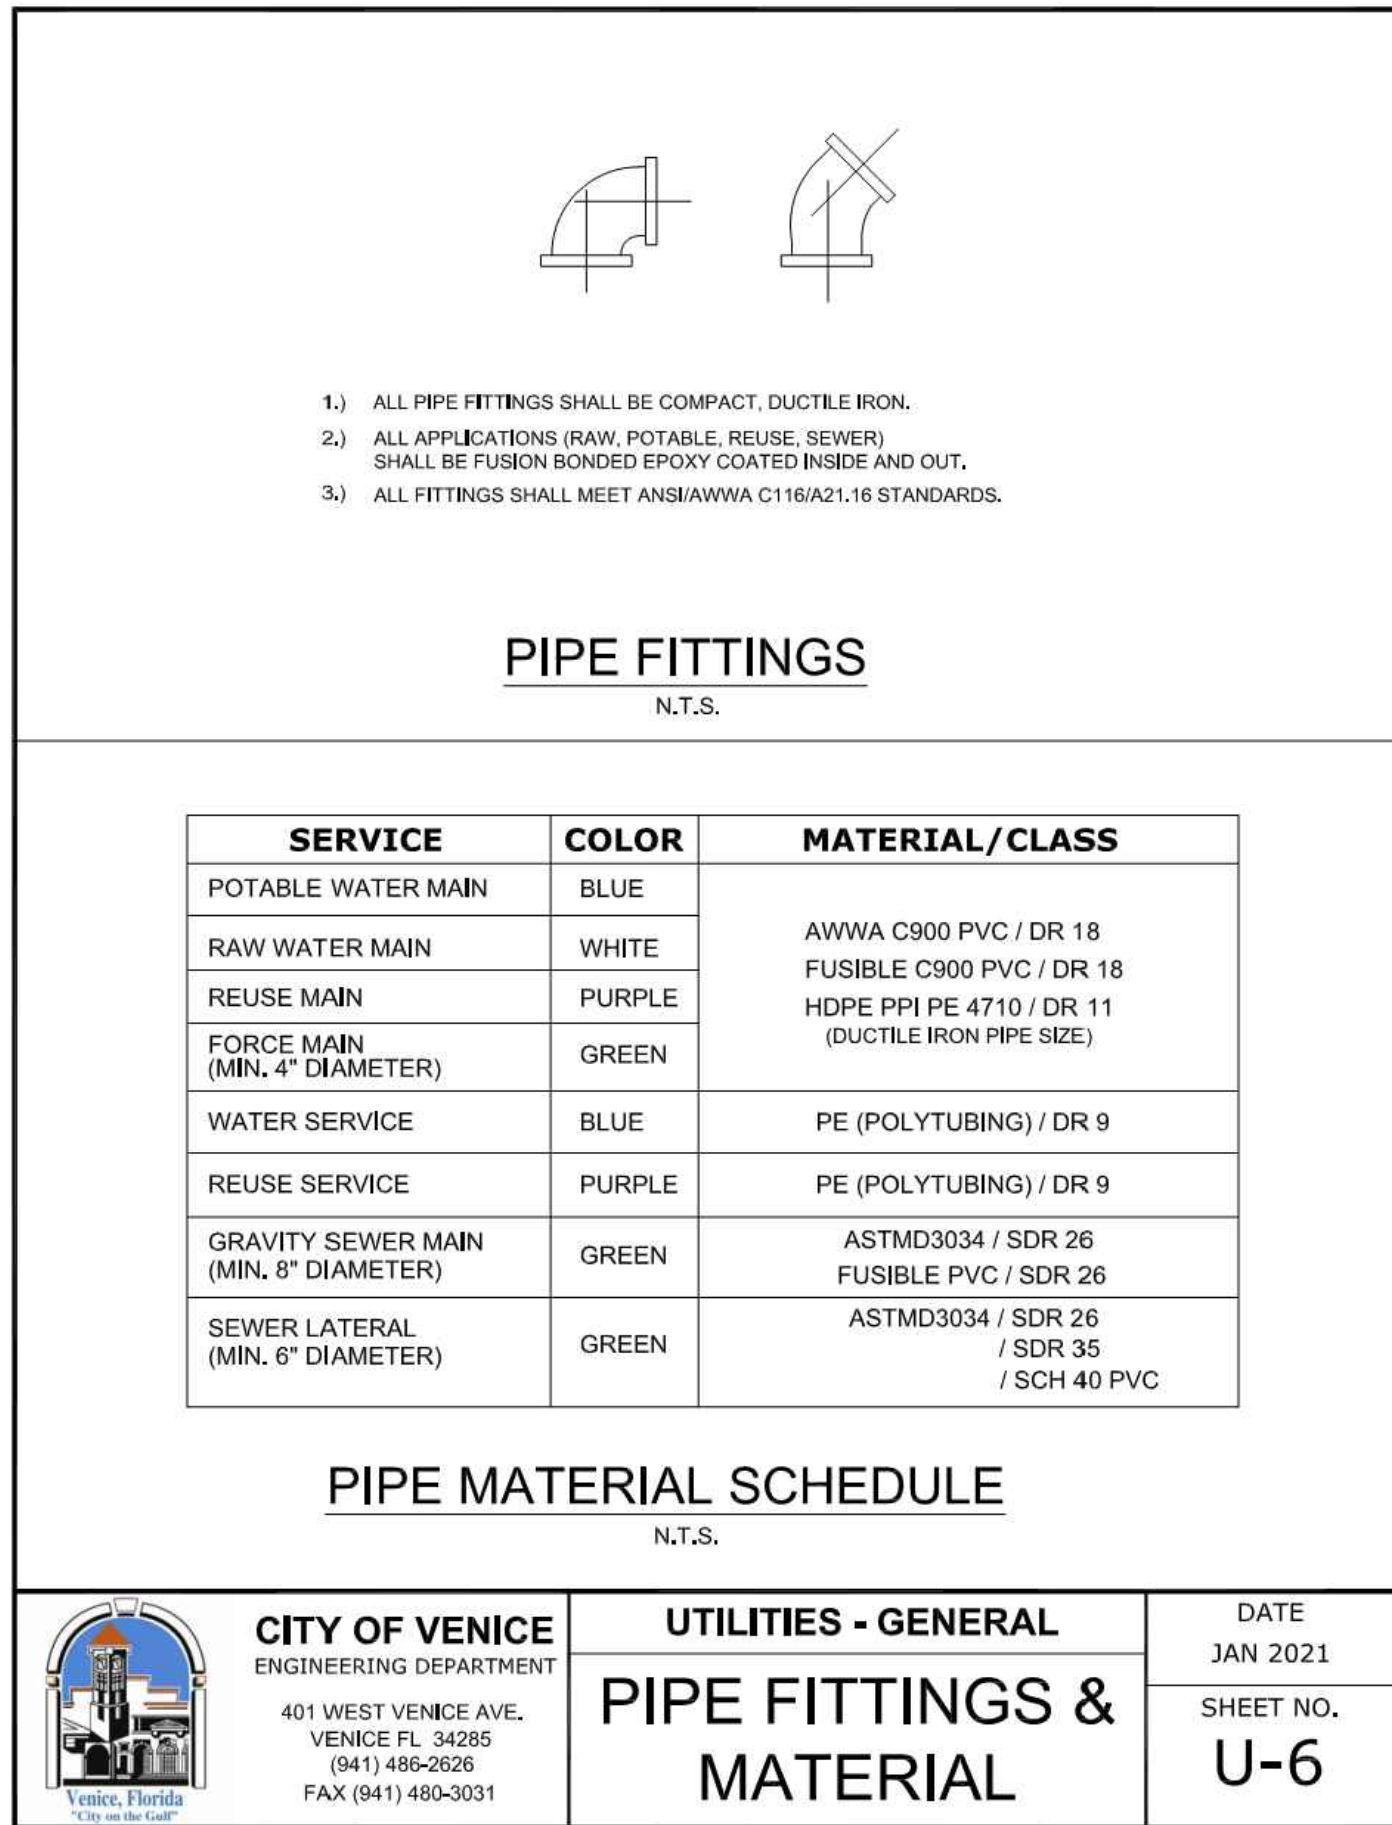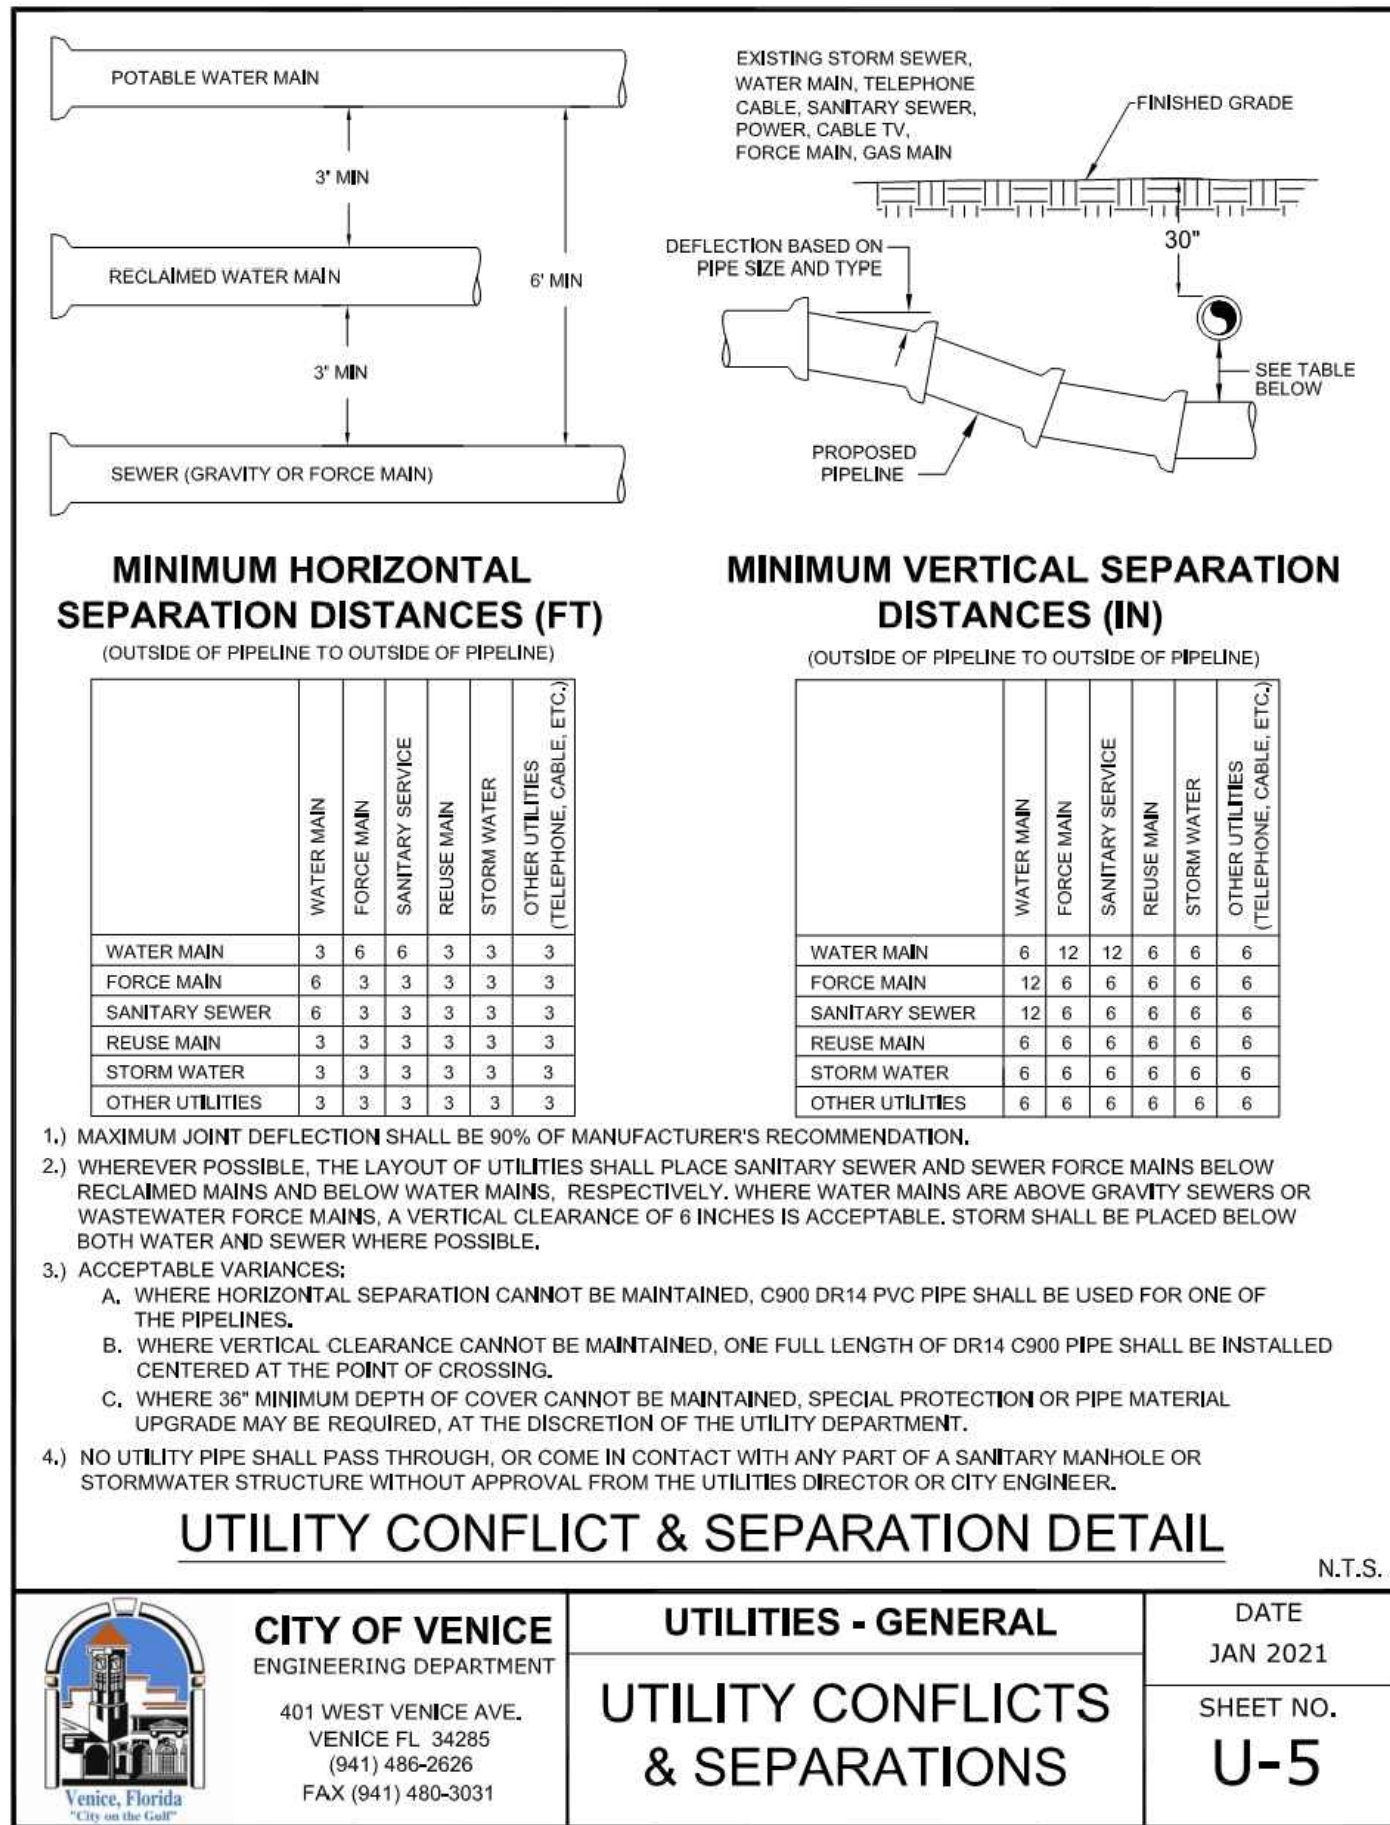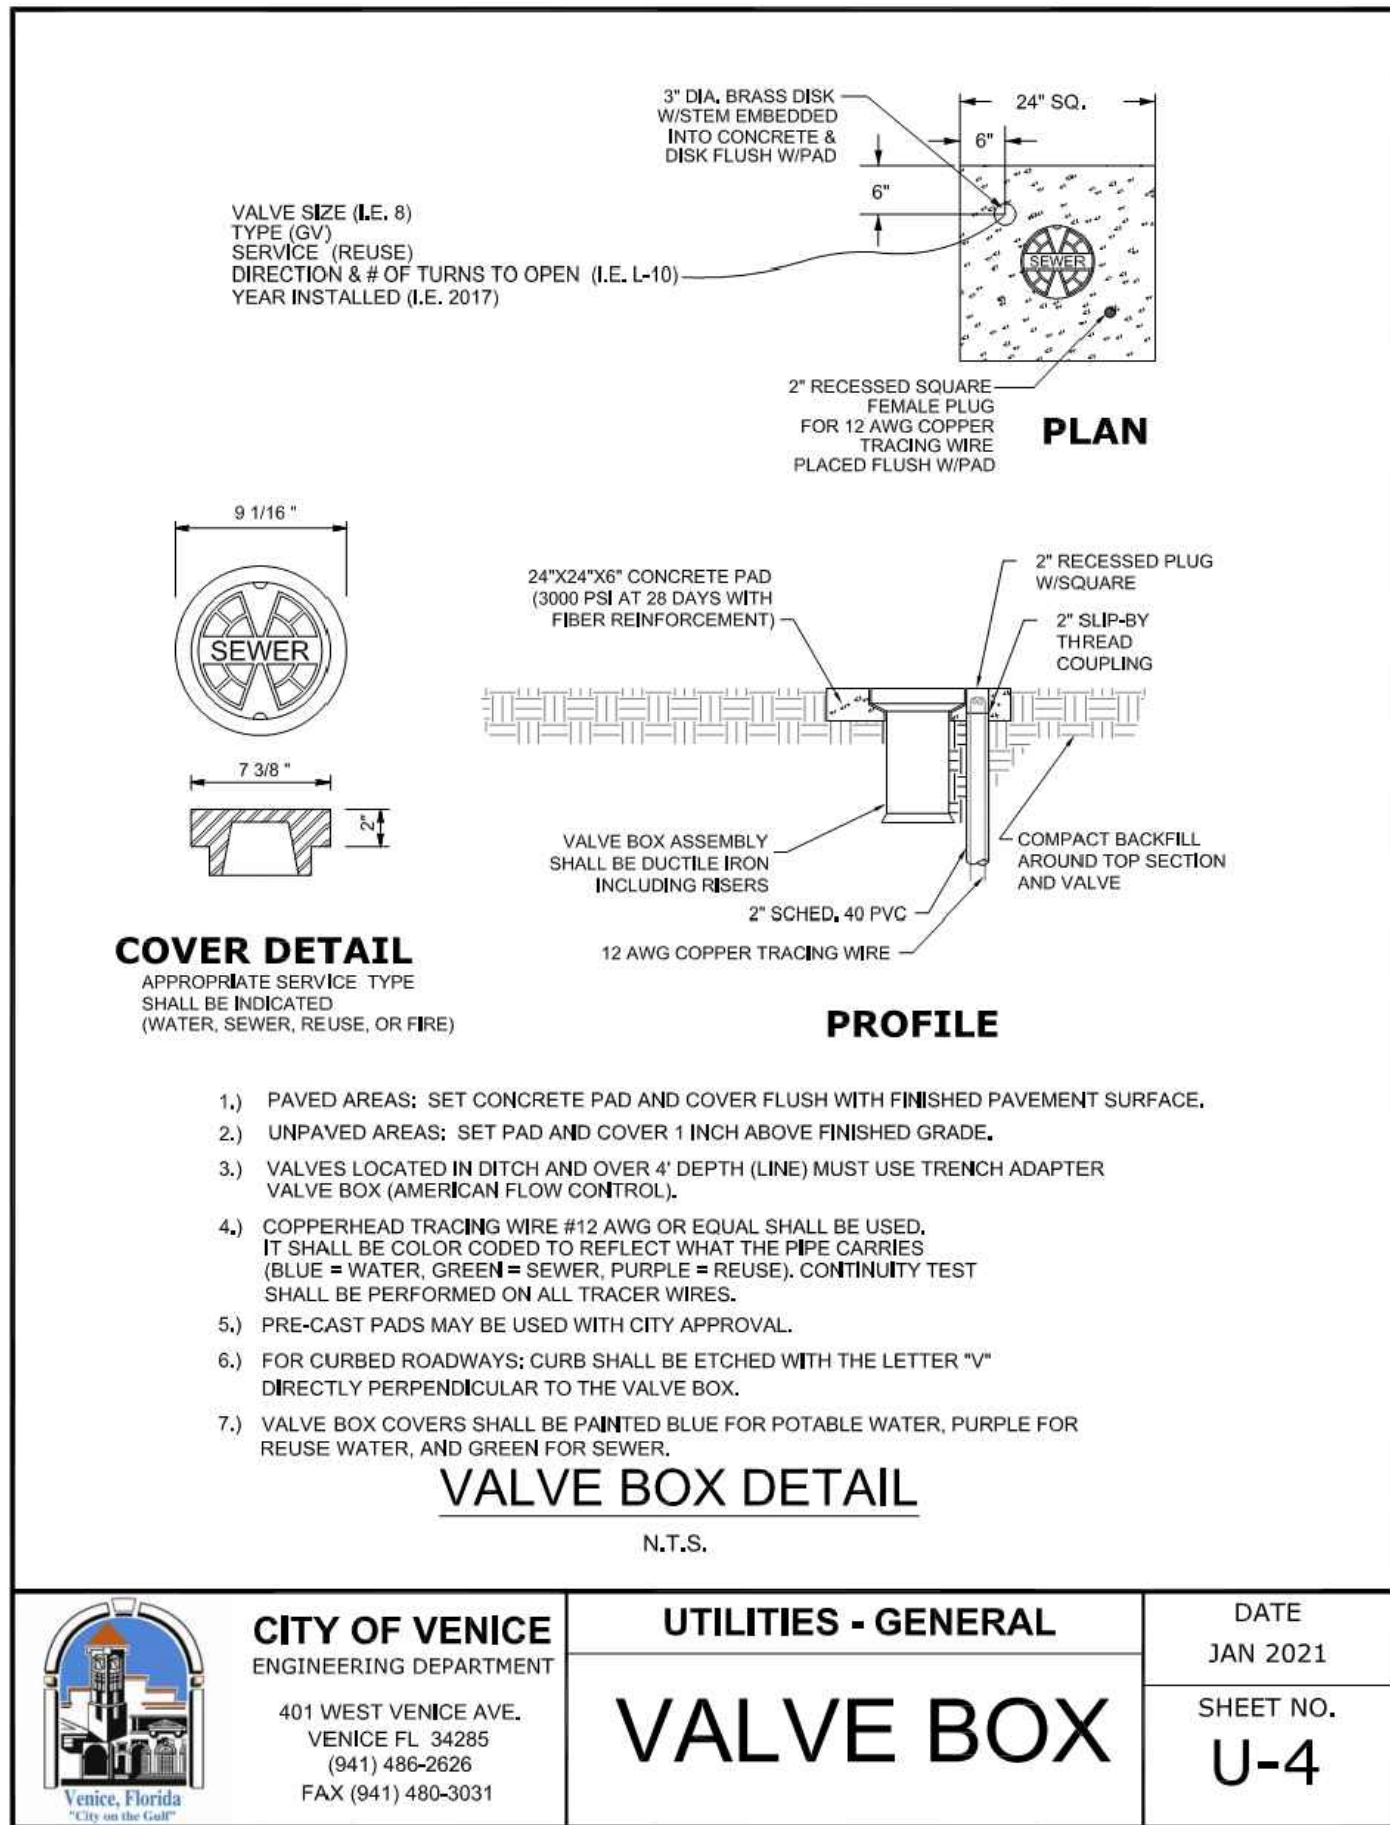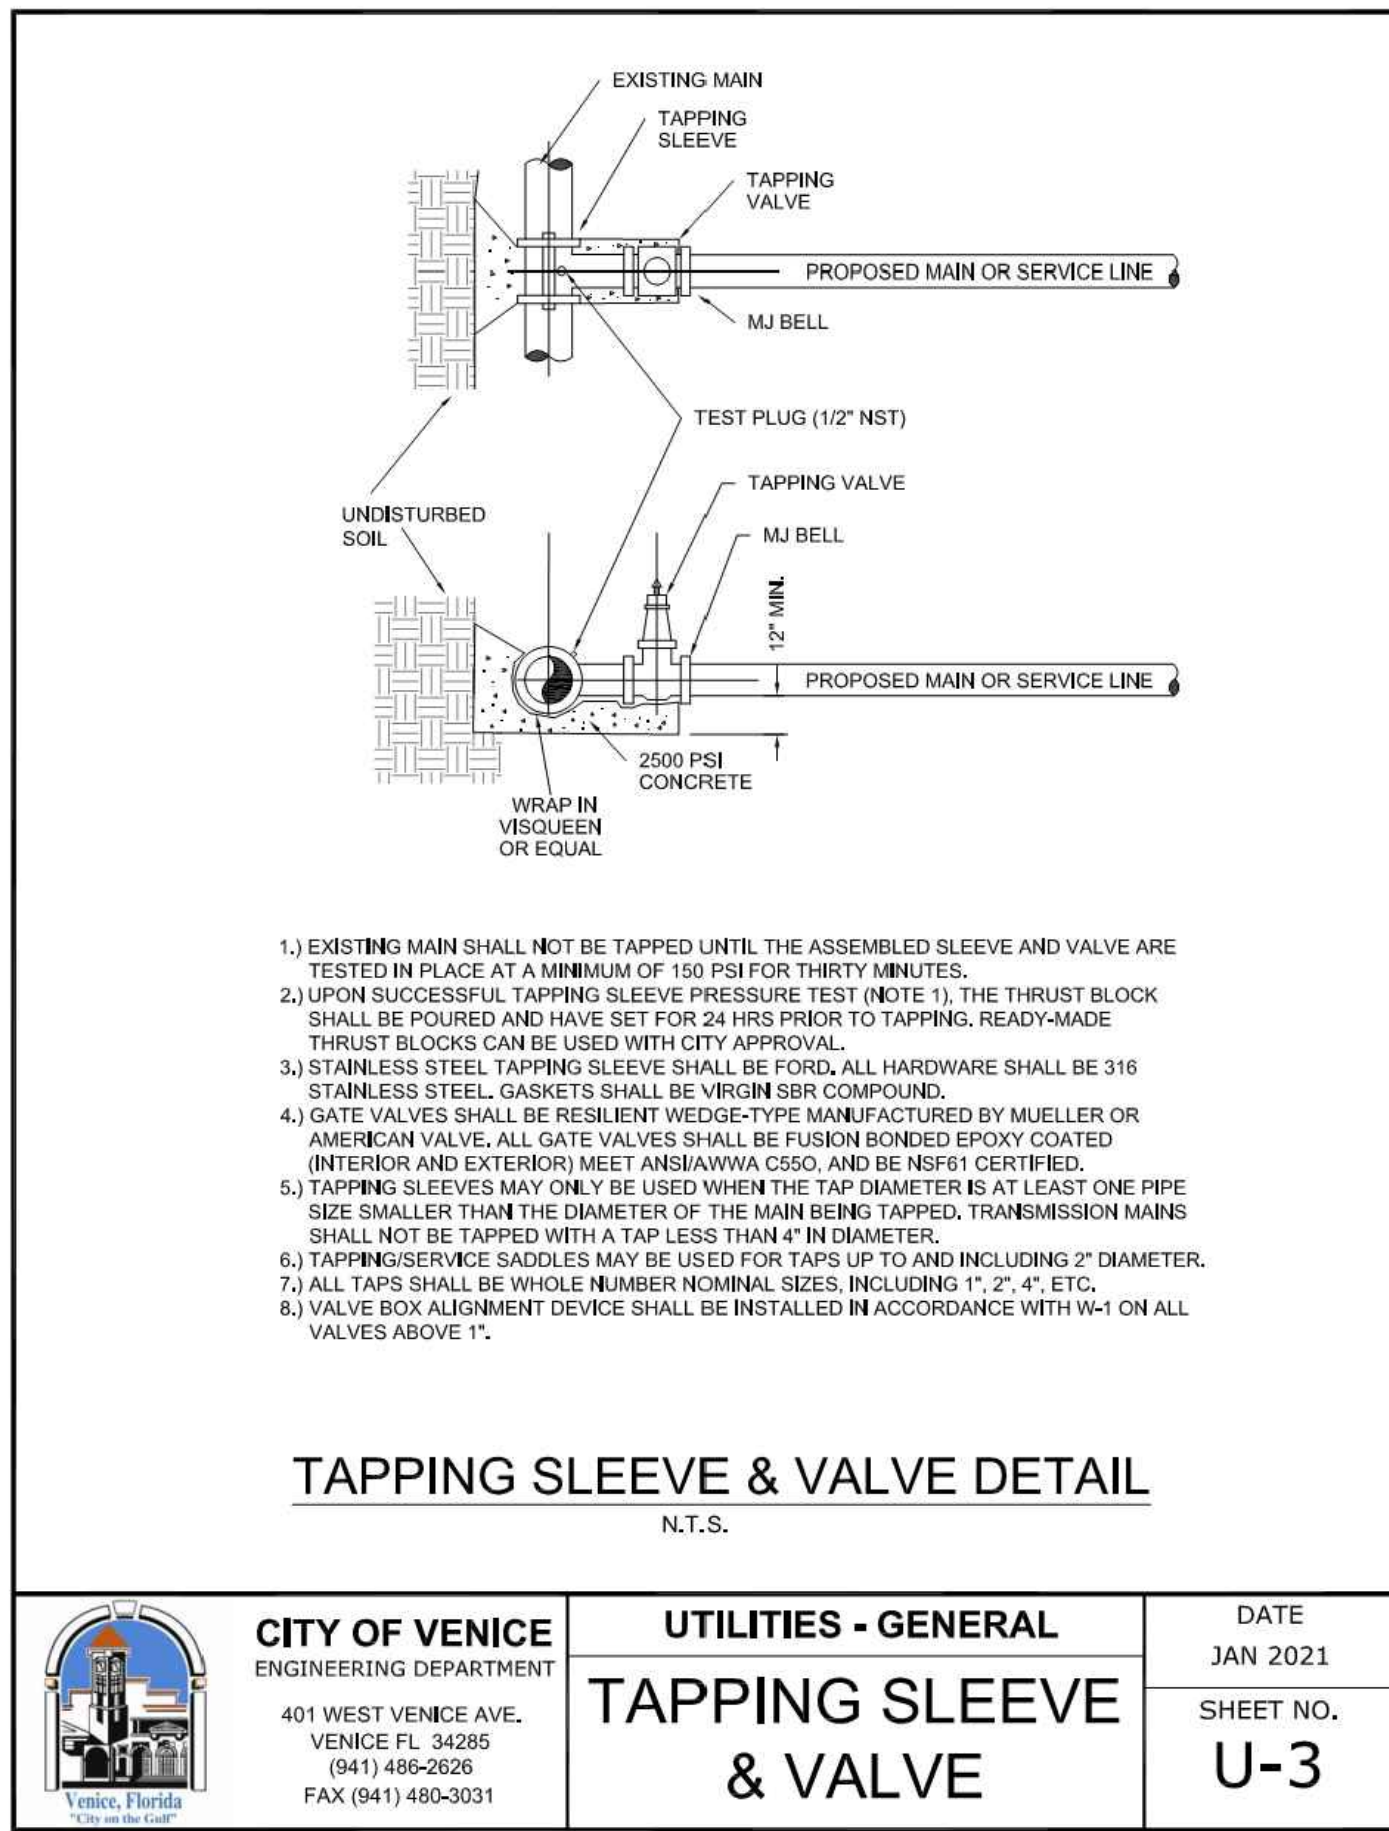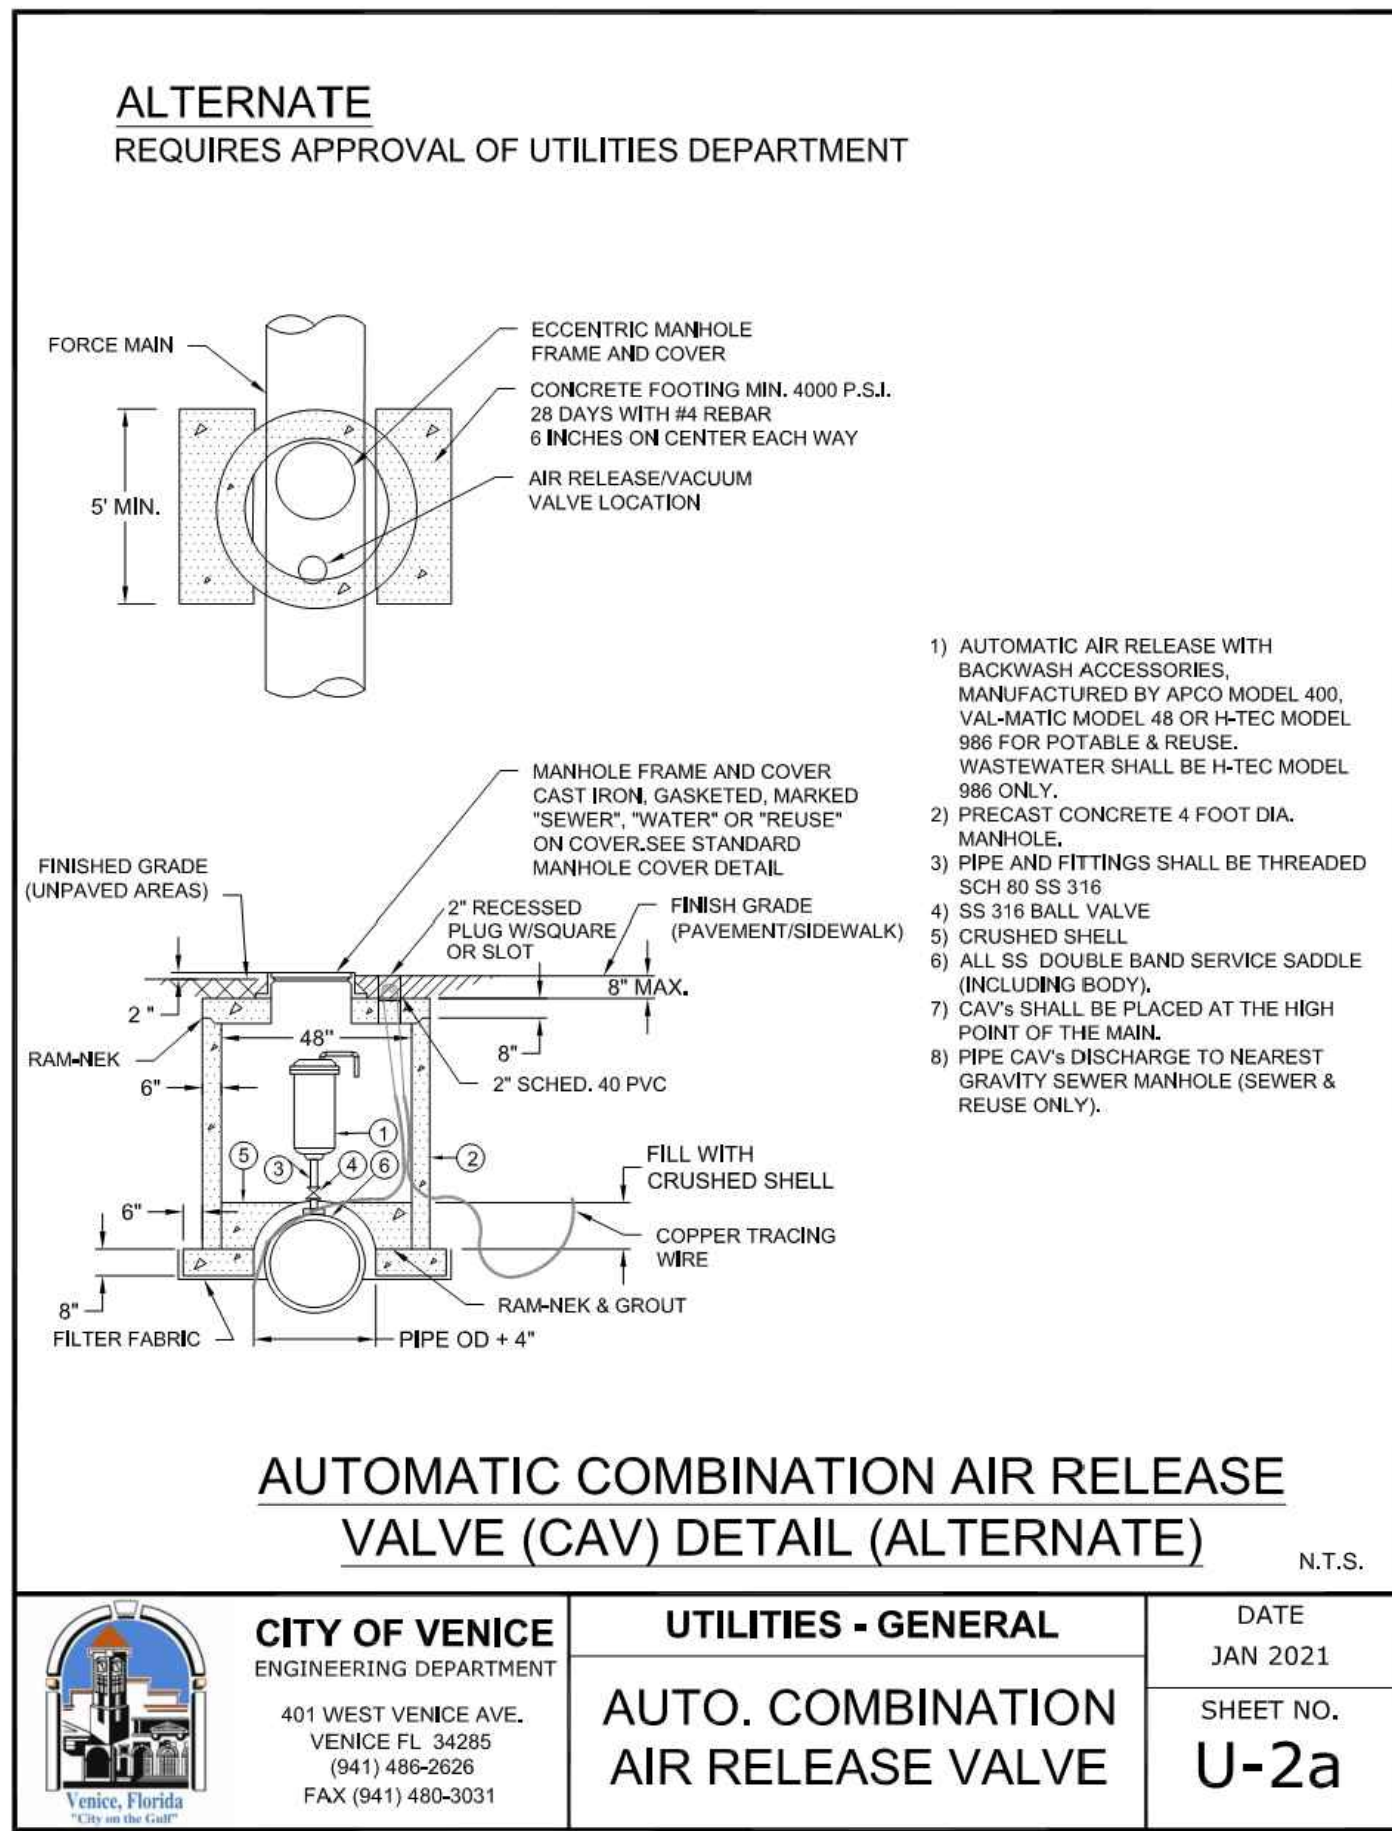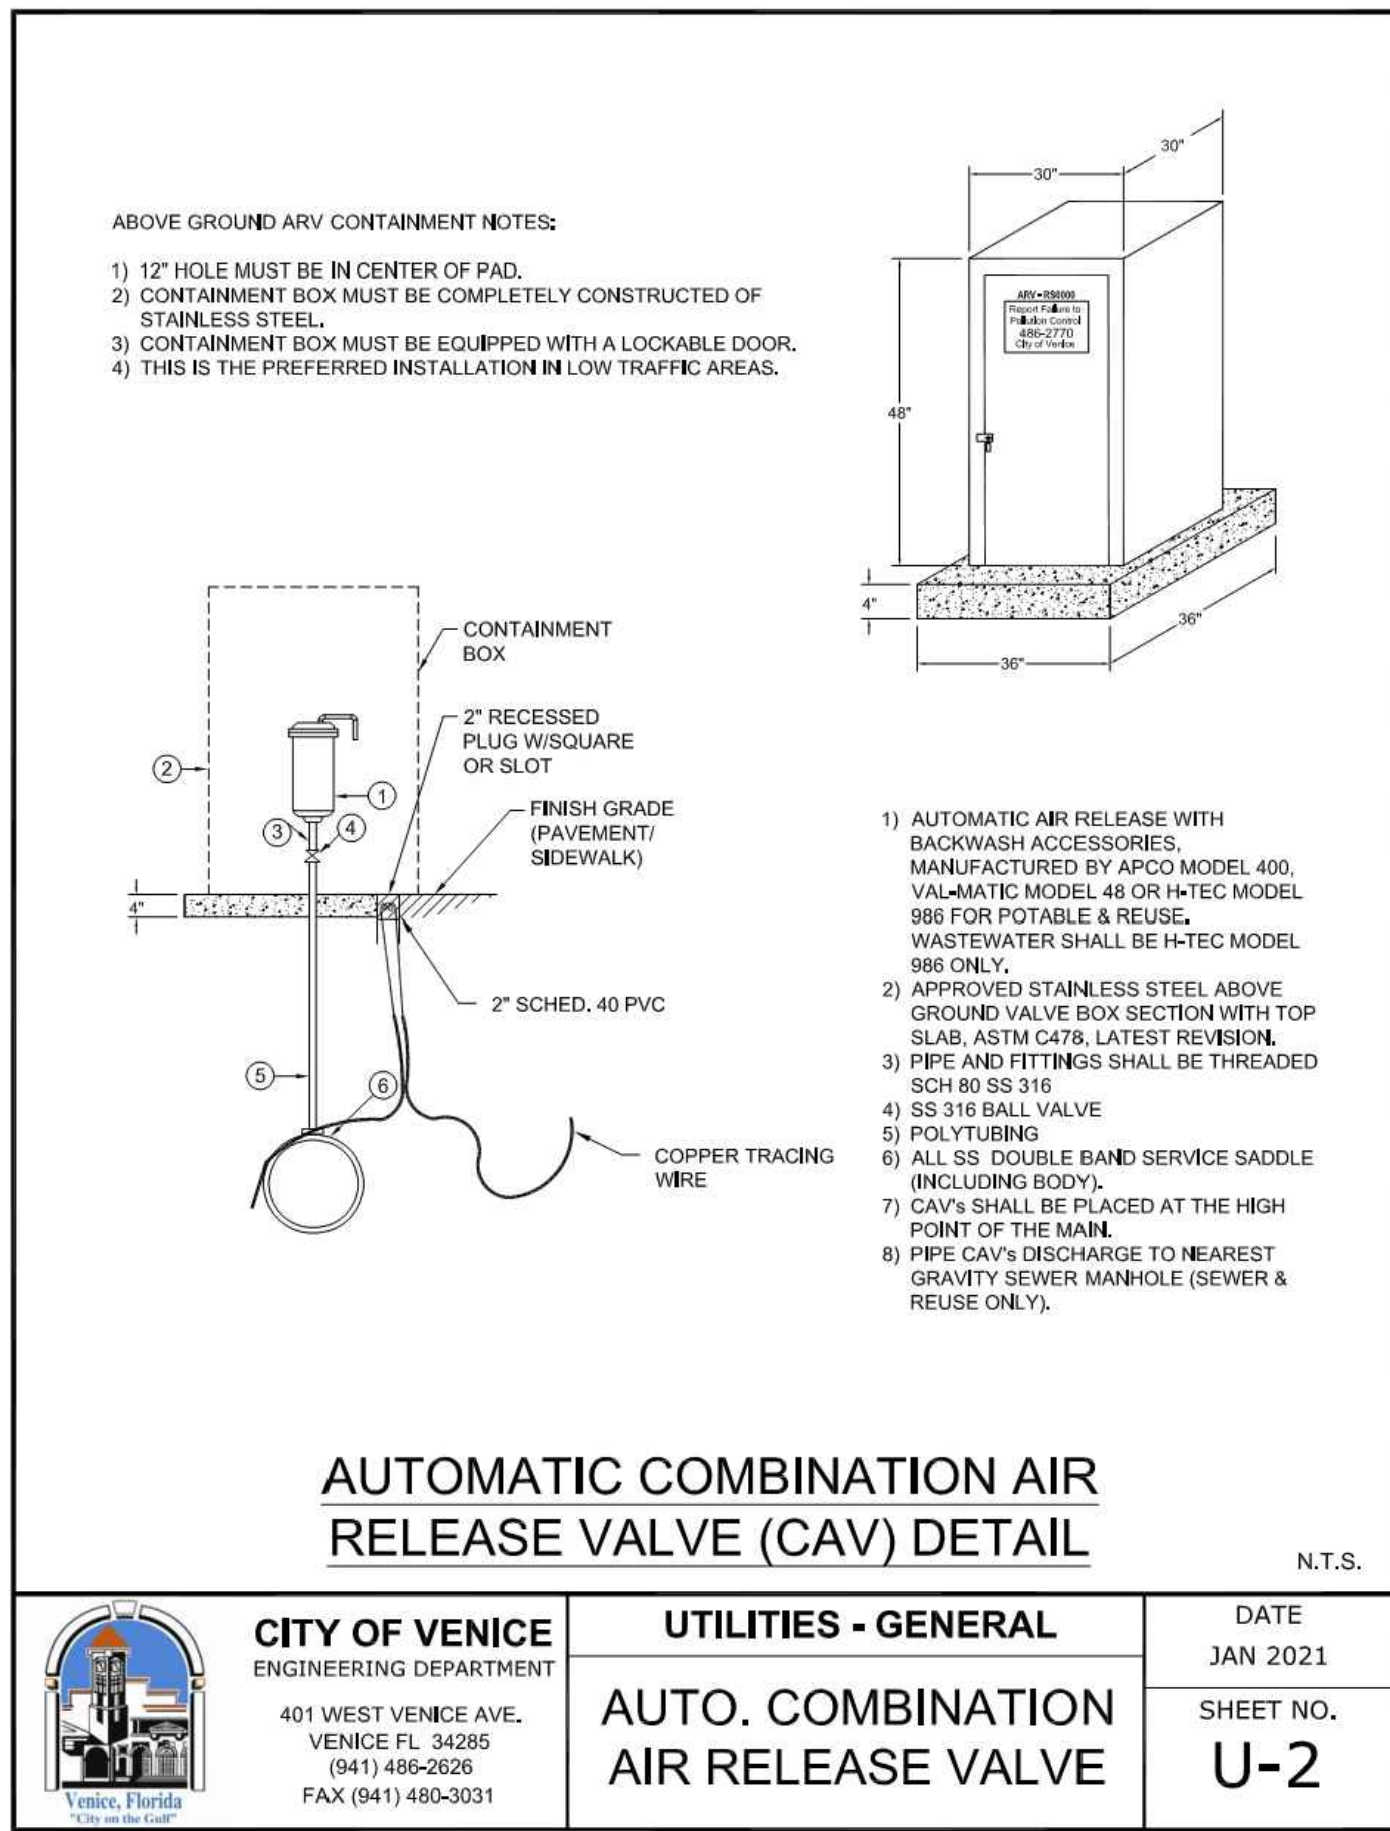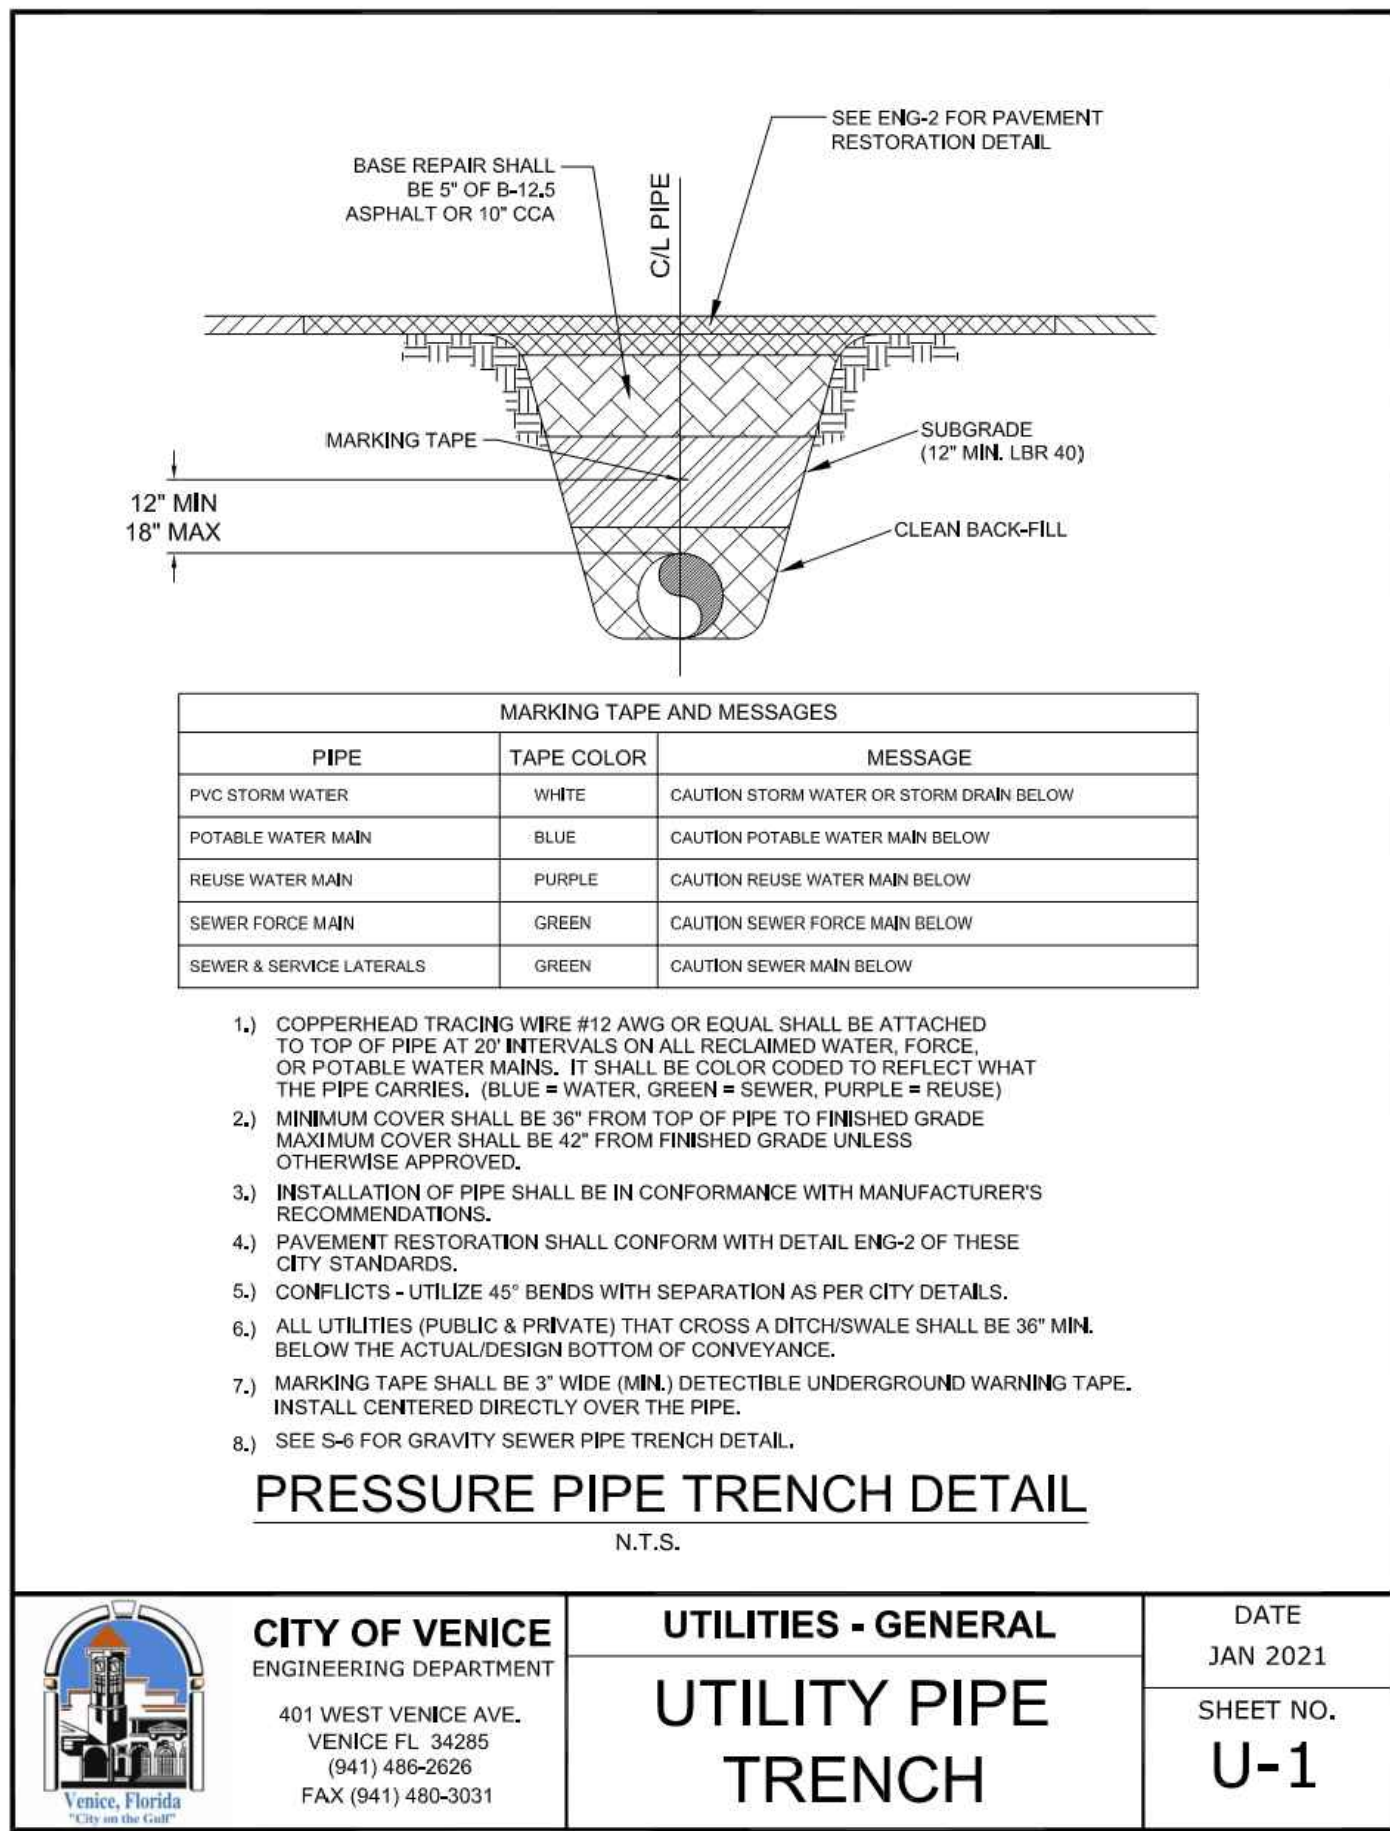

05-17-2021	INITIAL SUBMITTAL	JAS
DATE	DESCRIPTION	BY
	REVISIONS	








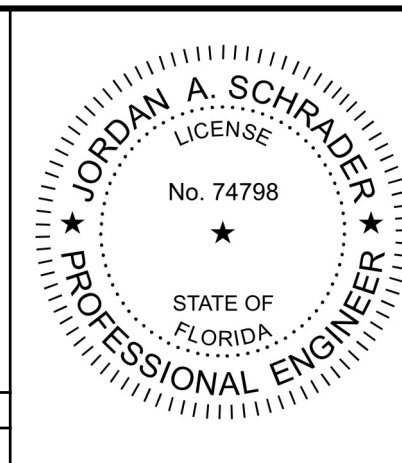


Clearview
LAND DESIGN, P.L.
Engineering Business C.A. No.: 28898
3010 W Azeele St., Suite 150, Tampa, Florida 33609
Office: 813-223-3919 Fax: 813-223-3975

This item has been digitally signed and sealed by JORDAN A. SCHRADER, P.E. on the date adjacent to the seal. Printed copies of this document are not considered signed and sealed and the signature must be verified on any electronic copies.


DATE: 06/03/2025
JORDAN A. SCHRADER, P.E. NO. 74798
FLORIDA PROFESSIONAL ENGINEER

GENERAL UTILITY DETAILS	
JOB NO. JEN-RU-008	RUSTIC ROAD NORTH PHASES 1 & 2
DRAWN FERREIRA	PREPARED FOR: JEN TAMP A 1, LLC. C/O BANYAN LAND CAPITAL, LLC.
DATE 06-03-2025	Elevations based on North American Vertical Datum 1988 (NAVD 88) Conversion from NAVD 88 to NGVD 29 = +1.11 Feet
FILE WSD	SHEET 66 OF 71 SHEETS

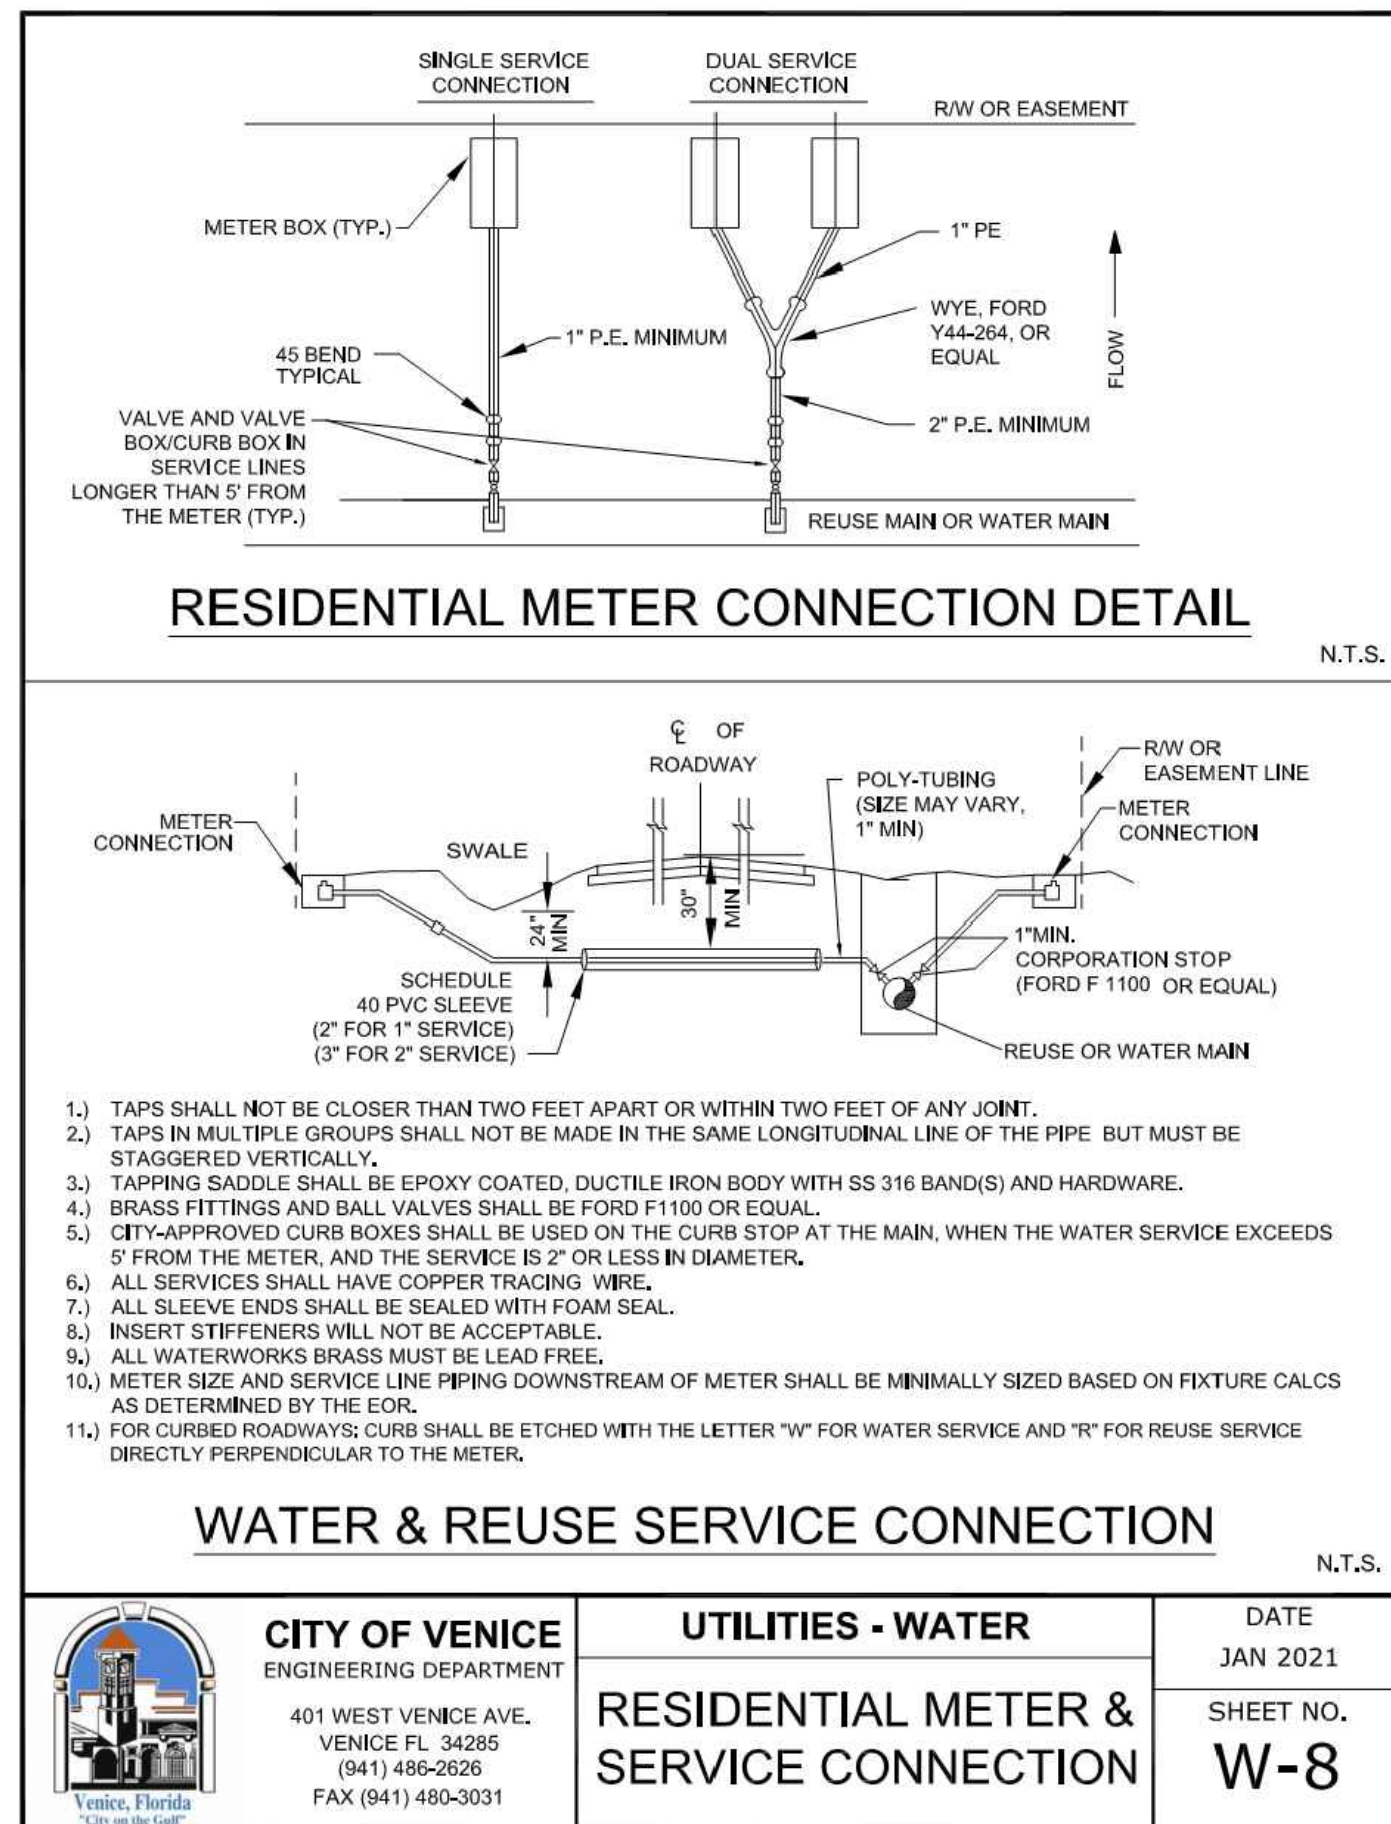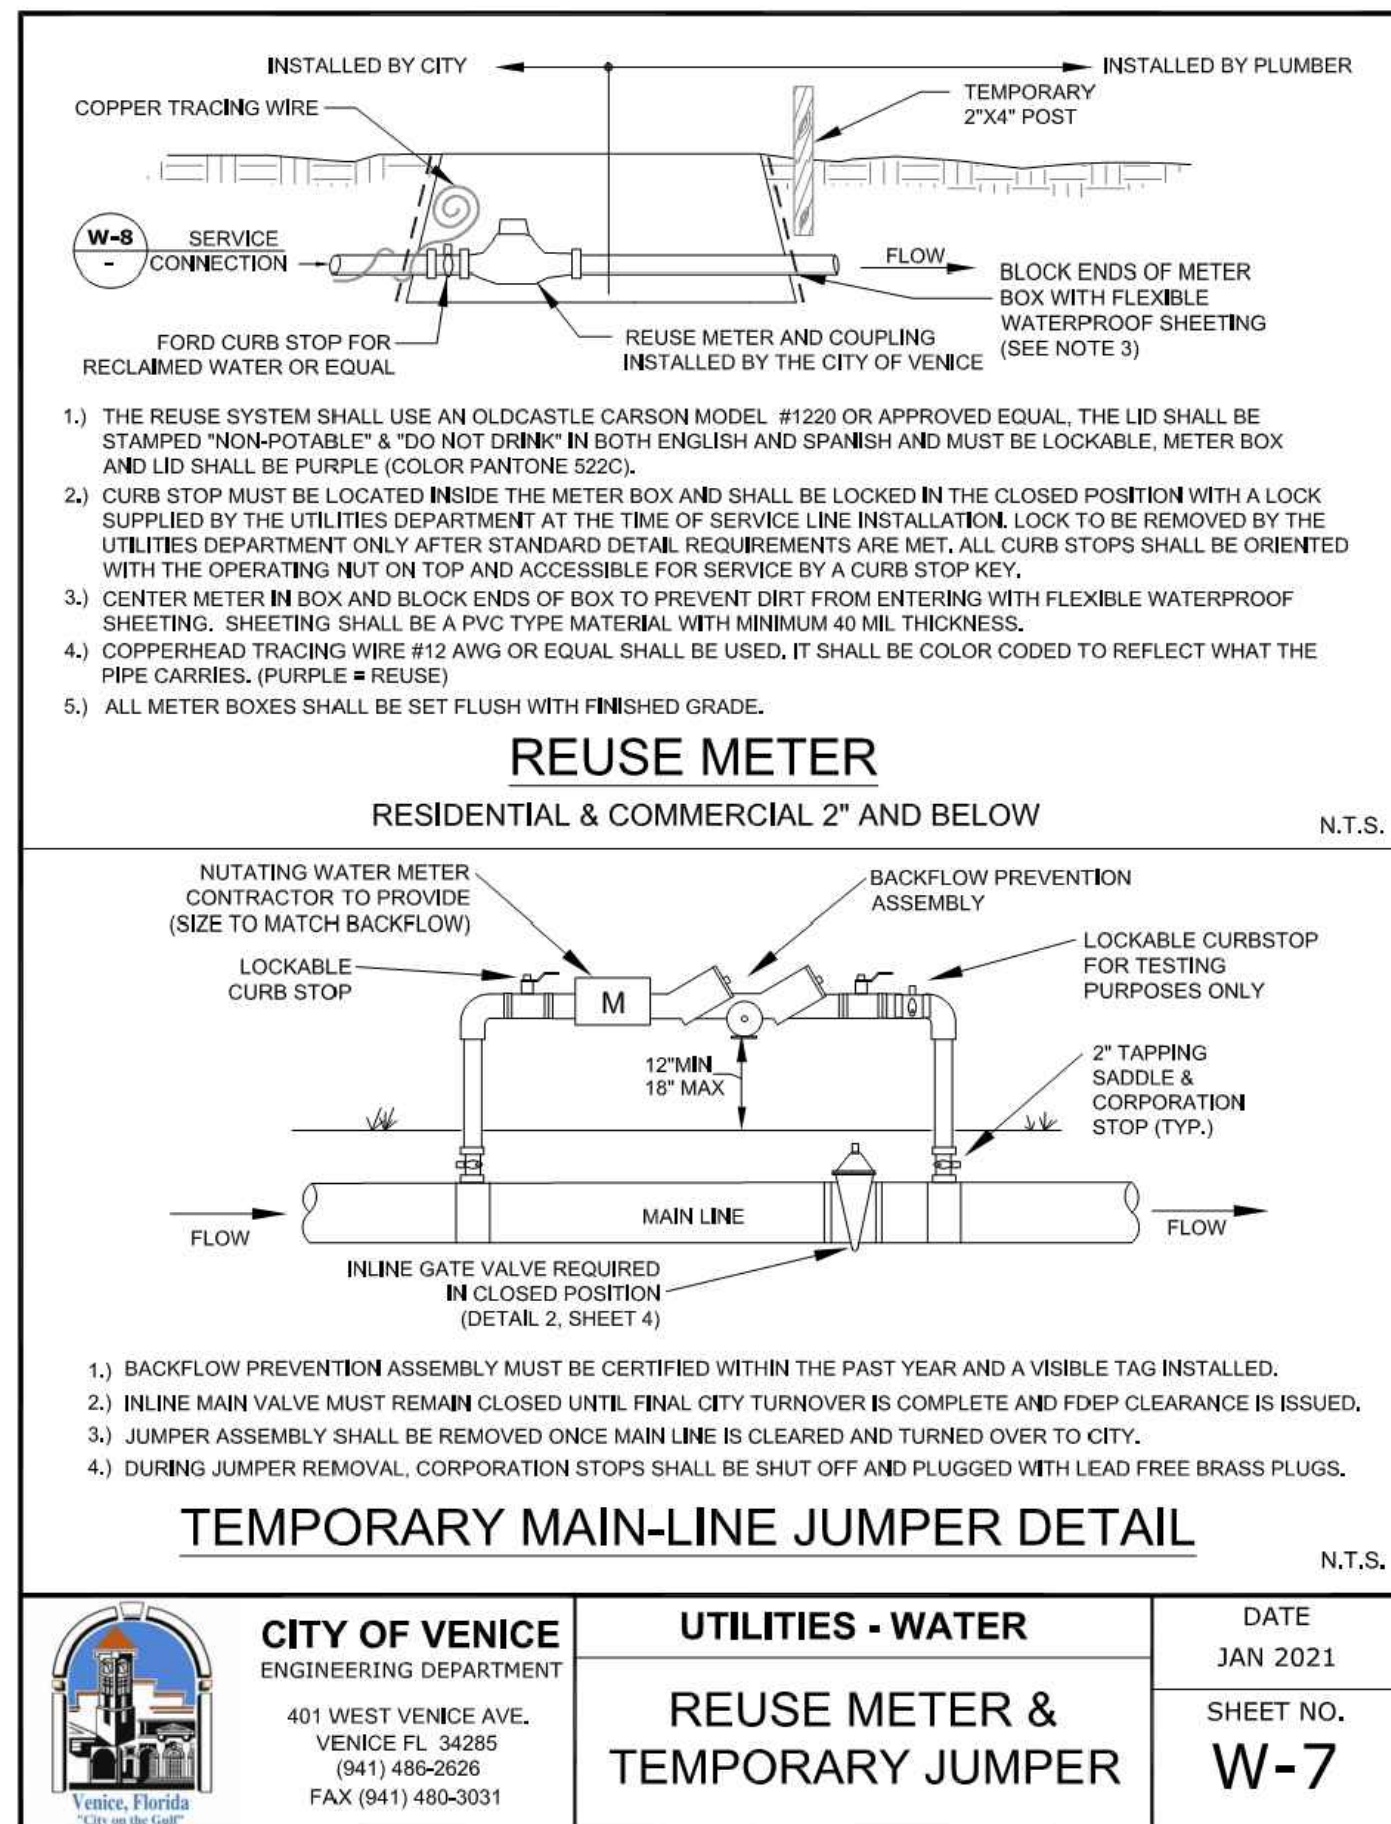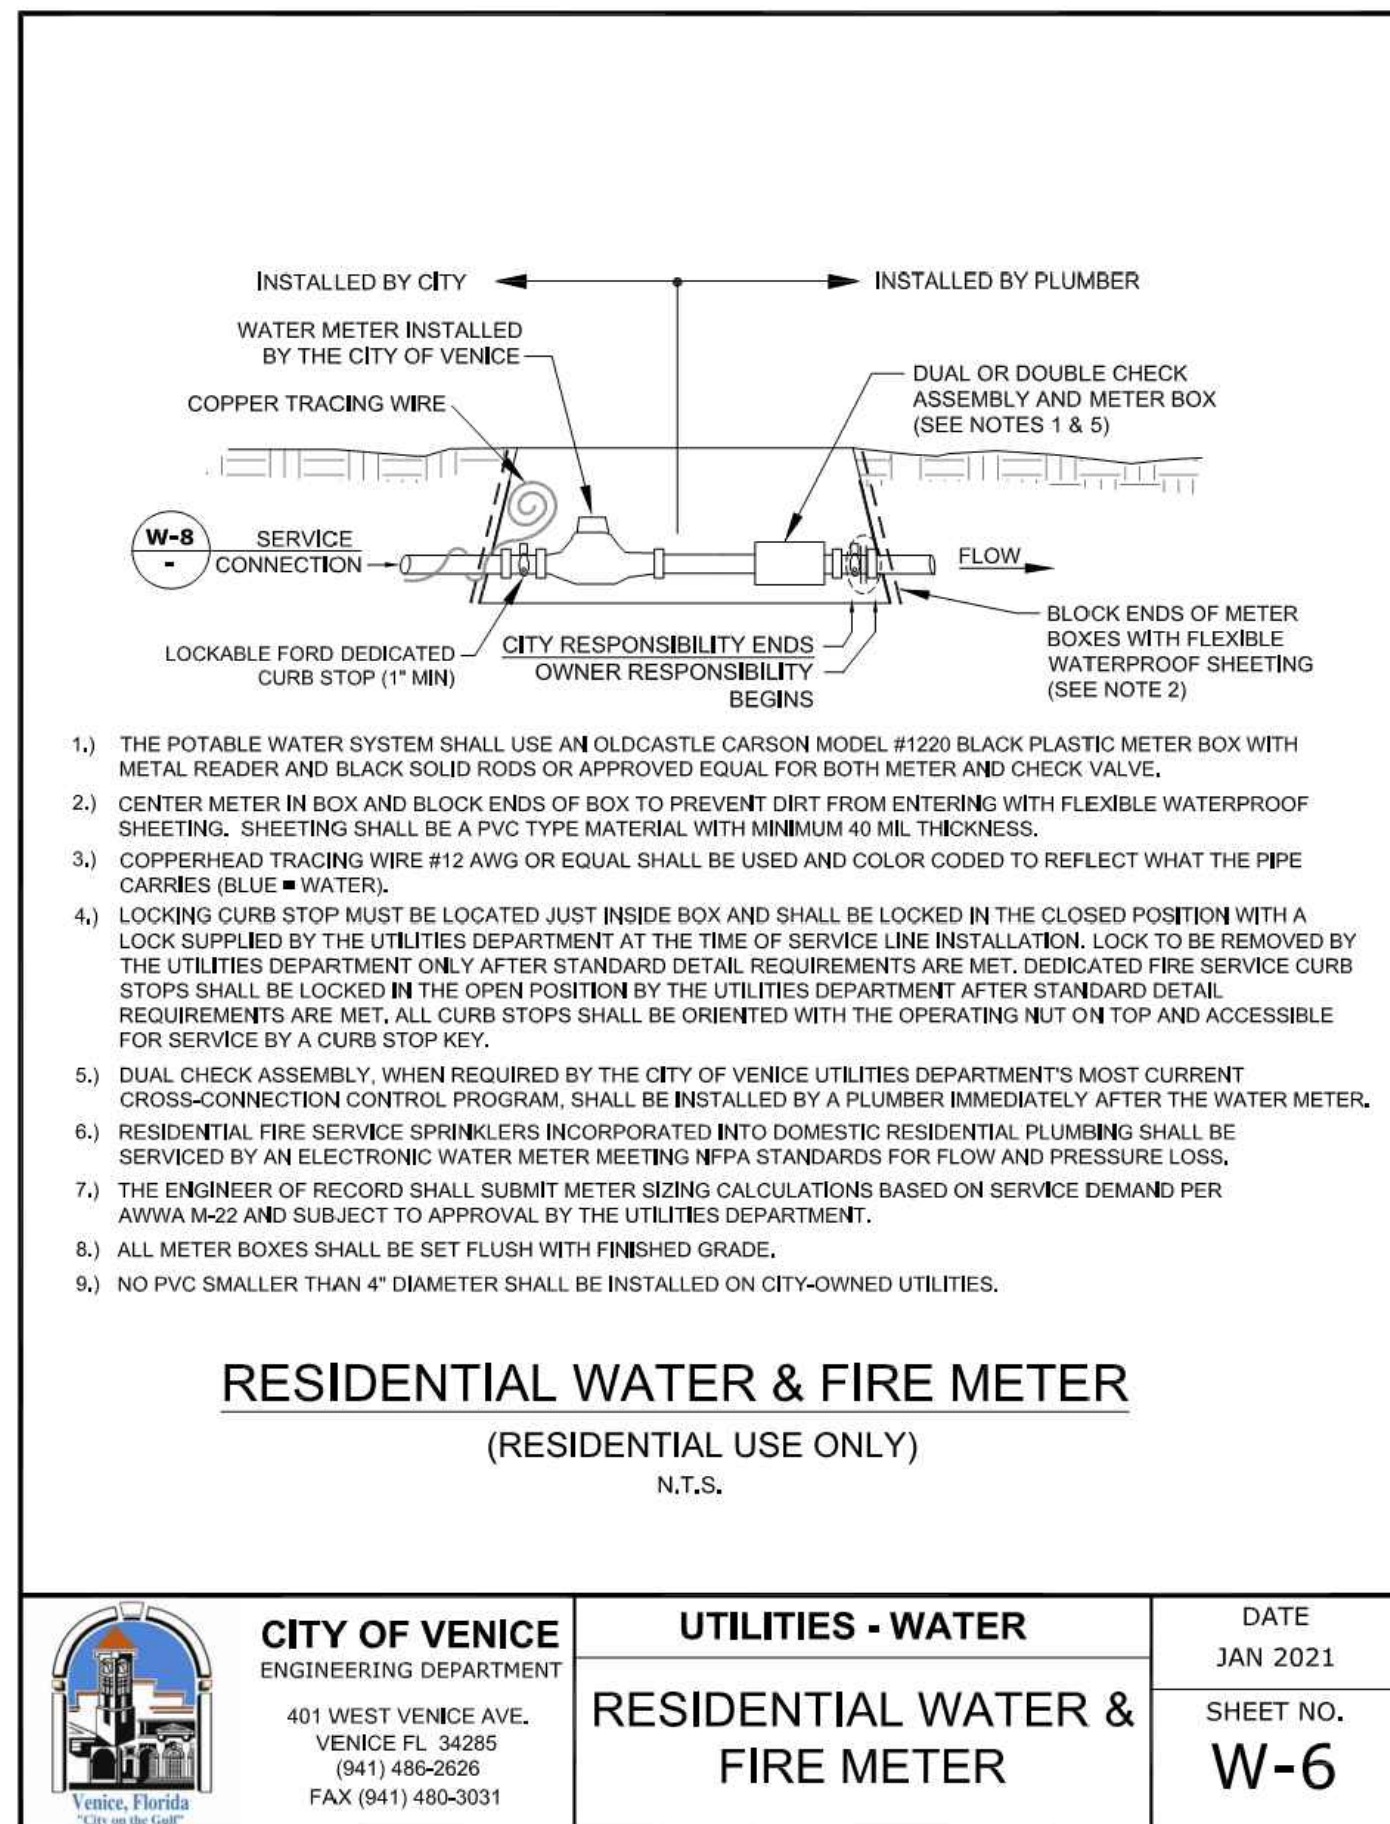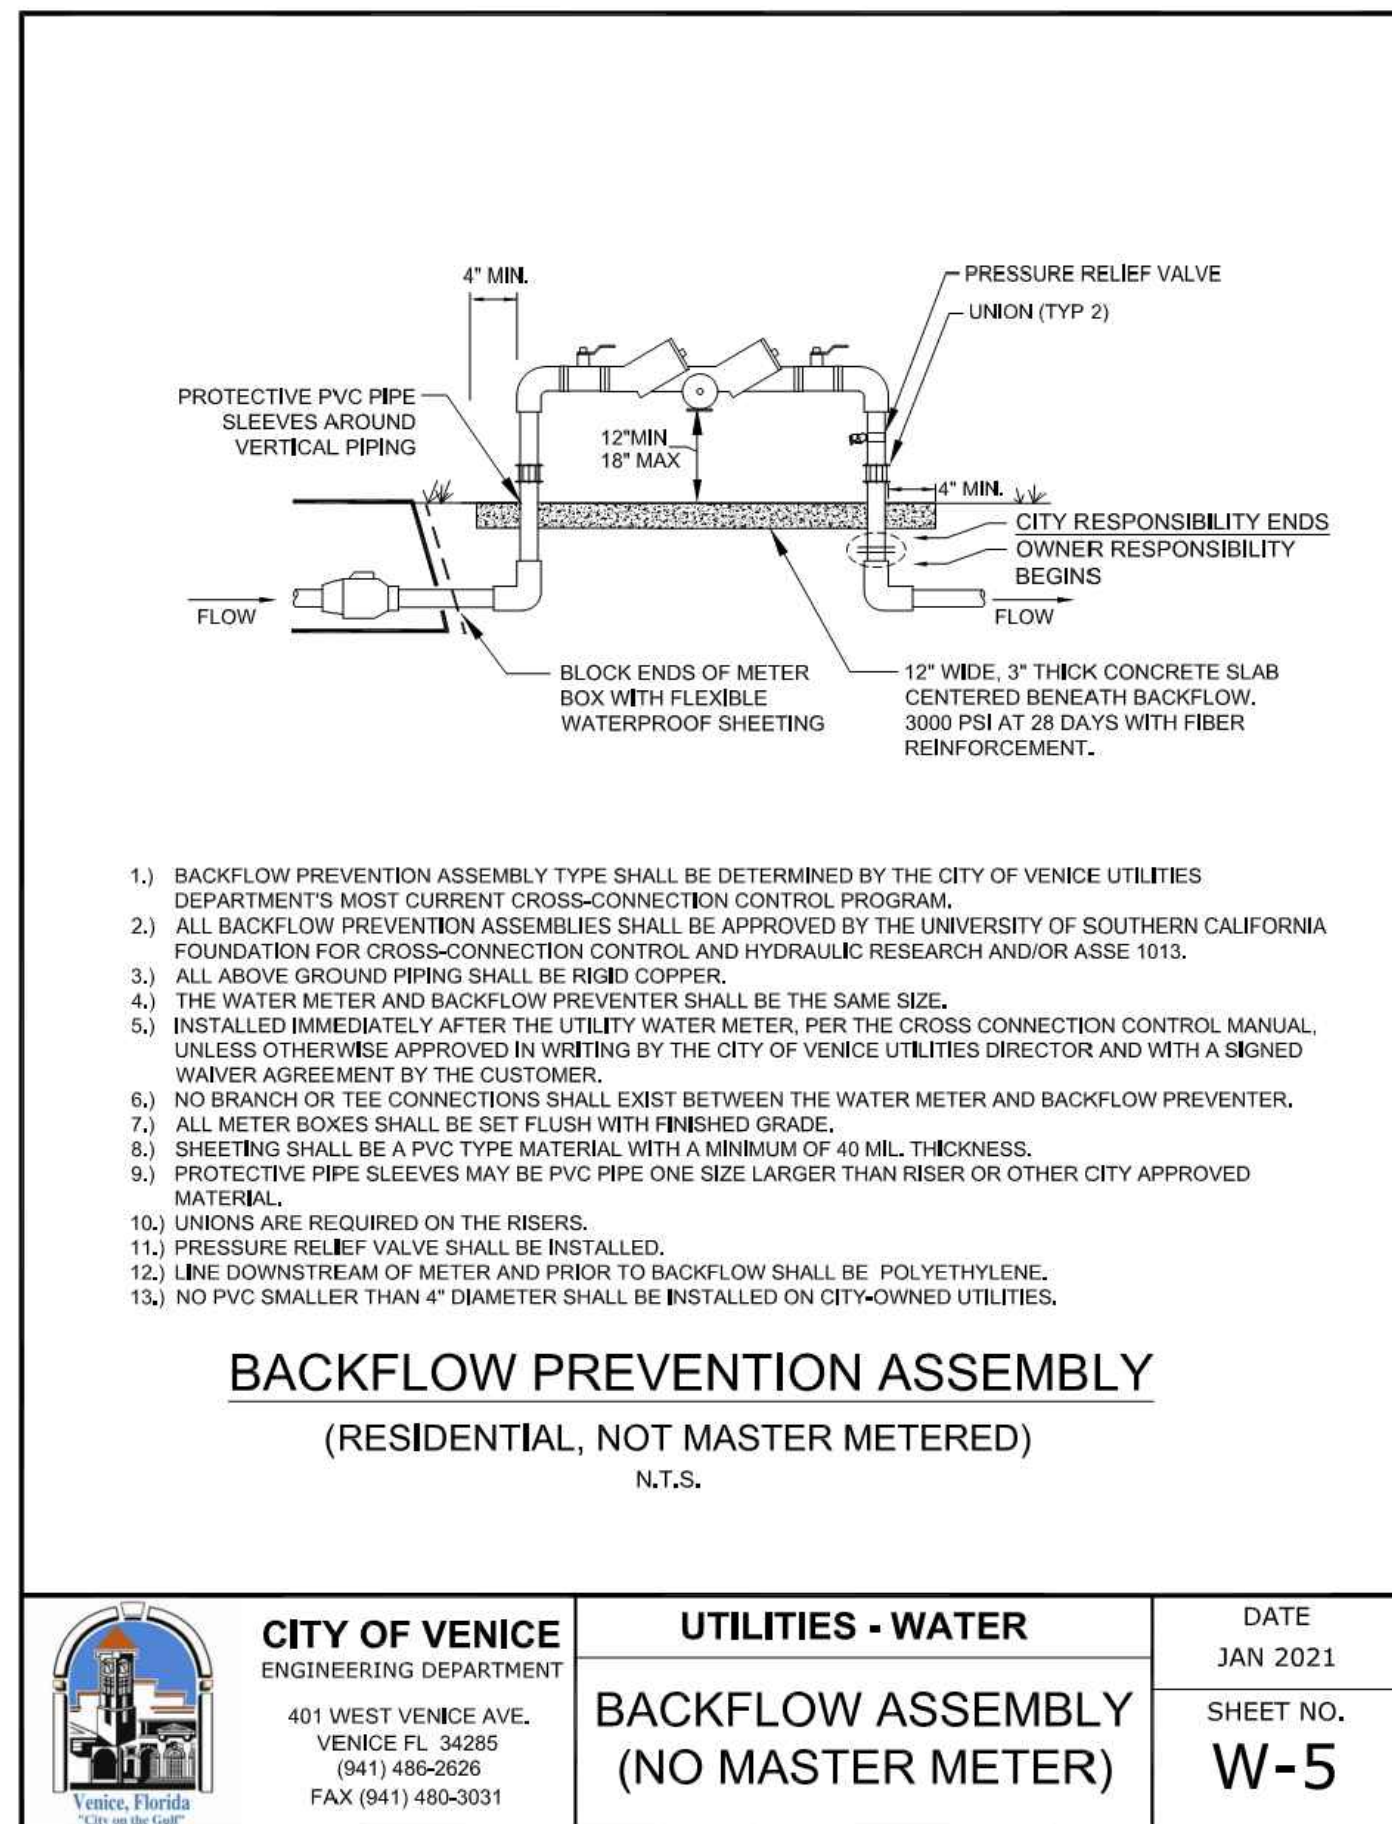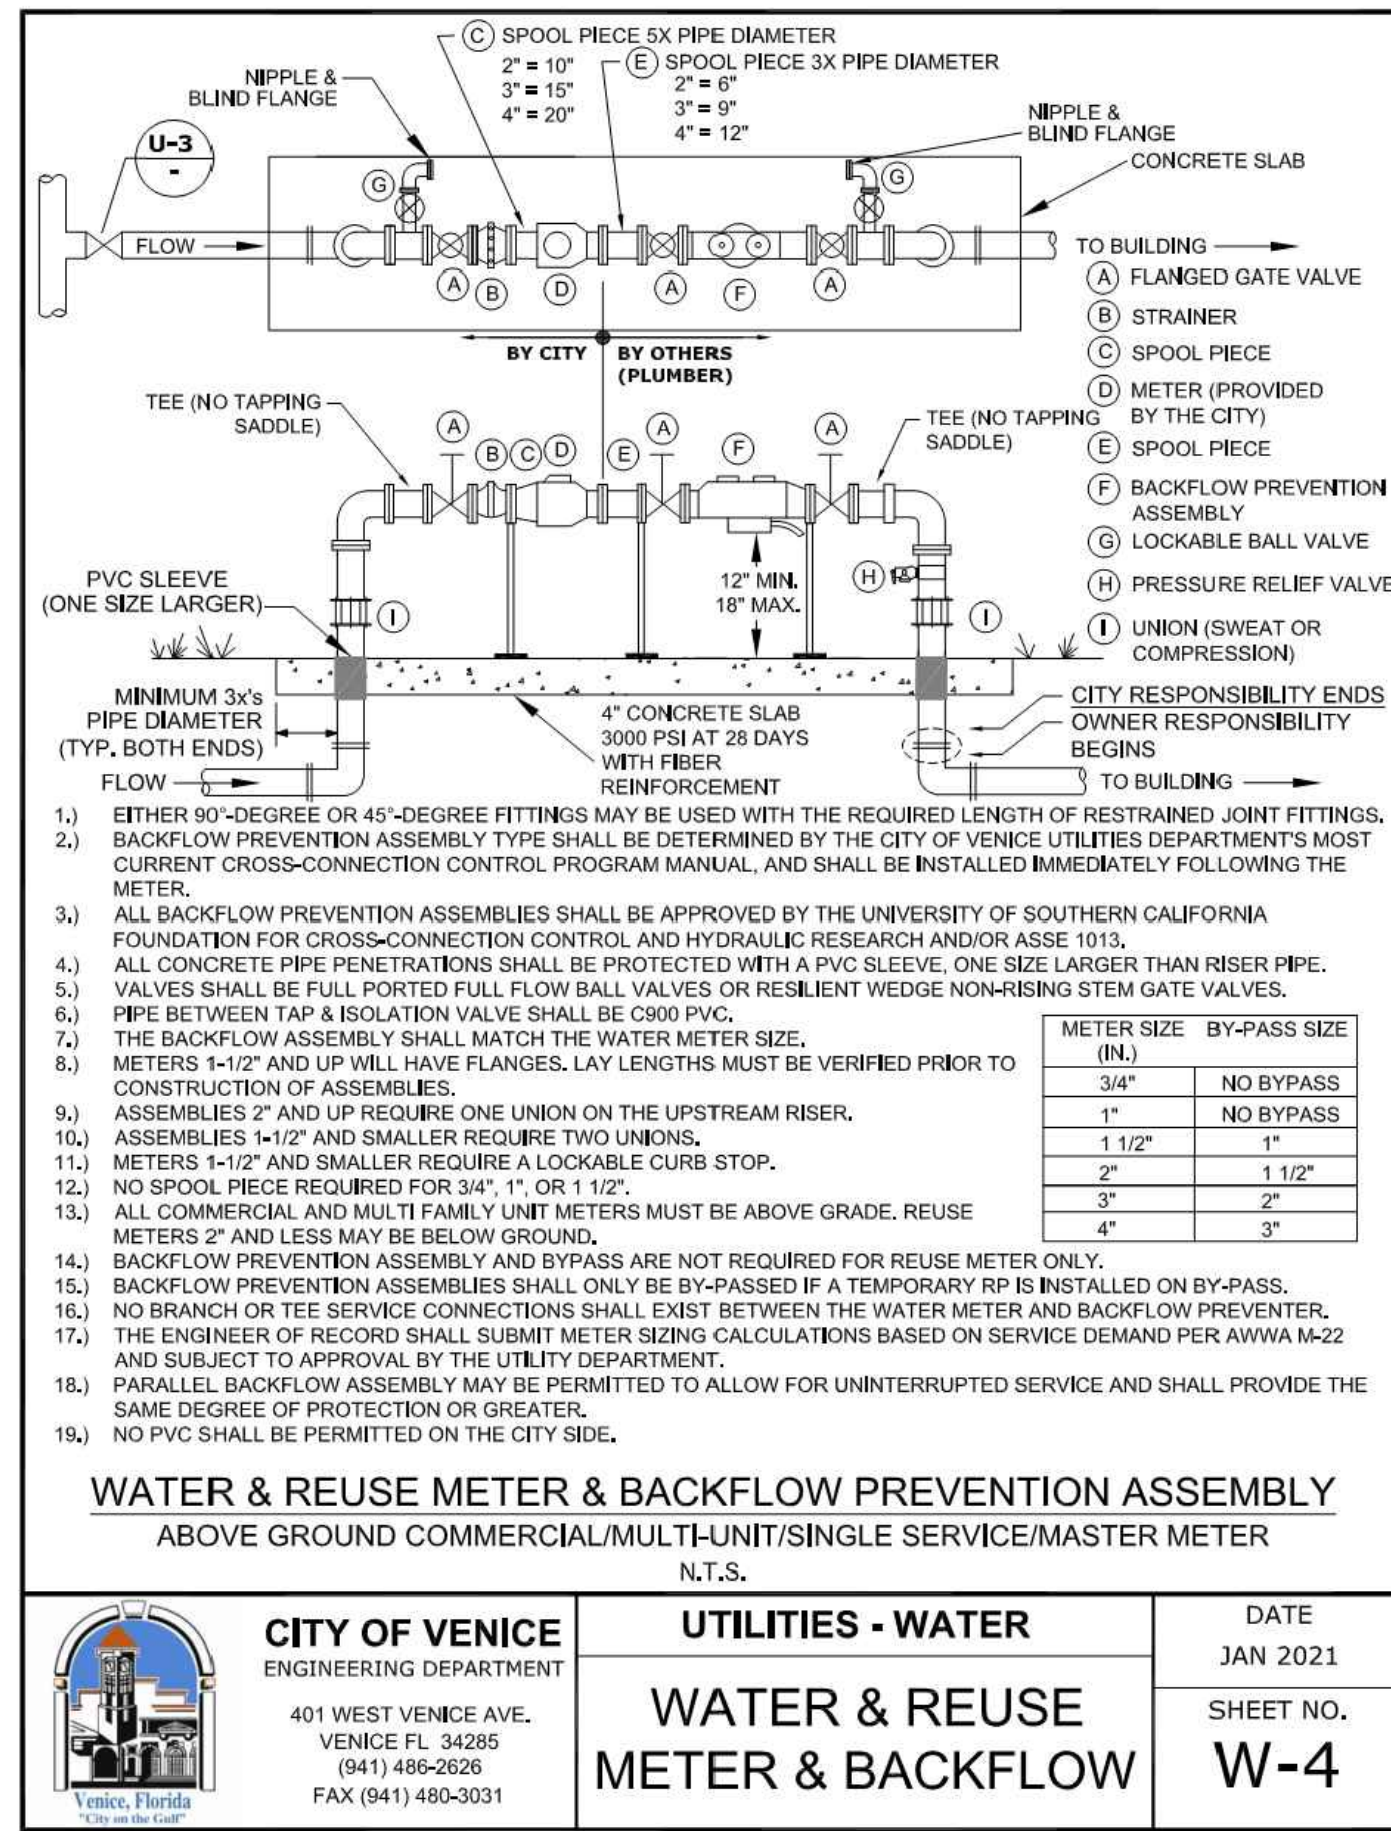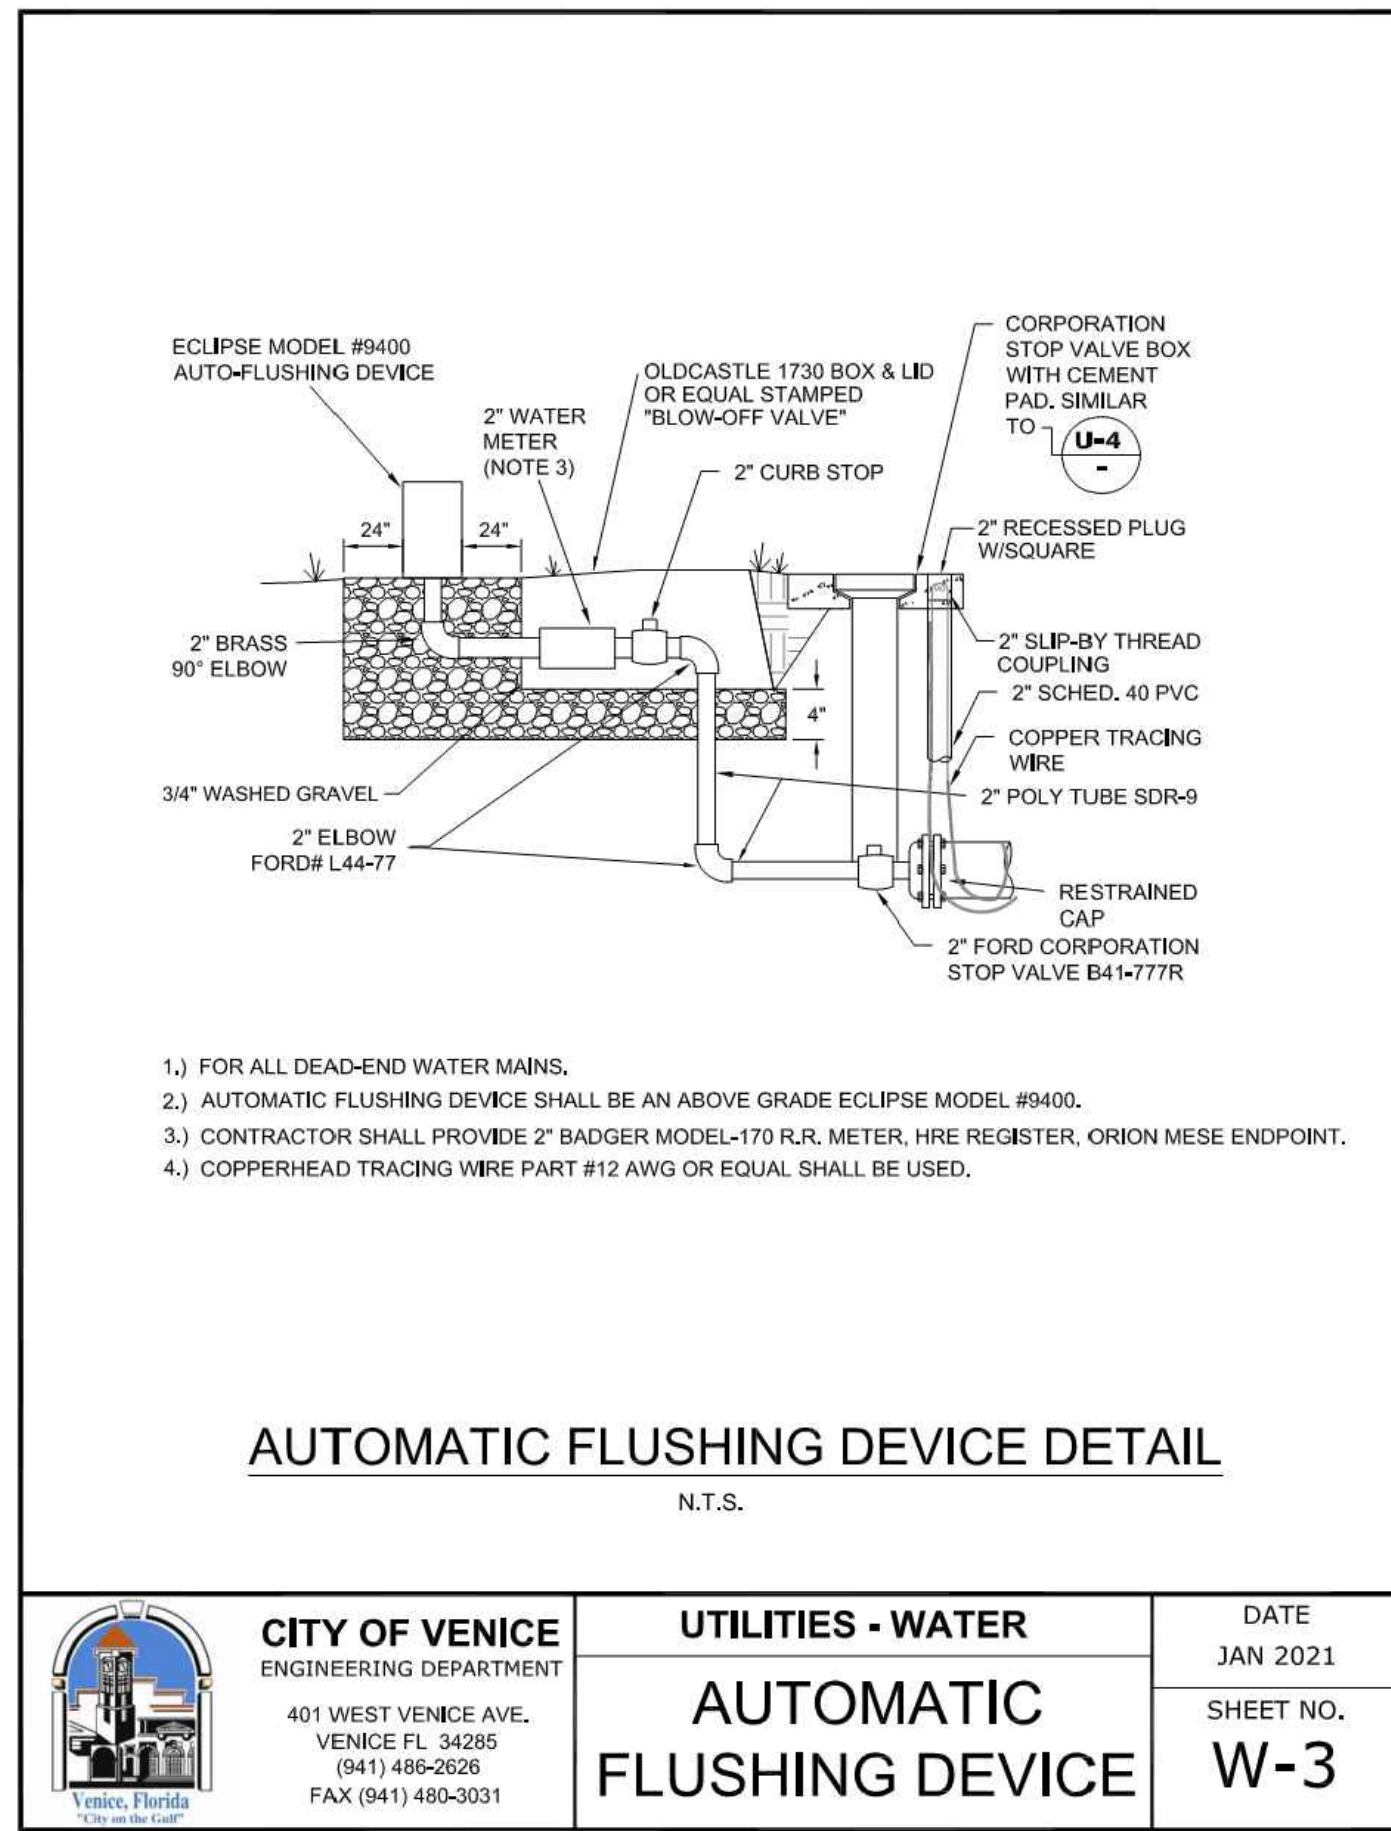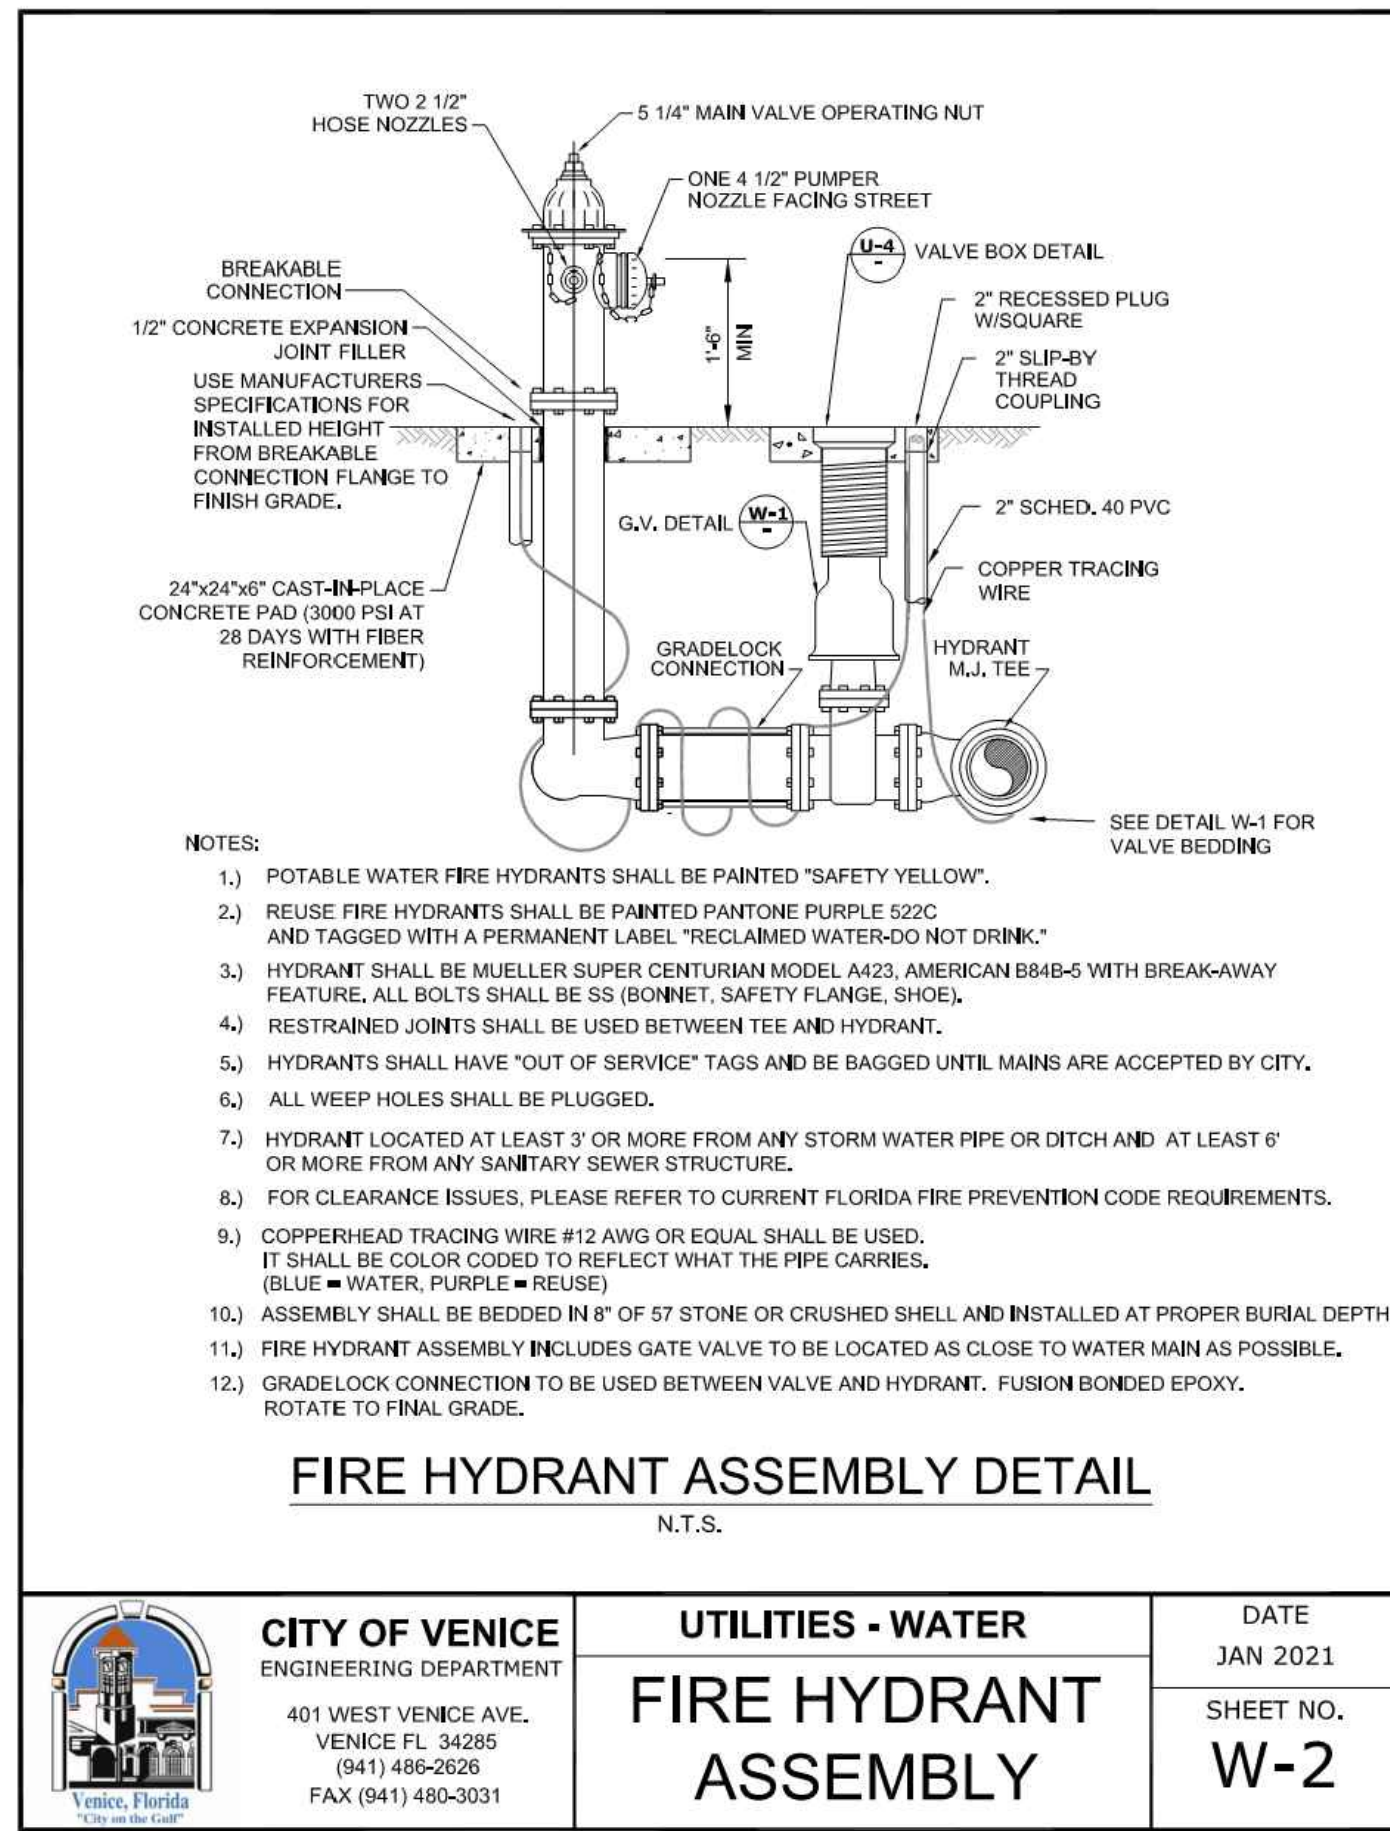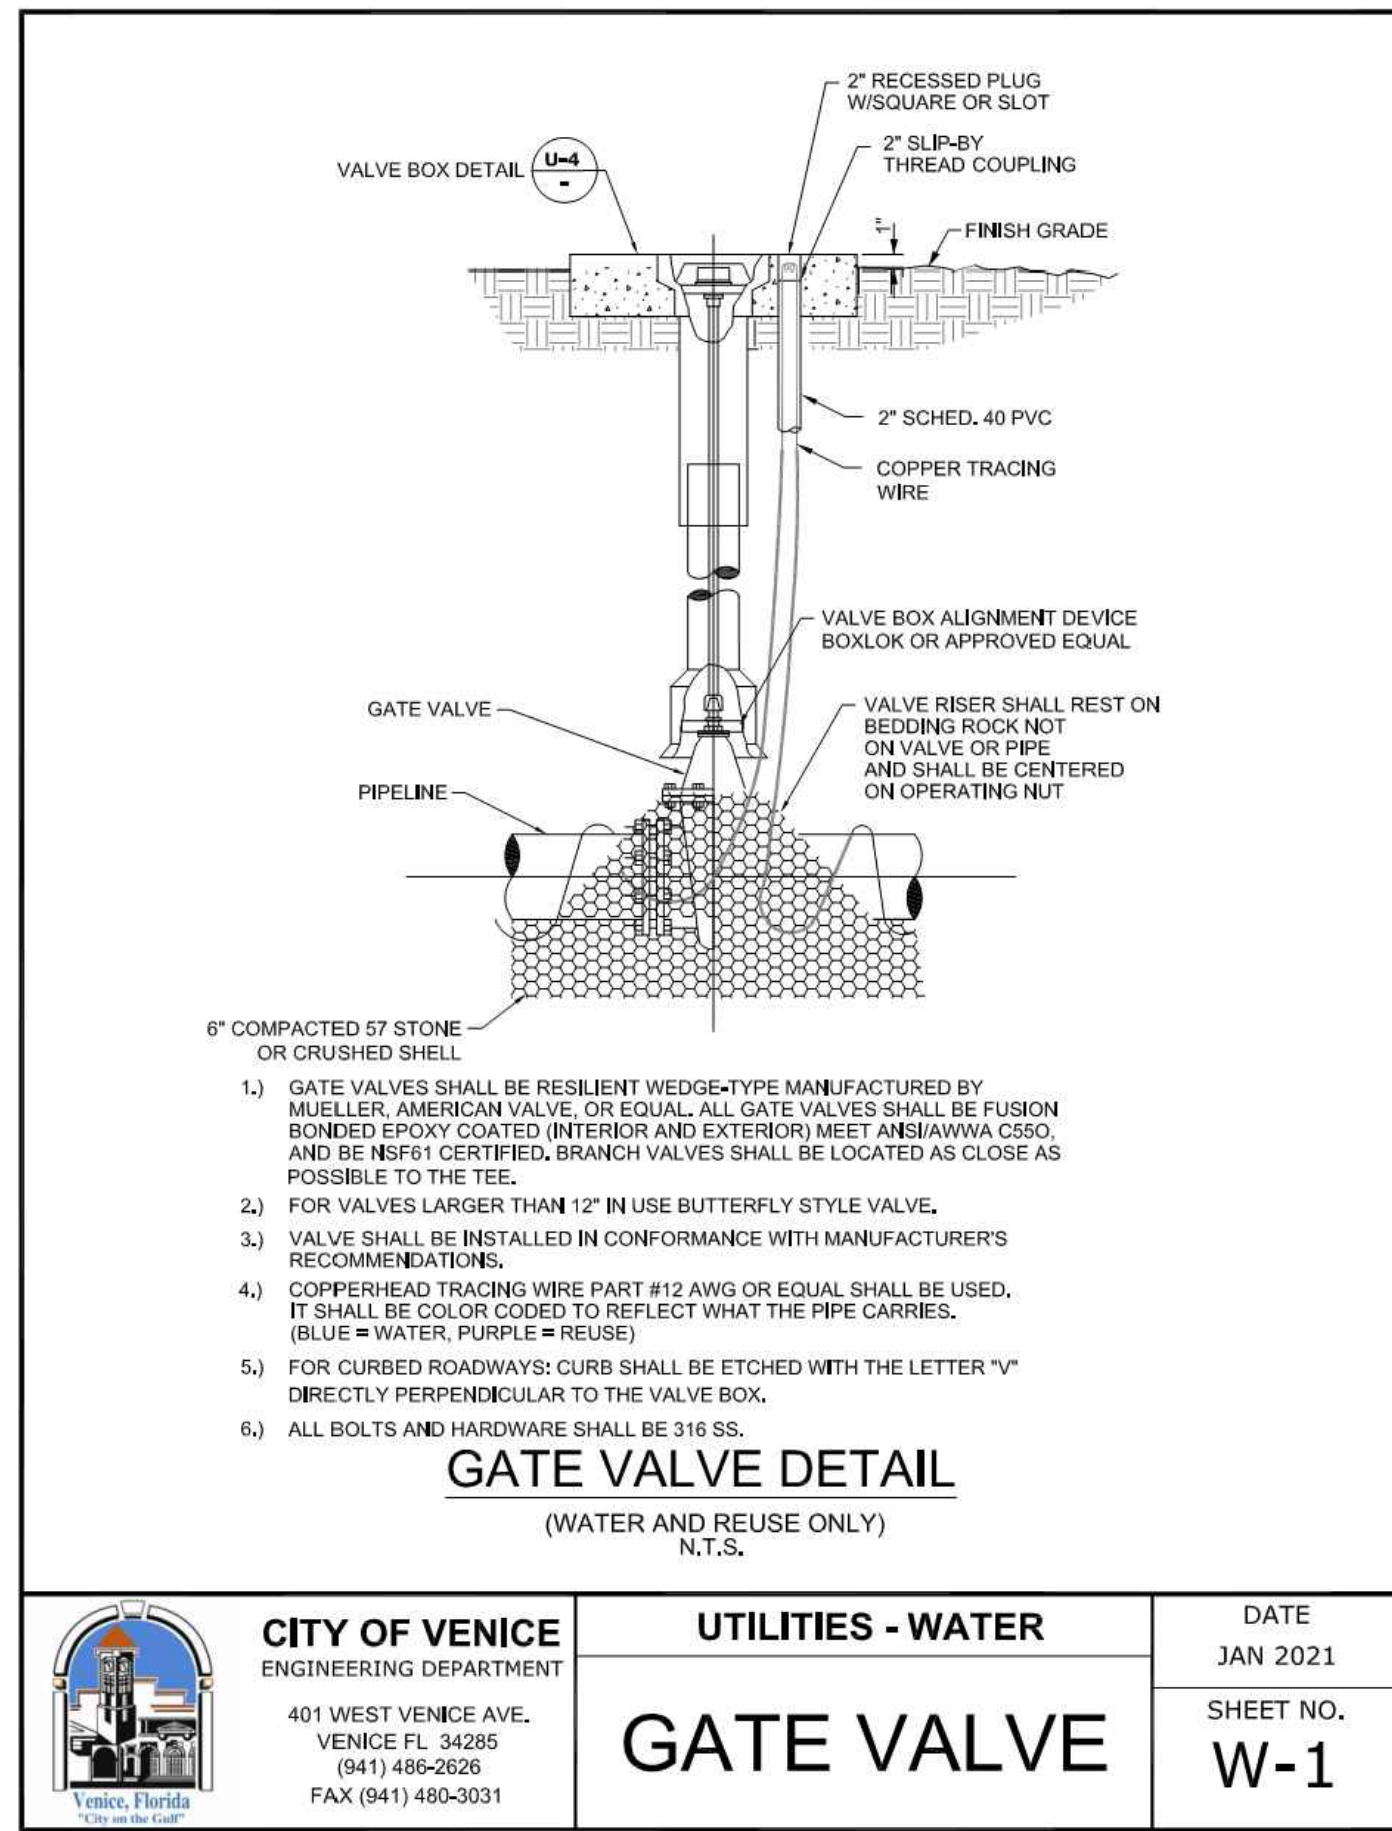





RECORD DRAWINGS
August 29, 2025
APPROVED

05-17-2021	INITIAL SUBMITTAL	JAS
DATE	DESCRIPTION	BY
	REVISIONS	


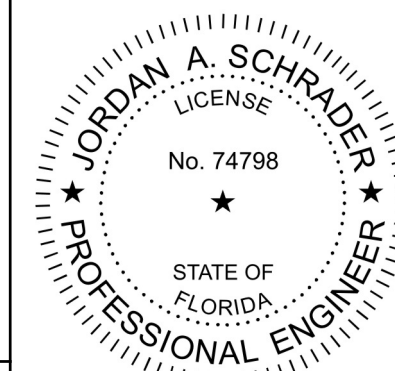


Clearview LAND DESIGN, P.L. Engineering Business C.A. No.: 28898 3010 W. Azalea St., Suite 150, Tampa, Florida 33609 Office: 813-223-3919 Fax: 813-223-3975	
This item has been digitally signed and sealed by JORDAN A. SCHRADER, P.E. on the date adjacent to the seal. Printed copies of this document are not considered signed and sealed and the signature must be verified on any electronic copies.	
DATE: 06/03/2025	JORDAN A. SCHRADER, P.E. NO. 74798 FLORIDA PROFESSIONAL ENGINEER
POTABLE WATER SYSTEM DETAILS	
JOB NO. JEN-RU-008	DESIGN FERREIRA
DRAWN DUNCAN	DATE 06-03-2025
FILE WSD	
RUSTIC ROAD NORTH PHASES 1 & 2	
JEN TAMPA 1, LLC. C/O BANYAN LAND CAPITAL, LLC.	
Elevations based on North American Vertical Datum 1988 (NAVD 88) Conversion from NAVD 88 to NGVD 29 = +1.11 Feet	
SHEET 67 OF 71 SHEETS	


P:\RUSTIC ROAD NORTH-SP\INSPECTION & CERT\NORTH PH 2\MASTER RECORD SET\WMA CAD\WSD67.dwg POTABLE WATER SYSTEM DETAILS 2025/06/03 1:58 PM CLD ENGINEER

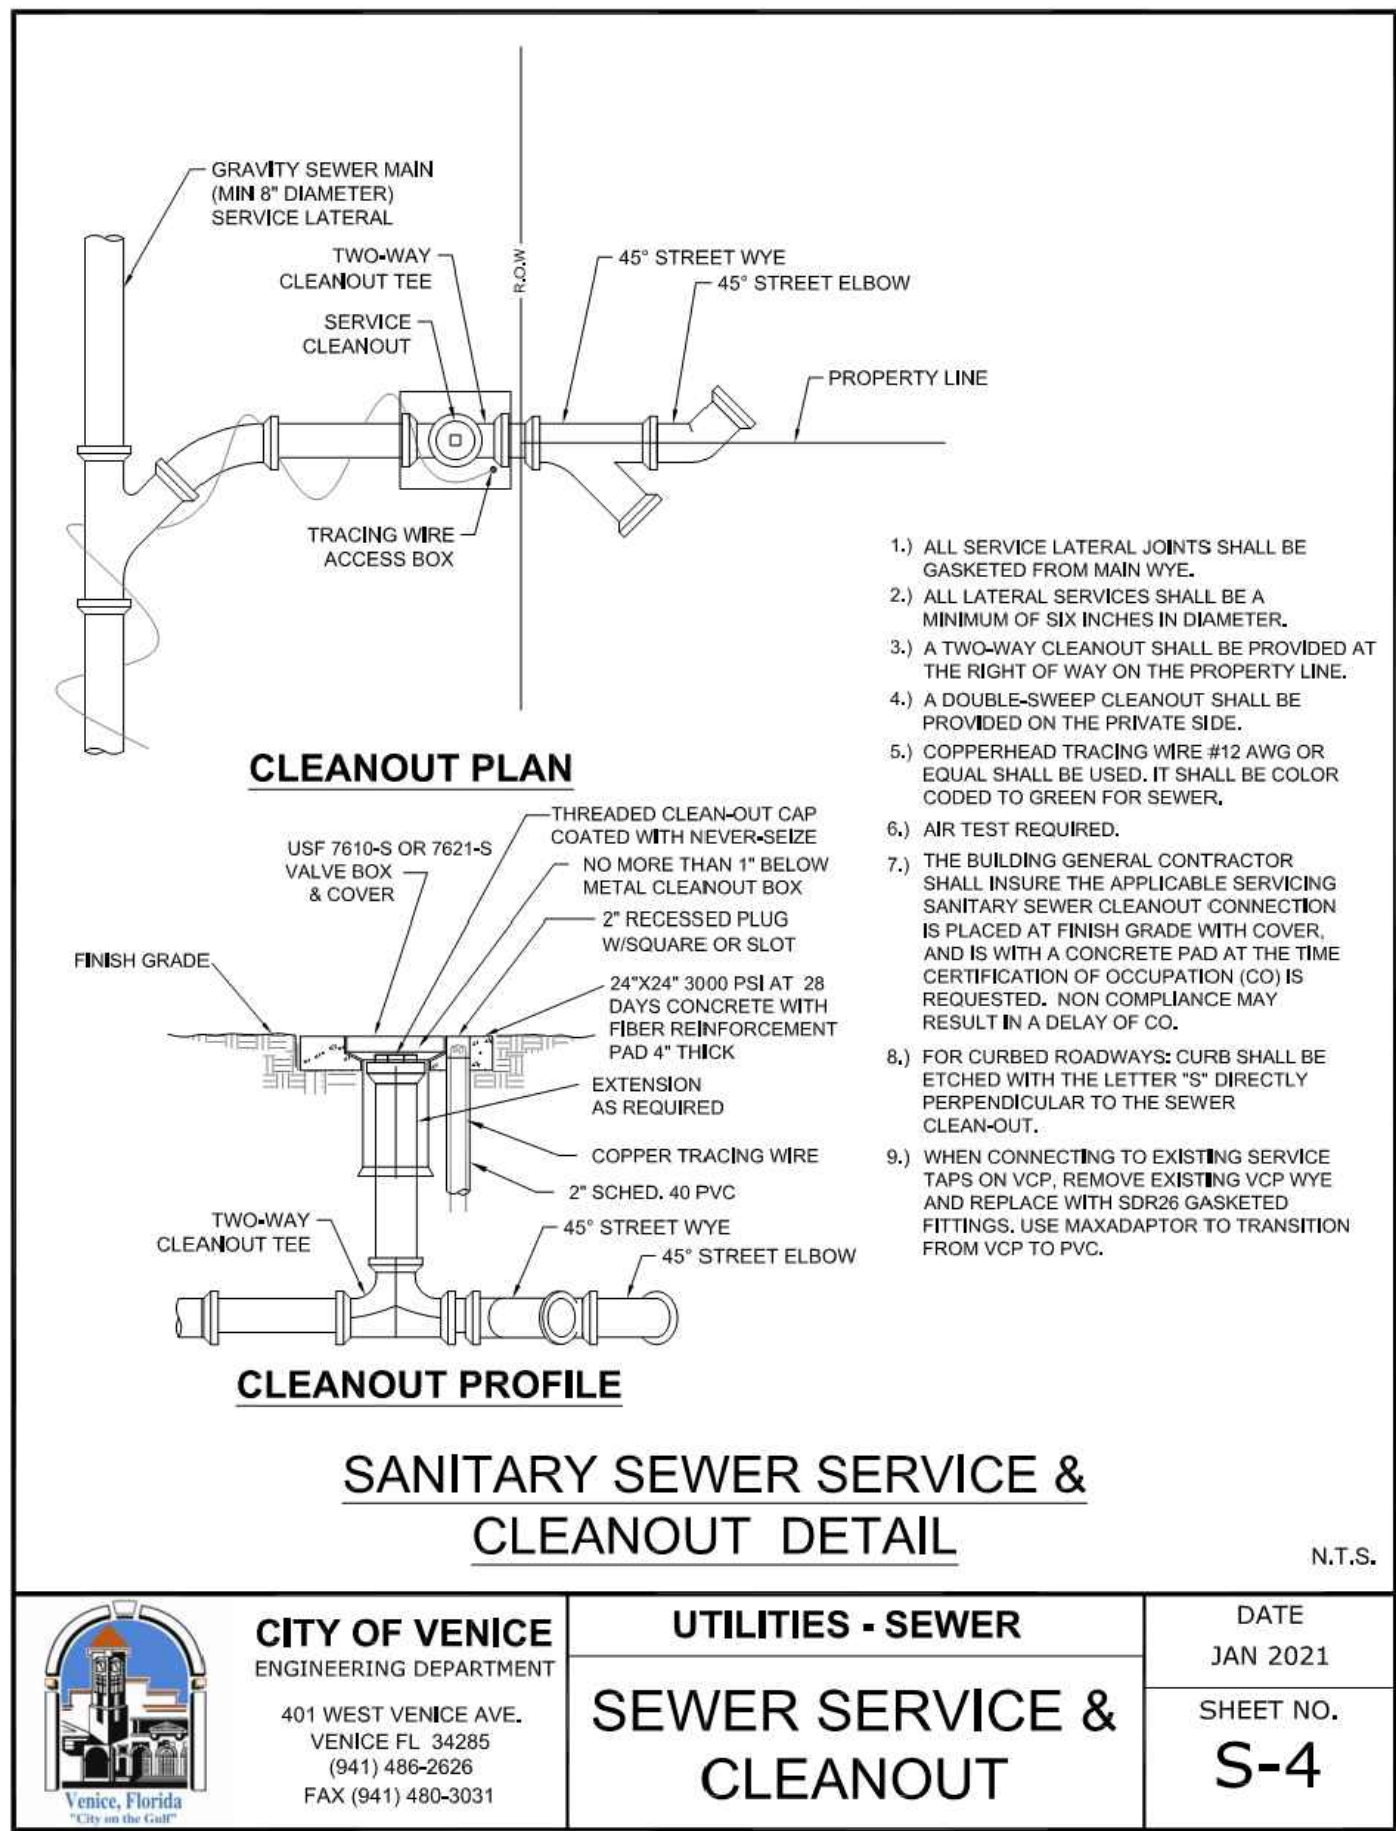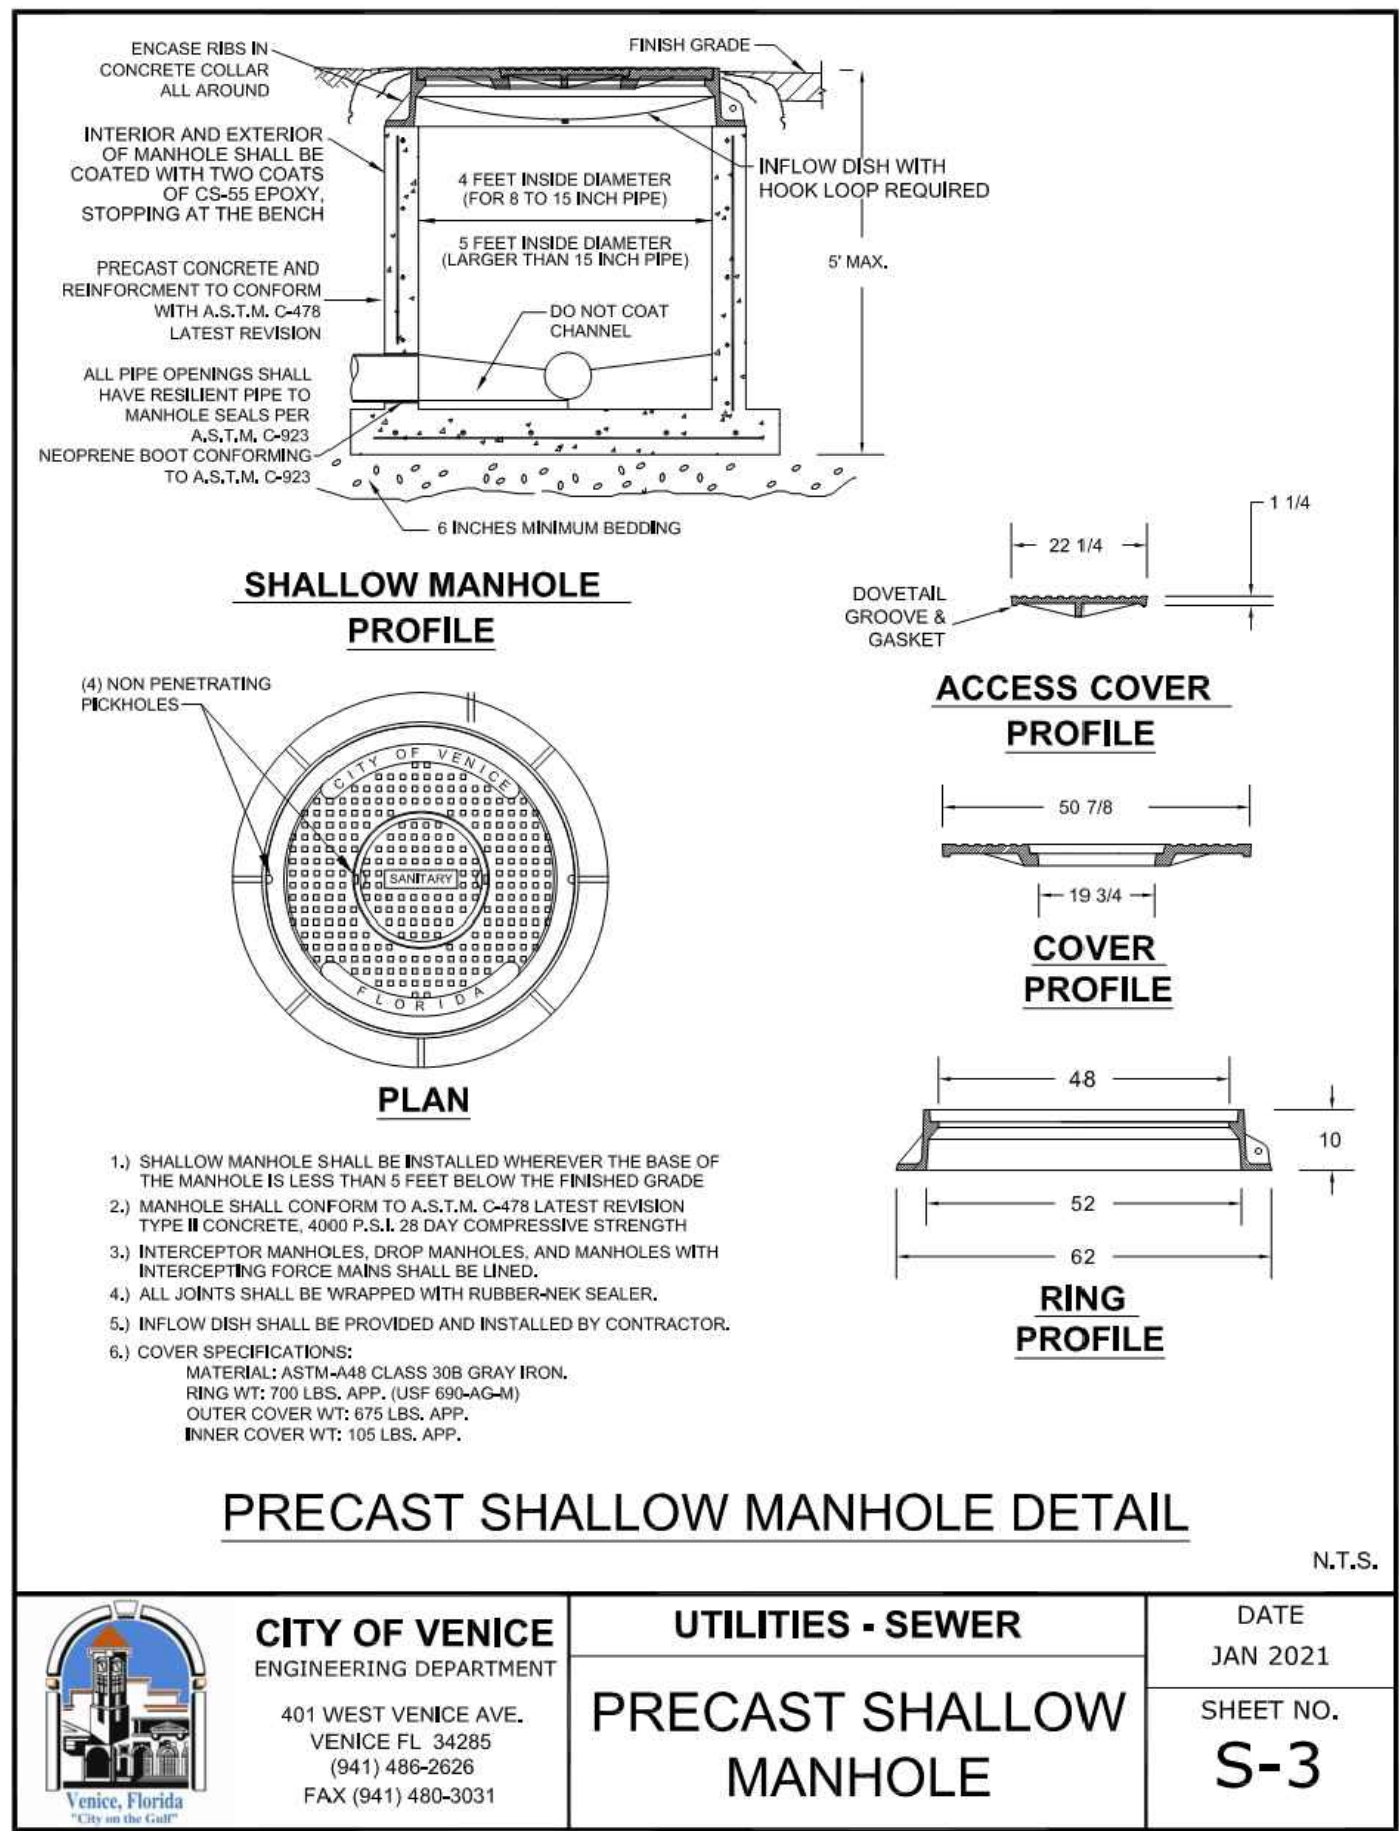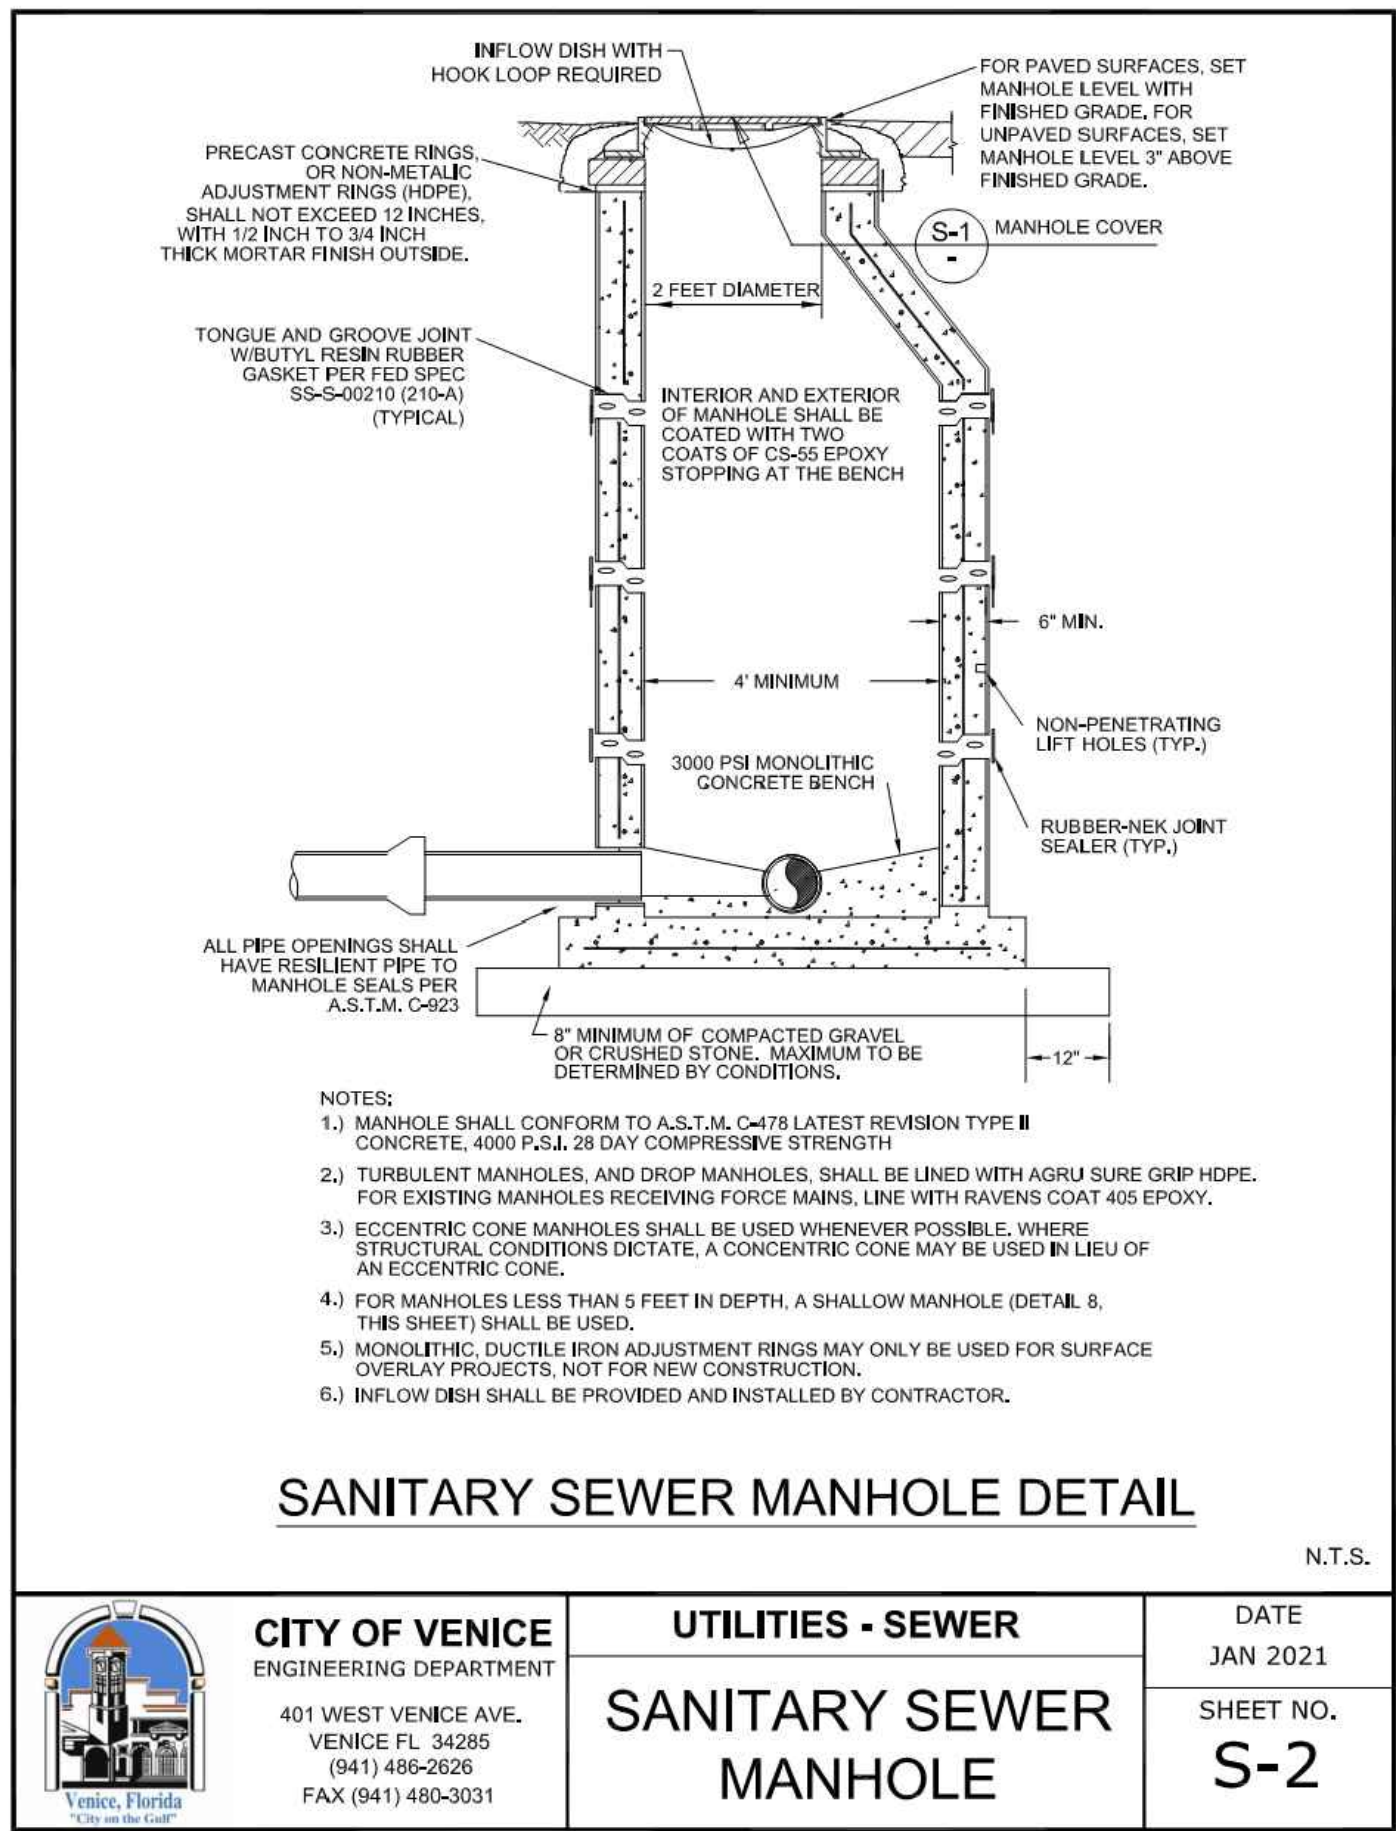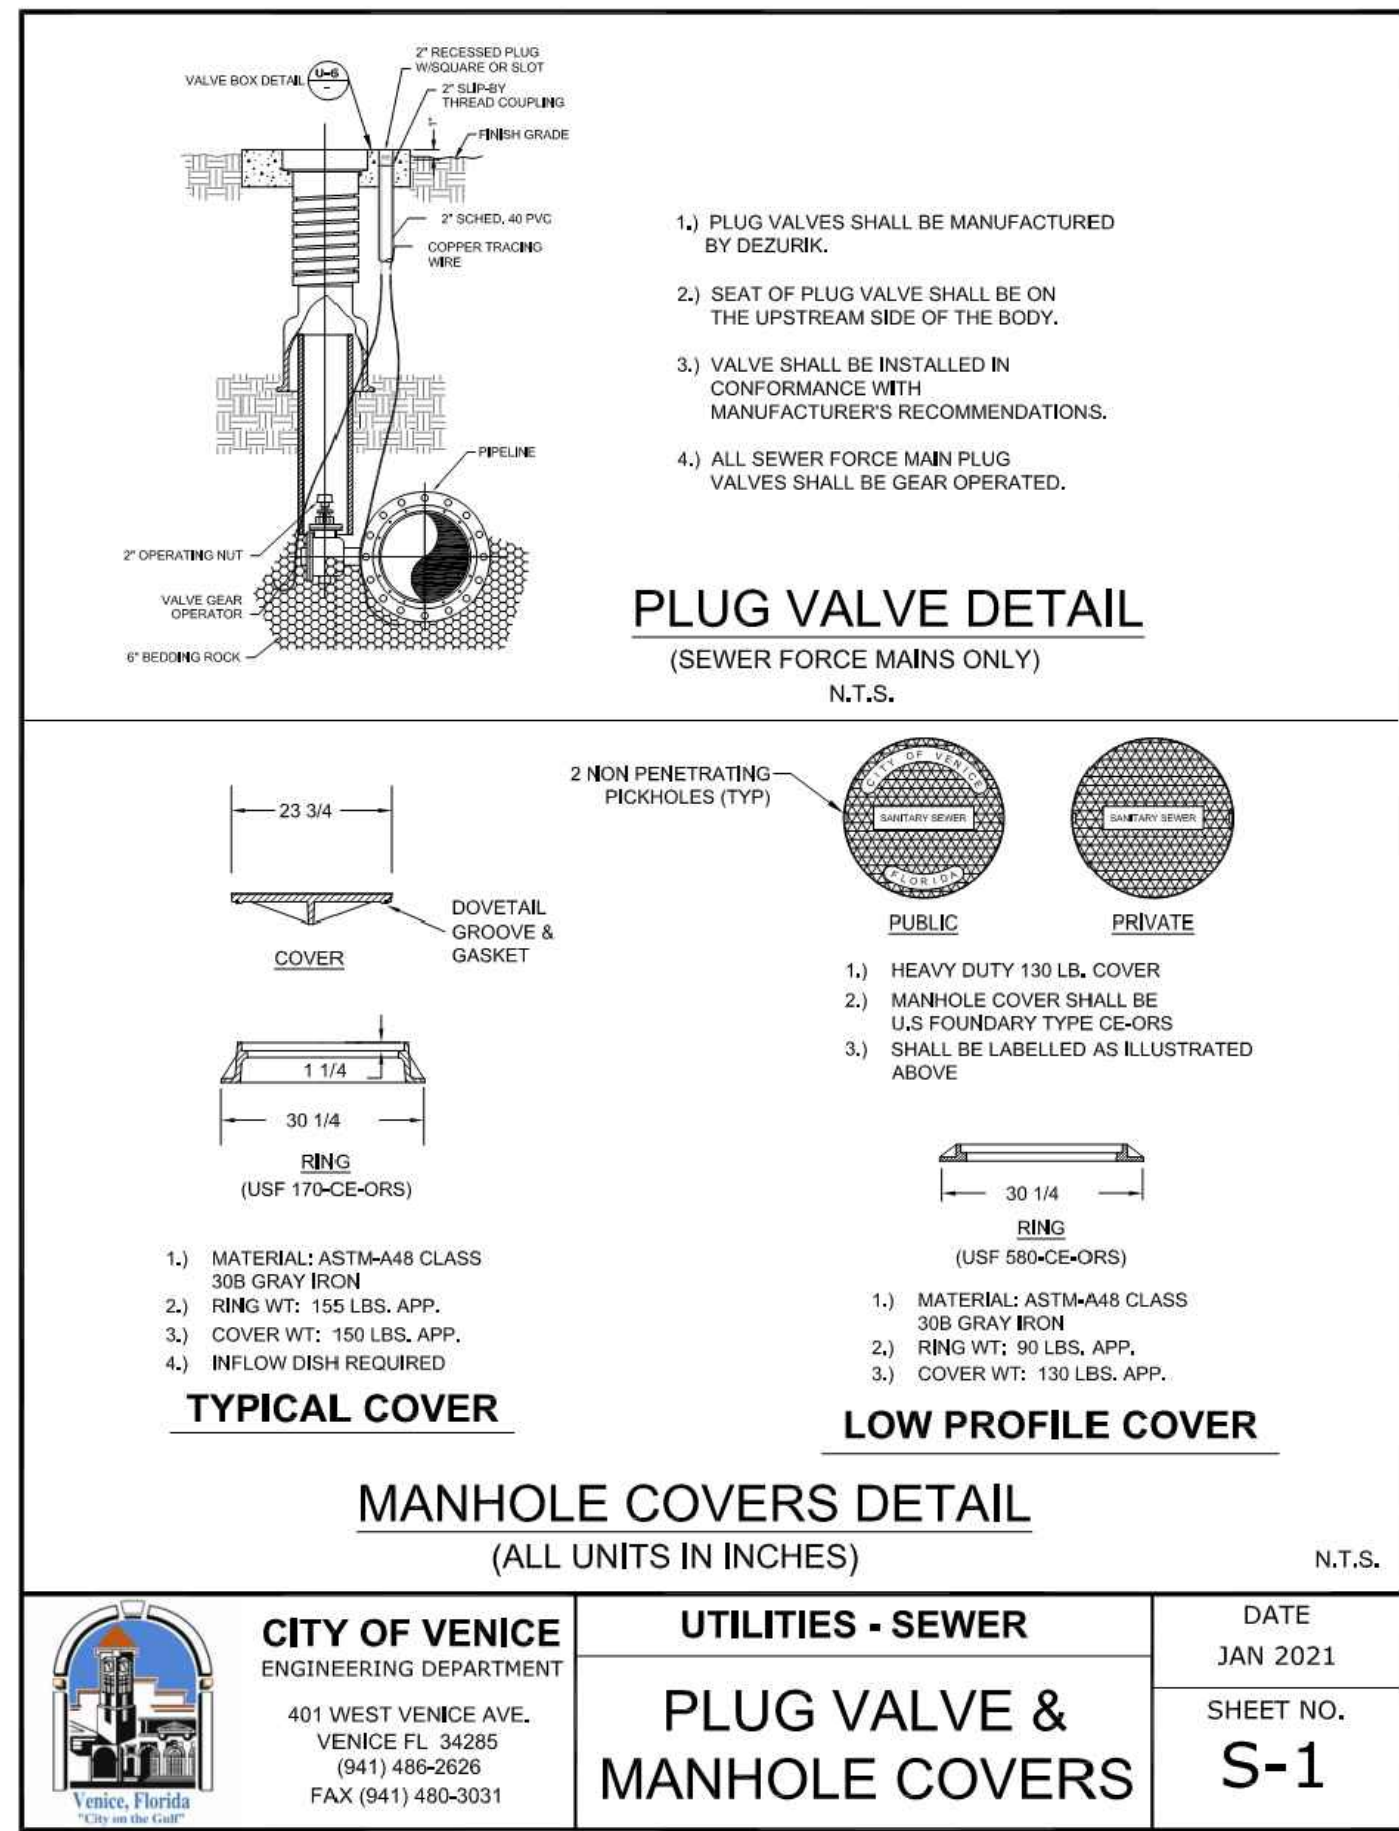

RECORD DRAWINGS
August 29, 2025
APPROVED

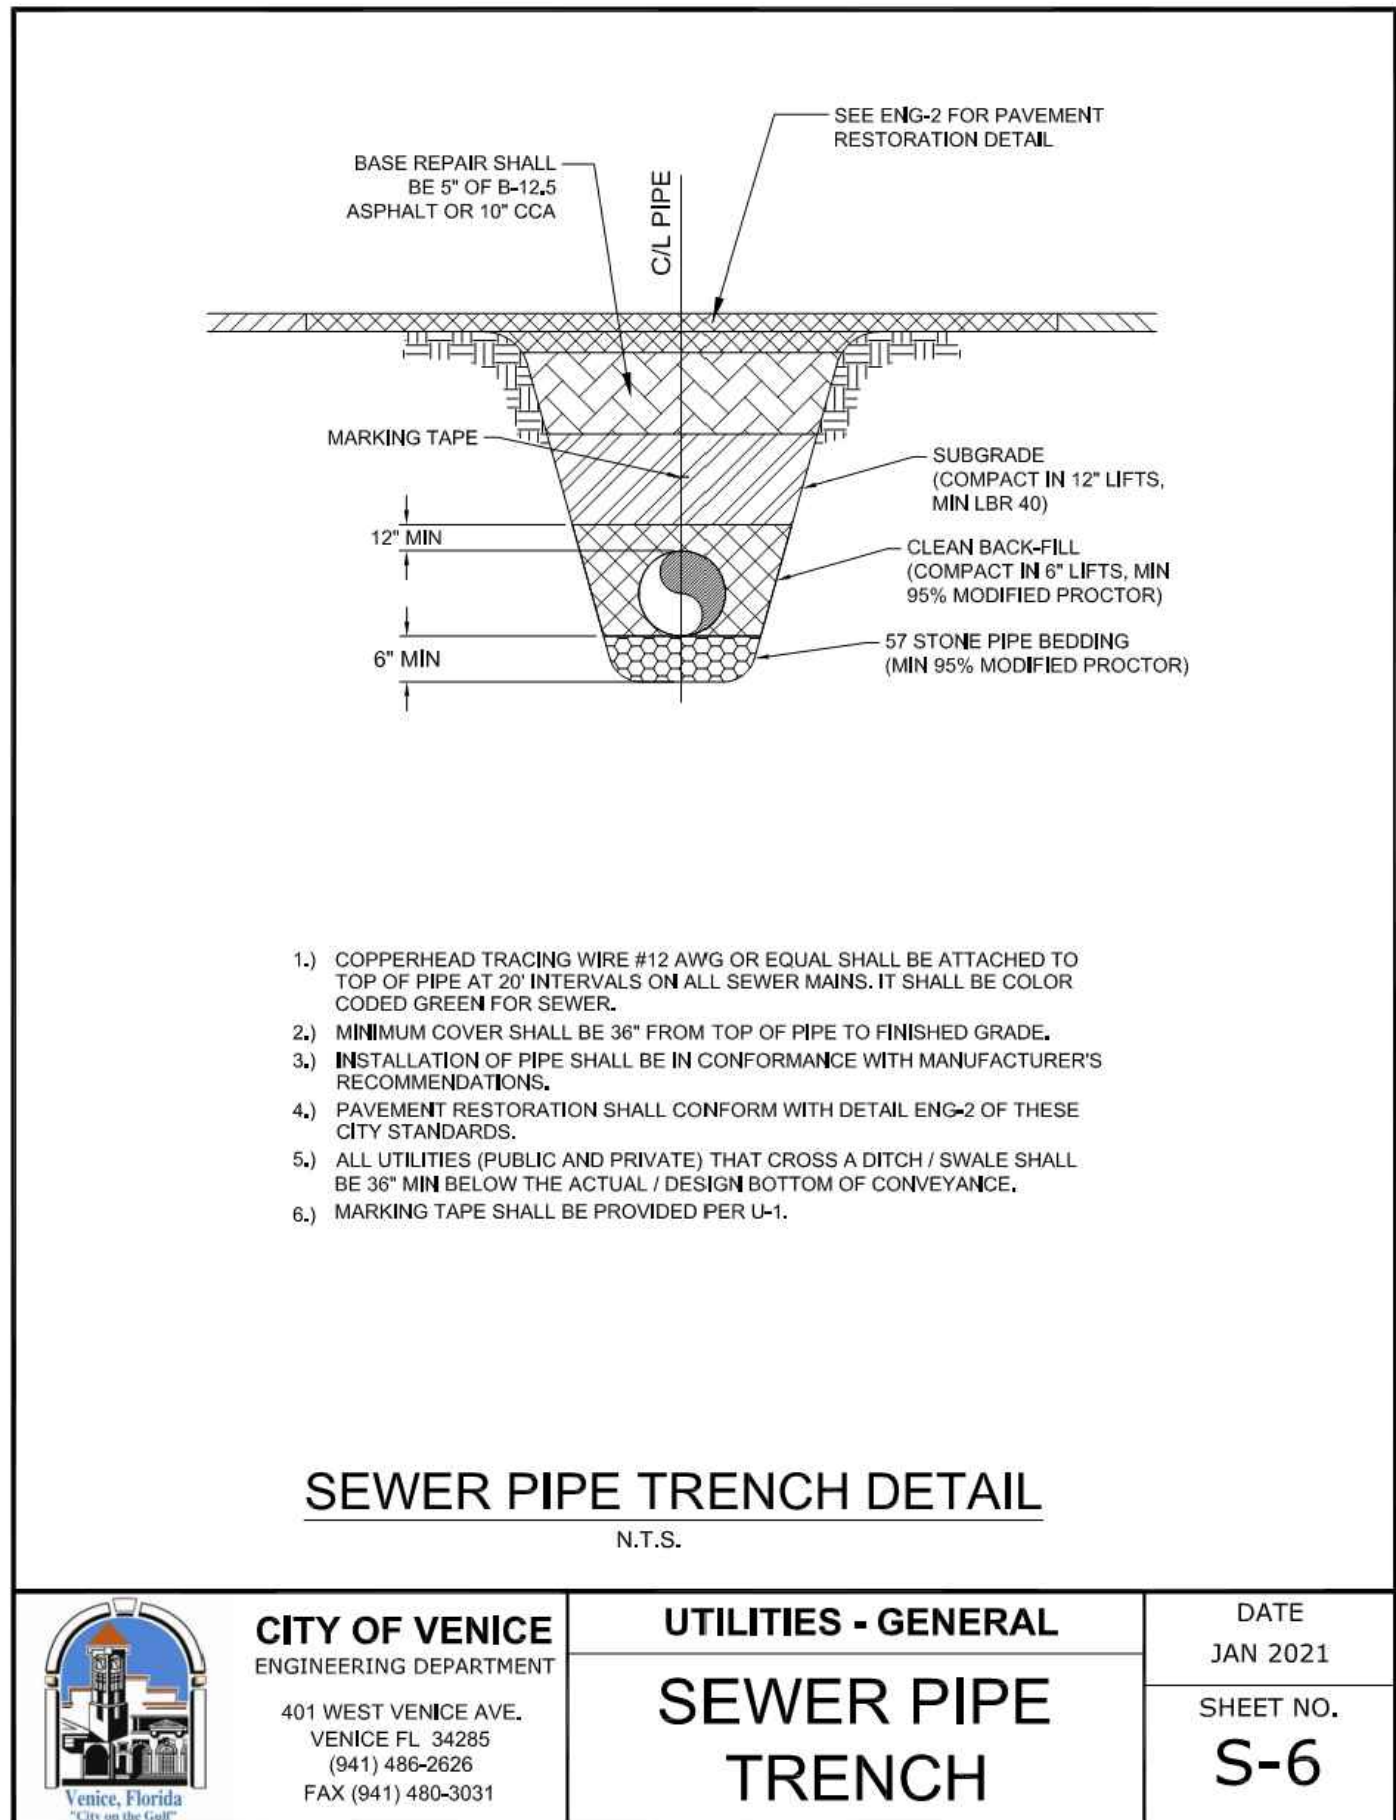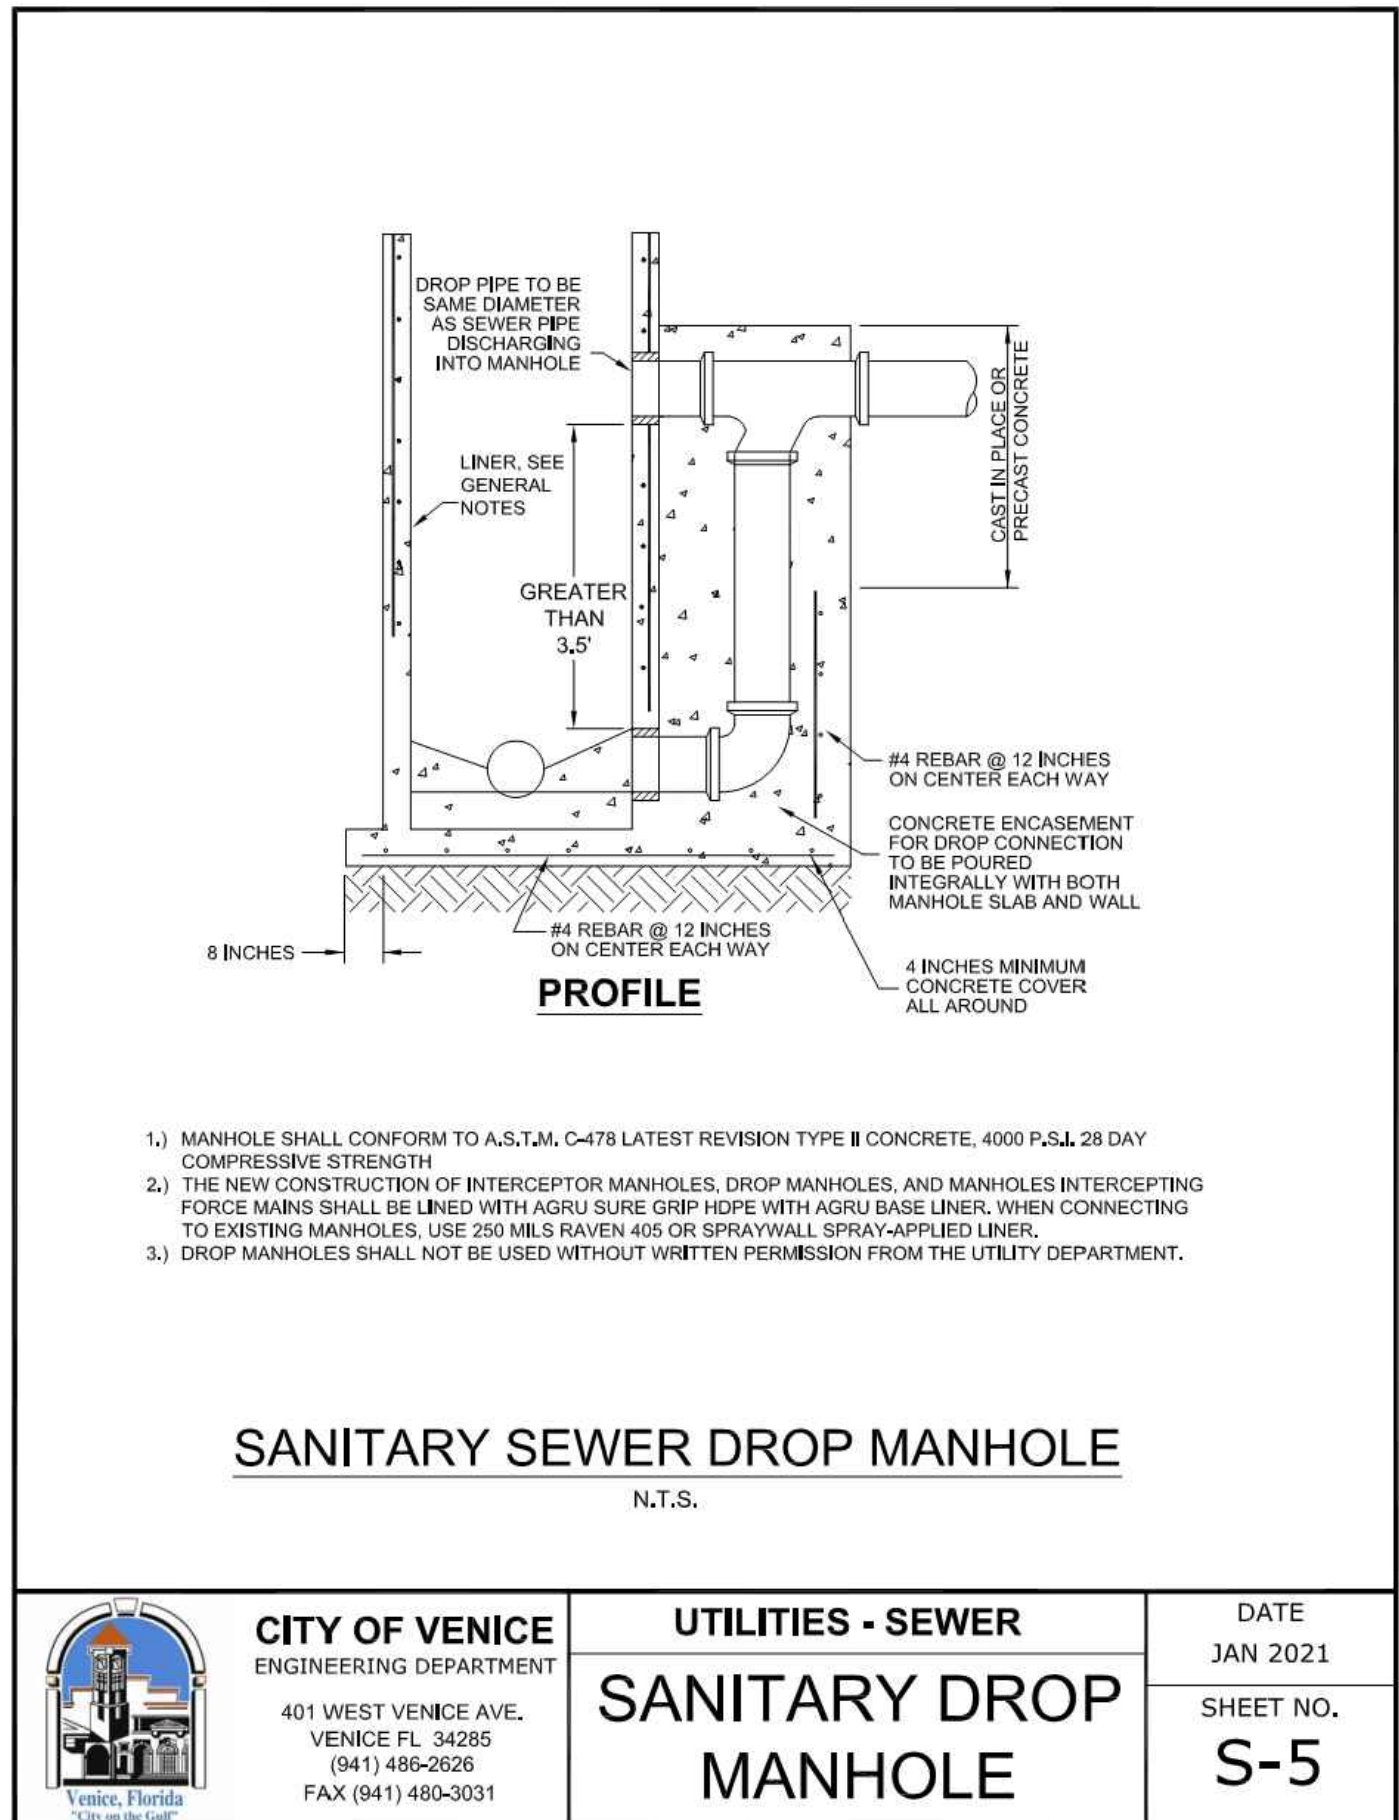

05-17-2021	INITIAL SUBMITTAL	JAS
DATE	DESCRIPTION	BY
	REVISIONS	

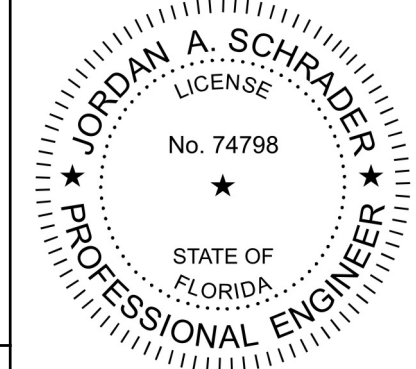

Clearview LAND DESIGN, P.L. Engineering Business C.A. No.: 28898 3010 W. Azalea St., Suite 150, Tampa, Florida 33609 Office: 813-223-3919 Fax: 813-223-3975	
JOB NO. JEN-RU-008	DESIGN FERREIRA
DRAWN DUNCAN	DATE 06-03-2025
FILE WSD	
SANITARY SEWER SYSTEM DETAILS	
RUSTIC ROAD NORTH PHASES 1 & 2	
JEN TAMPA 1, LLC. FOR: C/O BANYAN LAND CAPITAL, LLC.	
Elevations based on North American Vertical Datum 1988 (NAVD 88) Conversion from NAVD 88 to NGVD 29 = +1.11 Feet	
SHEET 68 OF 71 SHEETS	