
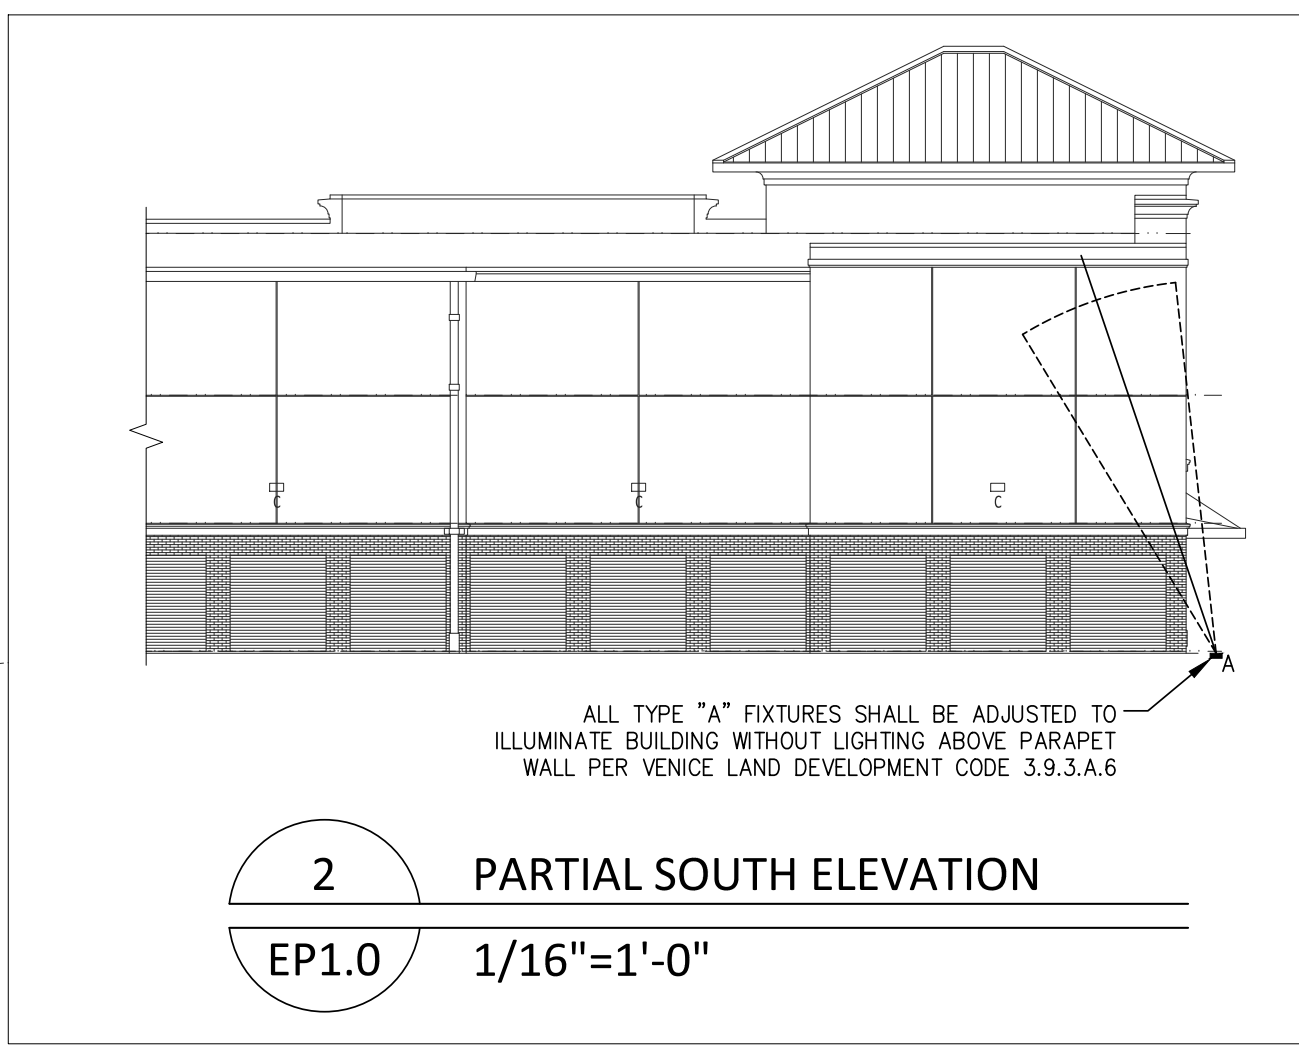


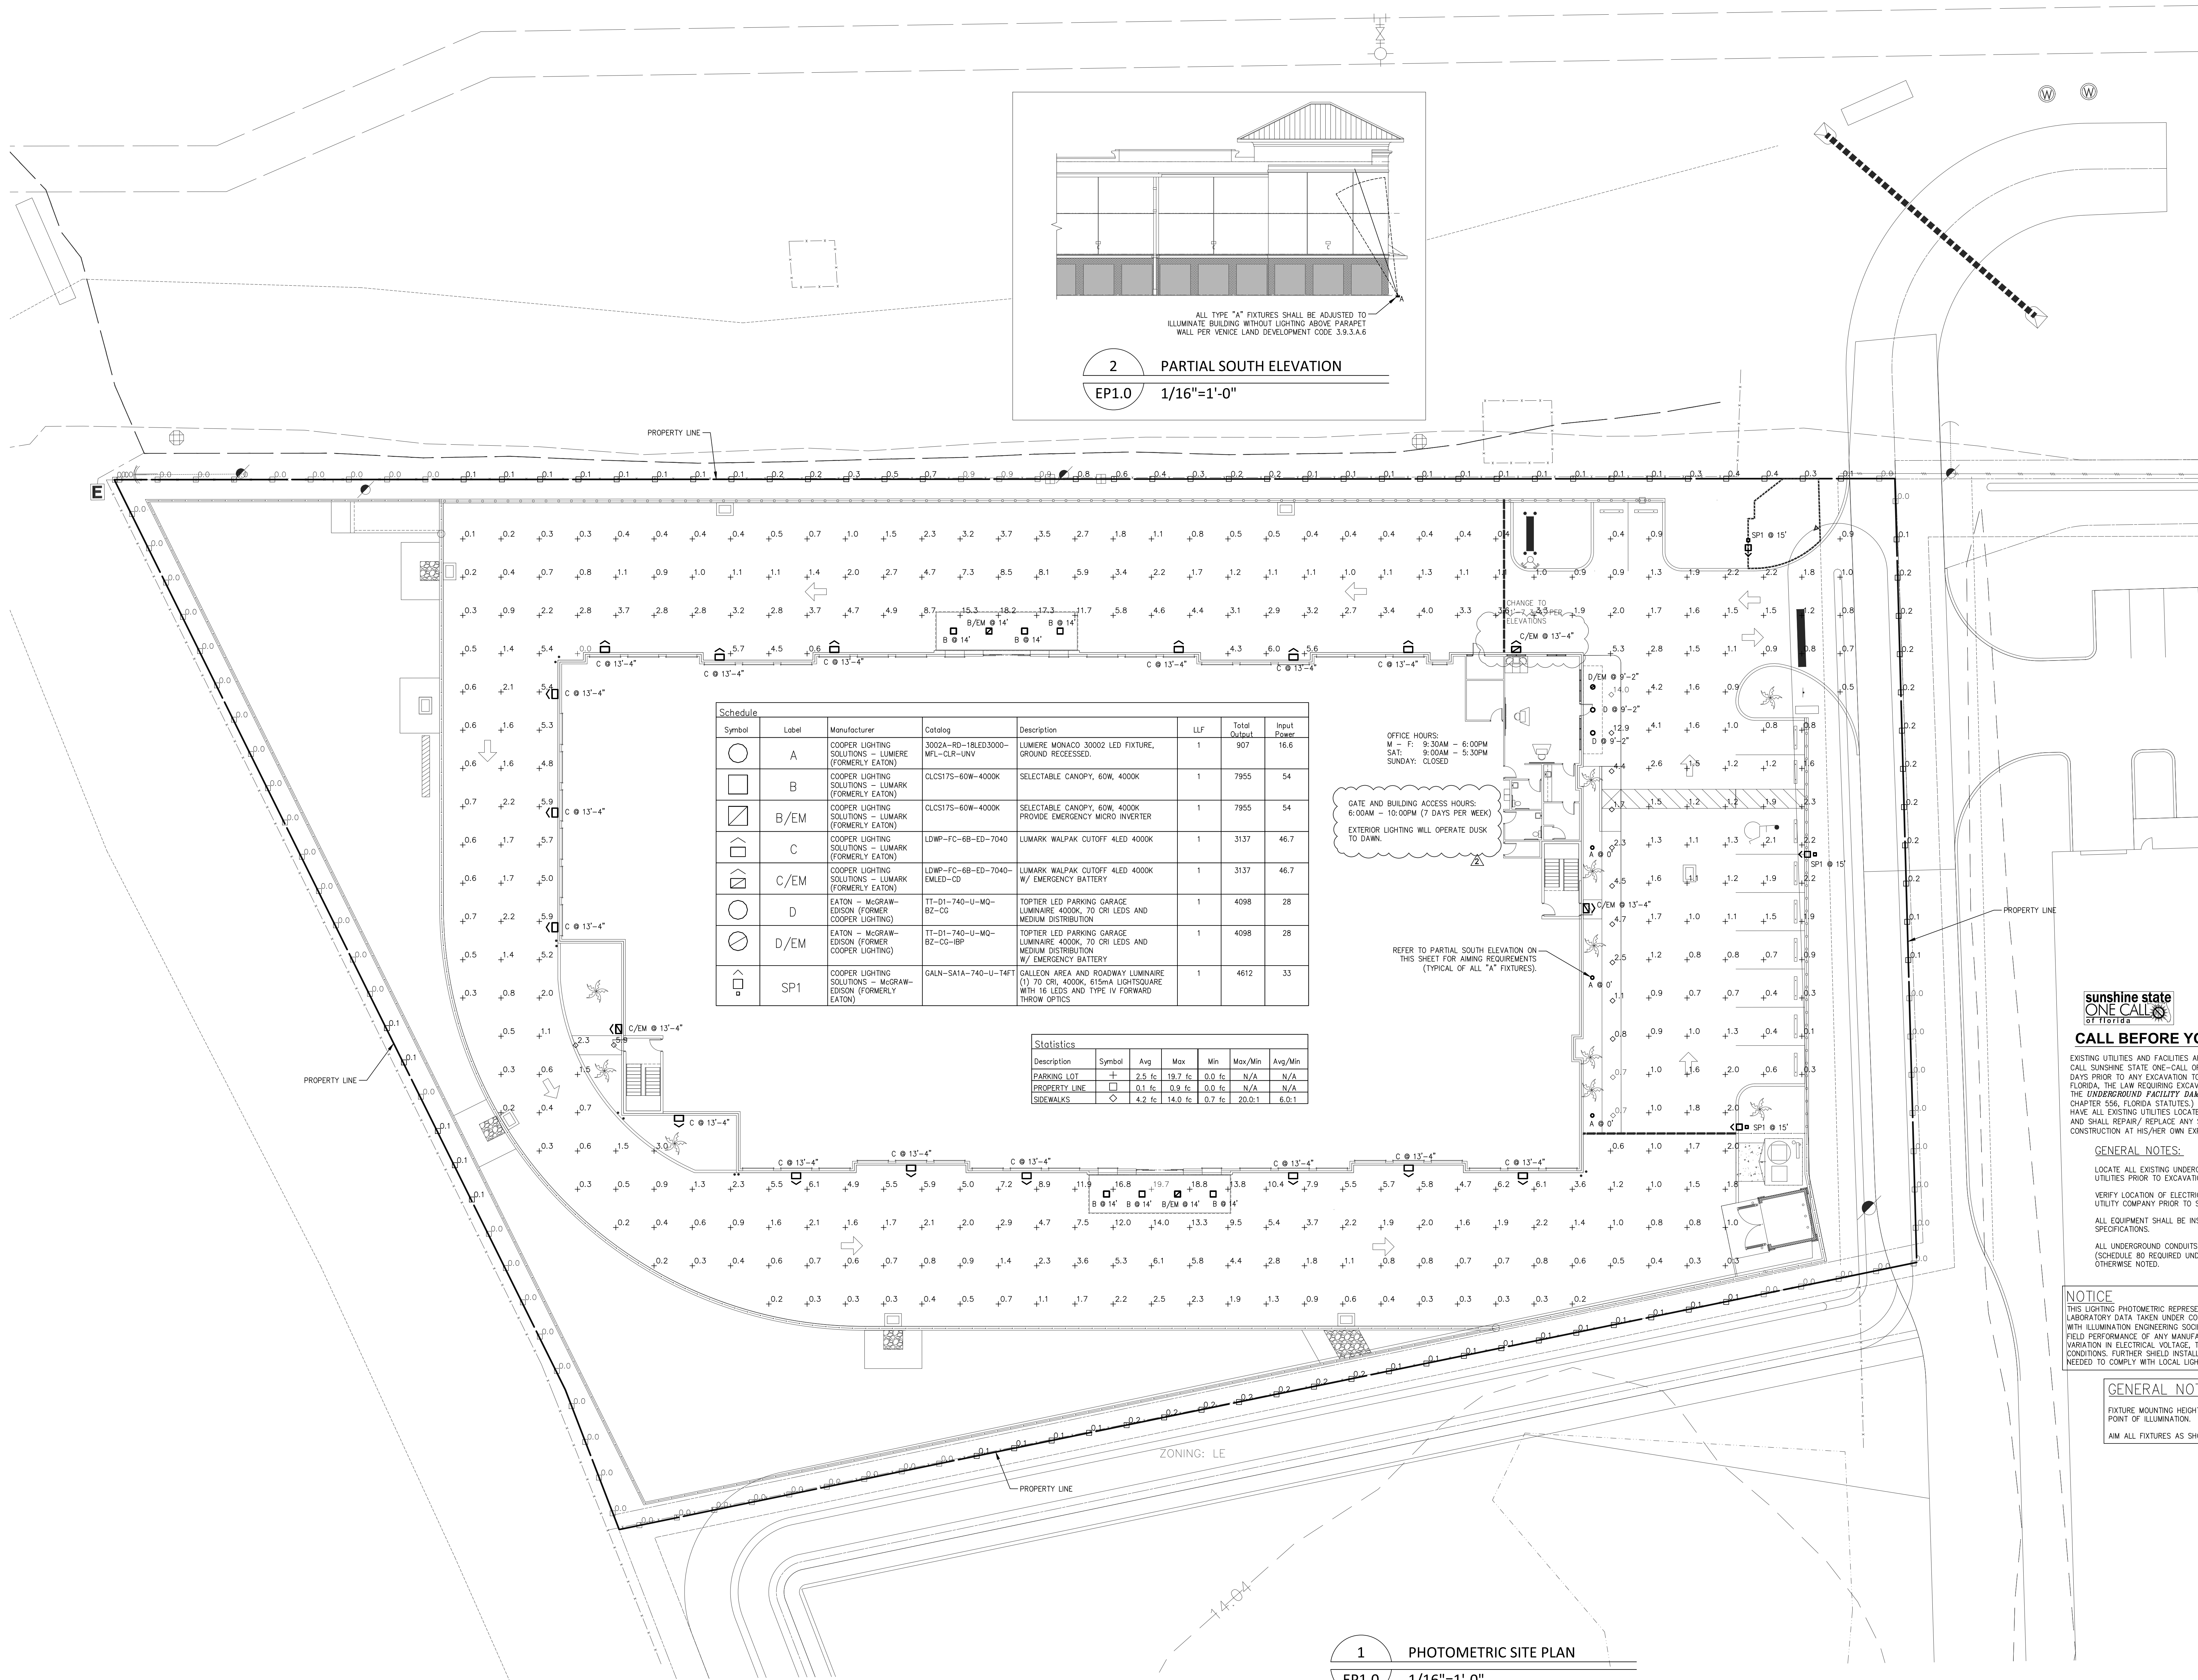

Schedule						
Symbol	Label	Manufacturer	Catalog	Description	LLF	Total Output Footcandle
○	A	COOPER LIGHTING SOLUTIONS - LUMIERE (FORMERLY EATON)	3002A-RD-18LED3000-MFL-CLR-UNV	LUMIERE MONACO 30002 LED FIXTURE, GROUND RECESSED.	1	907
□	B	COOPER LIGHTING SOLUTIONS - LUMARK (FORMERLY EATON)	CLCS17S-60W-4000K	SELECTABLE CANOPY, 60W, 4000K	1	7955
◻	B/EM	COOPER LIGHTING SOLUTIONS - LUMARK (FORMERLY EATON)	CLCS17S-60W-4000K	PROVIDE EMERGENCY MICRO INVERTER	1	7955
◻	C	COOPER LIGHTING SOLUTIONS - LUMARK (FORMERLY EATON)	LDWP-FC-6B-ED-7040	LUMARK WALPAK CUTOFF 4LED 4000K	1	3137
◻	C/EM	COOPER LIGHTING SOLUTIONS - LUMARK (FORMERLY EATON)	LDWP-FC-6B-ED-7040-EMLED-CD	LUMARK WALPAK CUTOFF 4LED 4000K W/ EMERGENCY BATTERY	1	3137
○	D	EATON - MCGRAW-EDISON (FORMER COOPER LIGHTING)	TT-D1-740-U-MQ-BZ-CG	TOPIER LED PARKING GARAGE LUMINAIRE 4000K, 70 CRI LEDS AND MEDIUM DISTRIBUTION	1	4098
◐	D/EM	EATON - MCGRAW-EDISON (FORMER COOPER LIGHTING)	TT-D1-740-U-MQ-BZ-CG-18P	TOPIER LED PARKING GARAGE LUMINAIRE 4000K, 70 CRI LEDS AND MEDIUM DISTRIBUTION W/ EMERGENCY BATTERY	1	4098
◻	SP1	COOPER LIGHTING SOLUTIONS - MCGRAW-EDISON (FORMERLY EATON)	GALN-SA1A-740-U-14FT	GALLEON AREA AND ROADWAY LUMINAIRE (1) 70 CRI, 4000K, 615mA LIGHTSQUARE WITH 16 LEDS AND TYPE IV FORWARD THROW OPTICS	1	4612

Statistics						
Description	Symbol	Avg	Max	Min	Max/Min	Avg/Min
PARKING LOT	+	2.5 fc	19.7 fc	0.0 fc	N/A	N/A
PROPERTY LINE	□	0.1 fc	0.9 fc	0.0 fc	N/A	N/A
SIDEWALKS	◇	4.2 fc	14.0 fc	0.7 fc	20.0:1	6.0:1

1 PHOTOMETRIC SITE PLAN
EP1.0 1/16"=1'-0"

Quest Design Group, Inc.
7247 Delaney Ct.
Lakewood Ranch, FL 34240
941.351.9996
www.questdg.com

Cert. of Authorization C331201
Plumbing
Electrical
Mechanical

These drawings are instruments of the Architect's service for use solely with respect to this project. These drawings shall not be used by the Owner or others on other projects, additions to this project or completion of this project by others except by written agreement.


Copyright © 2025, PHA

Revisions
07/18/25
09/08/25

Review Comments
Review Comments

QUEST DESIGN GROUP, INC.
131 SWAN CIRCLE
MONTICELLO, GEORGIA 31064
(770) 855-8905

PHA
Patrick Higgins
ARCHITECT

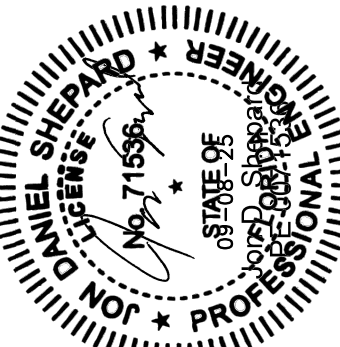

Project Title:
LAUREL SELF-STORAGE
VENICE, FL

Drawing Title:
PHOTOMETRIC SITE PLAN

Date: 20/AN/25

Released for Construction

sunshine state
ONE CALL
FLORIDA

CALL BEFORE YOU DIG

811
Know what's below.
Call before you dig.

EXISTING UTILITIES AND FACILITIES ARE IN PLACE. CALL BEFORE YOU DIG. CALL SUNSHINE STATE ONE-CALL OF FLORIDA AT "811". TWO FULL BUSINESS DAYS PRIOR TO ANY EXCAVATION TO LOCATE ALL UNDERGROUND UTILITIES. (IN FLORIDA, THE LAW REQUIRING EXCAVATORS TO CALL 811 BEFORE DIGGING IS THE UNDERGROUND FACILITY DAMAGE PREVENTION AND SAFETY ACT, CHAPTER 556, FLORIDA STATUTES.) CONTRACTOR SHALL BE RESPONSIBLE TO HAVE ALL EXISTING UTILITIES LOCATED PRIOR TO THE START OF ANY WORK, AND, SHALL REPAIR/ REPLACE ANY SYSTEMS HE/SHE DAMAGES DURING CONSTRUCTION AT HIS/HER OWN EXPENSE.

GENERAL NOTES:

LOCATE ALL EXISTING UNDERGROUND AND OVERHEAD UTILITIES PRIOR TO EXCAVATION.

VERIFY LOCATION OF ELECTRIC SERVICE ENTRANCE WITH UTILITY COMPANY PRIOR TO START OF WORK.

ALL EQUIPMENT SHALL BE INSTALLED PER MANUFACTURERS SPECIFICATIONS.

ALL UNDERGROUND CONDUITS SHALL BE PVC SCHEDULE 40 (SCHEDULE 80 REQUIRED UNDER ALL ROADWAYS) UNLESS OTHERWISE NOTED.

NOTICE

THIS LIGHTING PHOTOMETRIC REPRESENTS ILLUMINATION LEVELS FROM LABORATORY DATA TAKEN UNDER CONTROLLED CONDITIONS IN ACCORDANCE WITH ILLUMINATION ENGINEERING SOCIETY (IES) APPROVED METHODS. ACTUAL FIELD PERFORMANCE OF ANY MANUFACTURER'S LUMINAIRE MAY VARY DUE TO VARIATION IN ELECTRICAL VOLTAGE, TOLERANCE IN LAMPS, OR OTHER FIELD CONDITIONS. FURTHER SHIELD INSTALLATIONS AND OR ADJUSTMENTS MAY BE NEEDED TO COMPLY WITH LOCAL LIGHTING ORDINANCES OR REQUIREMENTS.

GENERAL NOTES

FIXTURE MOUNTING HEIGHTS SHOWN ARE TO THE POINT OF ILLUMINATION.

AIM ALL FIXTURES AS SHOWN ON THIS DRAWING.