



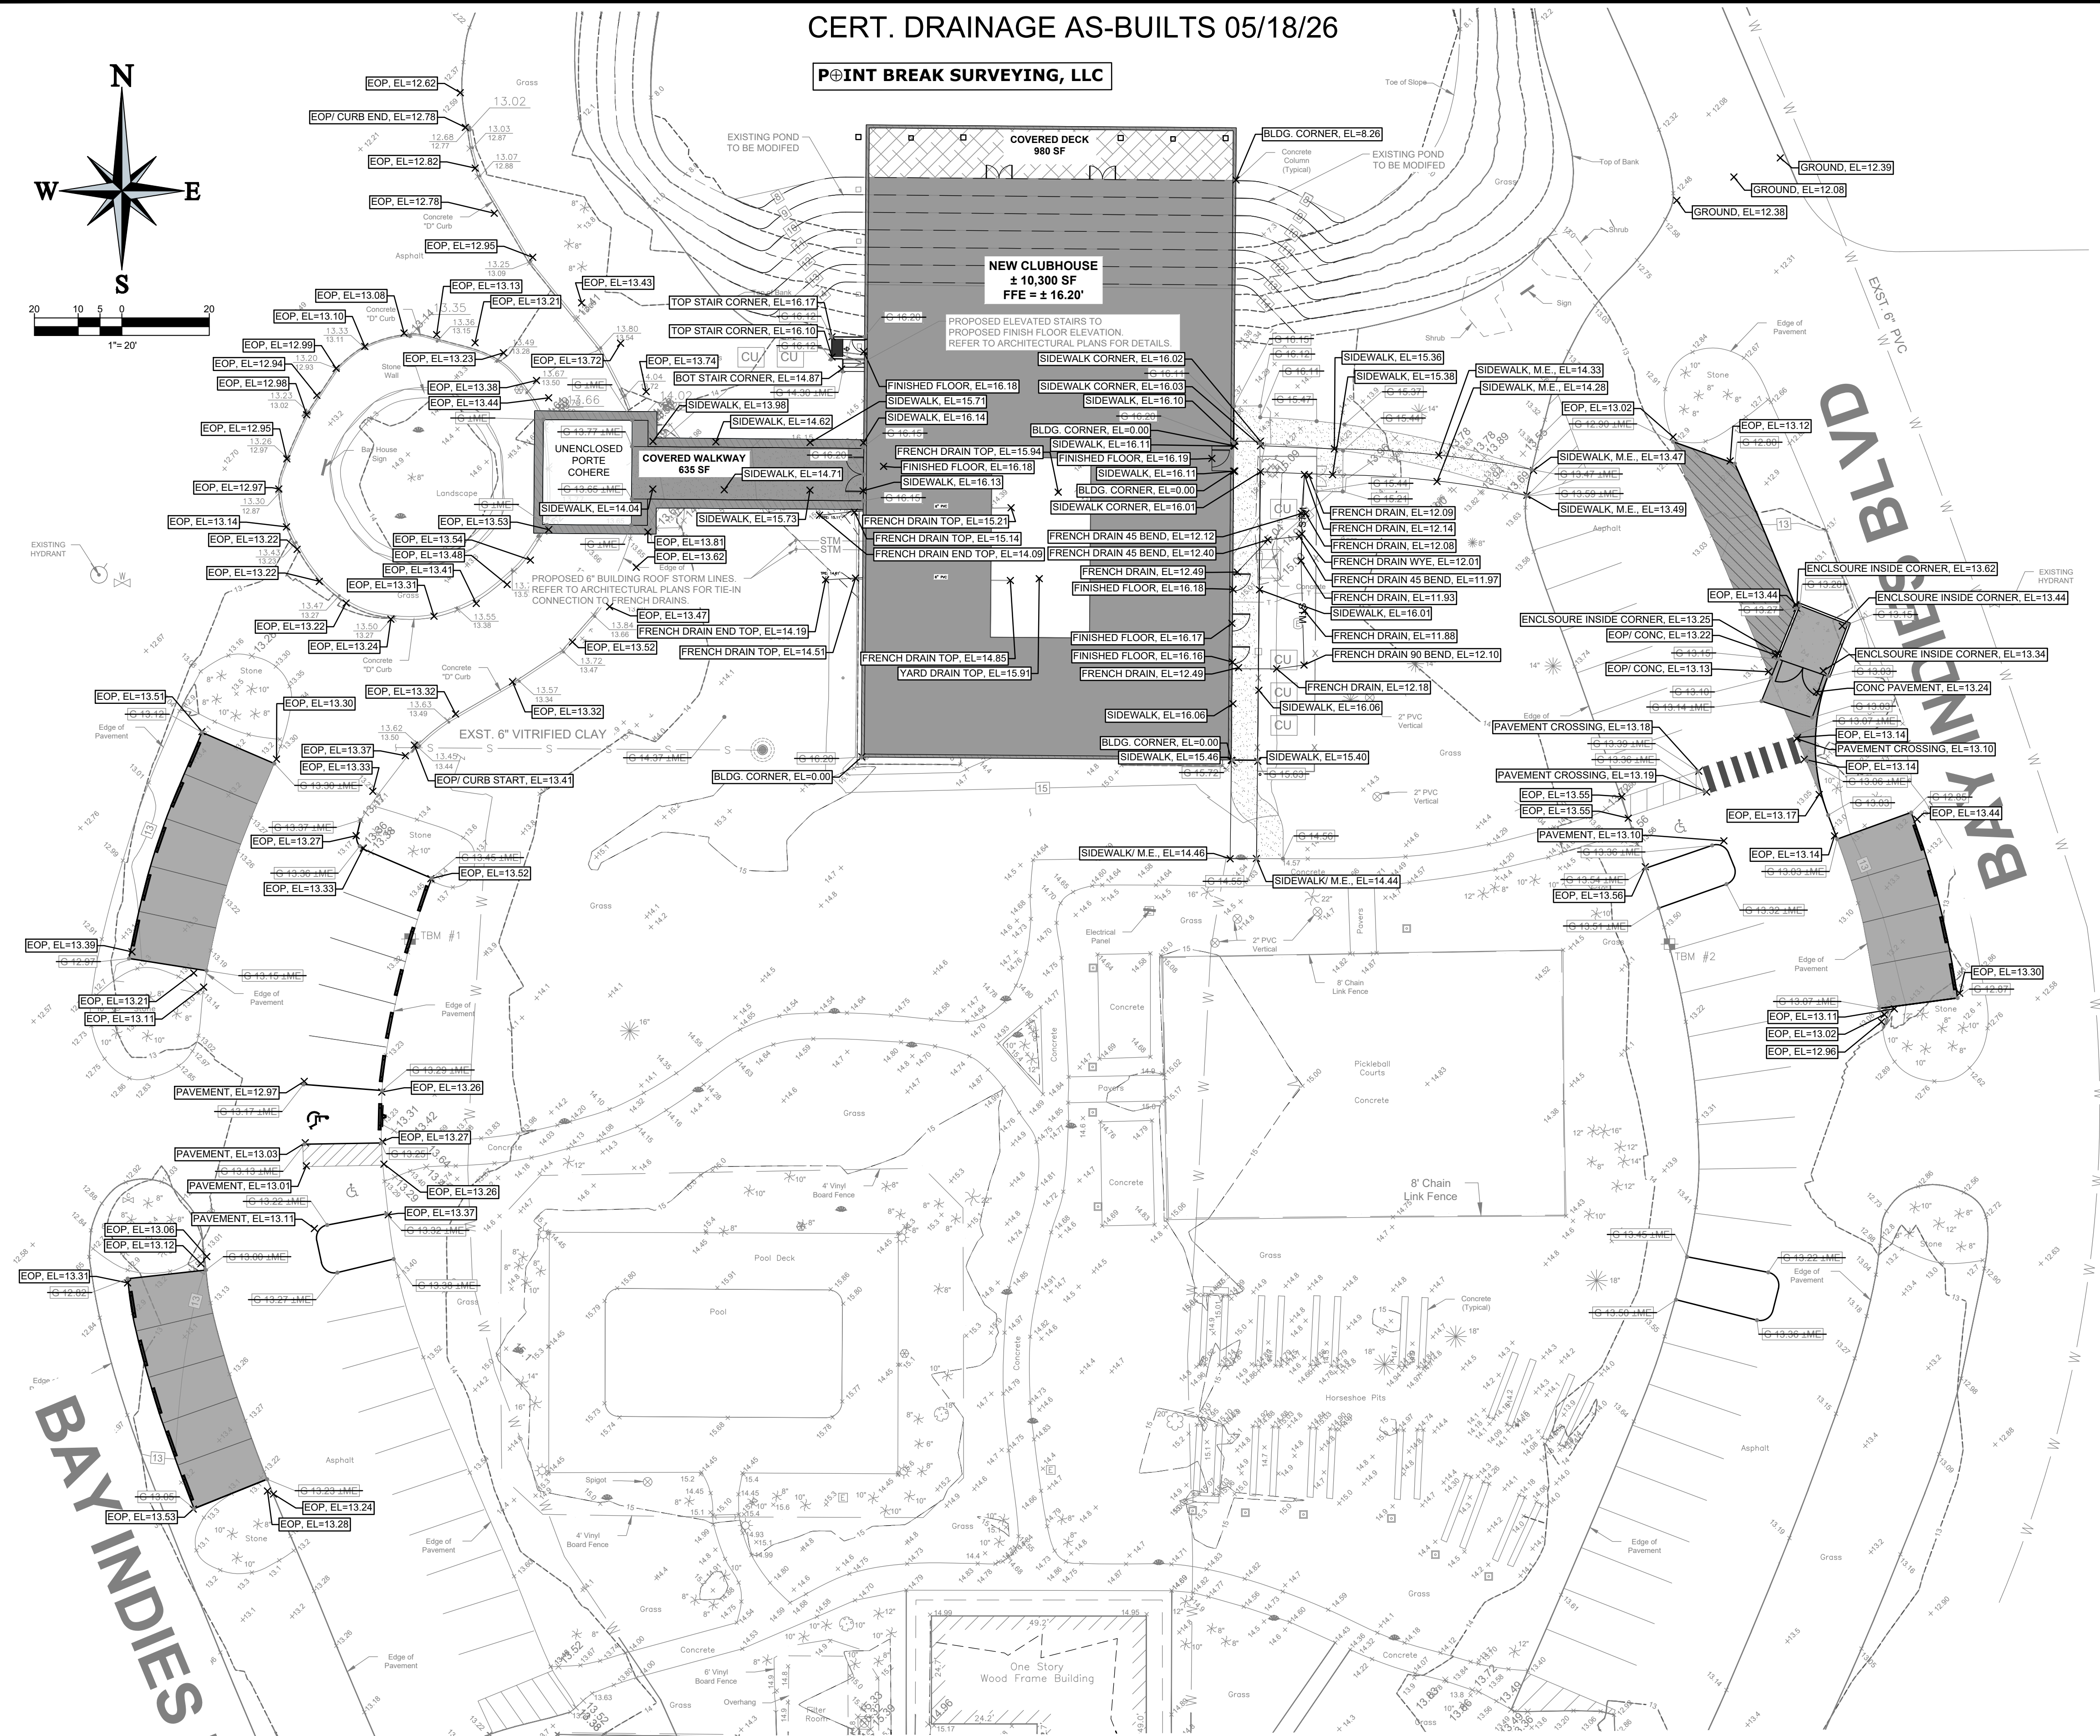

1. ALL DIMENSIONS ARE TO GROUND LEVEL IMPROVEMENTS (FACE OF CURB, CONCRETE SLAB, ETC.) UNLESS NOTED OTHERWISE. REFER TO ARCHITECTURAL PLANS FOR BUILDING DETAILS.
2. ALL DIMENSIONS FROM PROPERTY LINES ARE PERPENDICULAR UNLESS OTHERWISE NOTED.
3. CONTRACTOR TO SEED ALL DISTURBED AREA UNLESS NOTED OTHERWISE.

 
1. RETENTION / DETENTION AREAS MUST BE STABILIZED WITH SOD UNLESS AN ALTERNATIVE METHOD IS SPECIFICALLY PERMITTED PRIOR TO PLAN APPROVAL. NO ORGANIC MULCH WILL BE PERMITTED IN OR ADJOINING RETENTION / DETENTION AREA.
2. THE PROJECT OWNER IS RESPONSIBLE FOR THE PERPETUAL MAINTENANCE OF ALL FEATURES OF THE SURFACE WATER MANAGEMENT SYSTEM AS OUTLINED ON THE DRAINAGE PLAN.
3. REFER TO COVER SHEET FOR VERTICAL DATUM.

NOTE:
THERE IS AN INSUBSTANTIAL EFFECT ON
THE EXISTING POND/DRAINAGE SYSTEM. NO
ADVERSE DRAINAGE IMPACT ONSITE IS
EXPECTED.

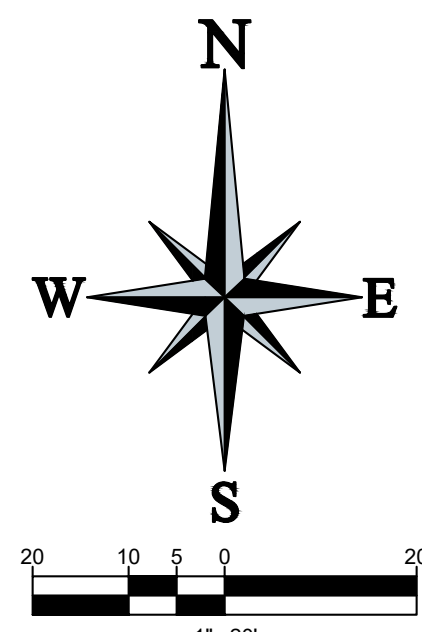

APPROVED

- EXISTING PROPERTY BOUNDARY LINE
- EXISTING ADJOINING PROPERTY LINE
- EXISTING ACCESS EASEMENT
- EXISTING 5' INTERVAL CONTOUR LINE
- EXISTING 1' INTERVAL CONTOUR LINE
- PROPOSED 5' INTERVAL CONTOUR LINE
- PROPOSED 1' INTERVAL CONTOUR LINE

	PROPOSED SPOT SHOTS
	PROPOSED DRAINAGE BASIN LINE
	EXISTING CURB
	PROPOSED UTILITY EASEMENT
	PROPOSED CURB AND GUTTER
	PROPOSED CURB
	PROPOSED DEPRESSED CURB
	PROPOSED BUILDING
	PROPOSED WATER STRUCTURES
	PROPOSED STORM STRUCTURES
	PROPOSED SANITARY STRUCTURES
	PROPOSED STORM PIPE
	PROPOSED WATER
	PROPOSED SANITARY
	PROPOSED ELECTRIC
	PROPOSED TELECOMMUNICATIONS
	PROPOSED GAS

																																																																																																				
---	---	--


Bowman

CERTIFICATE OF AUTHORIZATION LICENSE NO. 30462

BOWMAN CONSULTING
GROUP, LTD.
5404 CYPRESS CENTER DR
SUITE 140
TAMPA, FL 33609
PHONE: (813) 474-7424
BOWMAN.COM

GRADING, PAVING AND DRAINAGE
BAY INDIES CLUBHOUSE
950 RIDGEWOOD AVE
VENICE, FL 34285

CITY OF VENICE

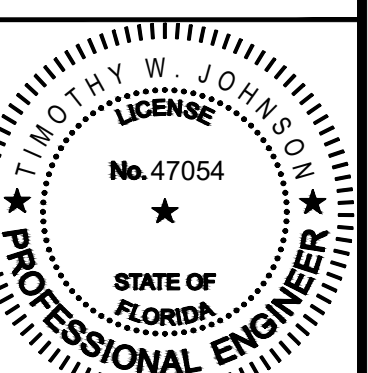

REV	DATE	COMMENT
1	2026/06/16	CITY OF VENICE REV#1

MM DESIGN	ADH DRAWN	TJ CHK
SCALE 1" = 20'		

OB No. 011528-01-001

DATE 10/14/2024

CEC


HEET 63.0

C5.0



THIS DOCUMENT, TOGETHER WITH THE CONCEPTS AND DESIGNS PRESENTED HEREIN, IS INTENDED ONLY FOR THE SPECIFIC PURPOSE AND CLIENT FOR WHICH IT WAS PREPARED. REUSE OF AND IMPROPER RELIANCE ON THIS DOCUMENT WITHOUT WRITTEN AUTHORIZATION AND ADAPTATION BY BOWMAN SHALL BE WITHOUT LIABILITY TO BOWMAN.

USER: D:\PUB\LEW_PLOT DATE/TIME: Jun. 18, 26 - 13:07:26 DRAWING: V011528 - Green Earth Commercial Contracting Corp\011528-01-001 (ENG) - Bay Indies CH 950 E Sand City Ave Venice\Engineering\Engineering Plans\Site\Record Drawings\011528-01-001-02-0-UTL.dwg C6.1 OVERALL UTILITY PLAN

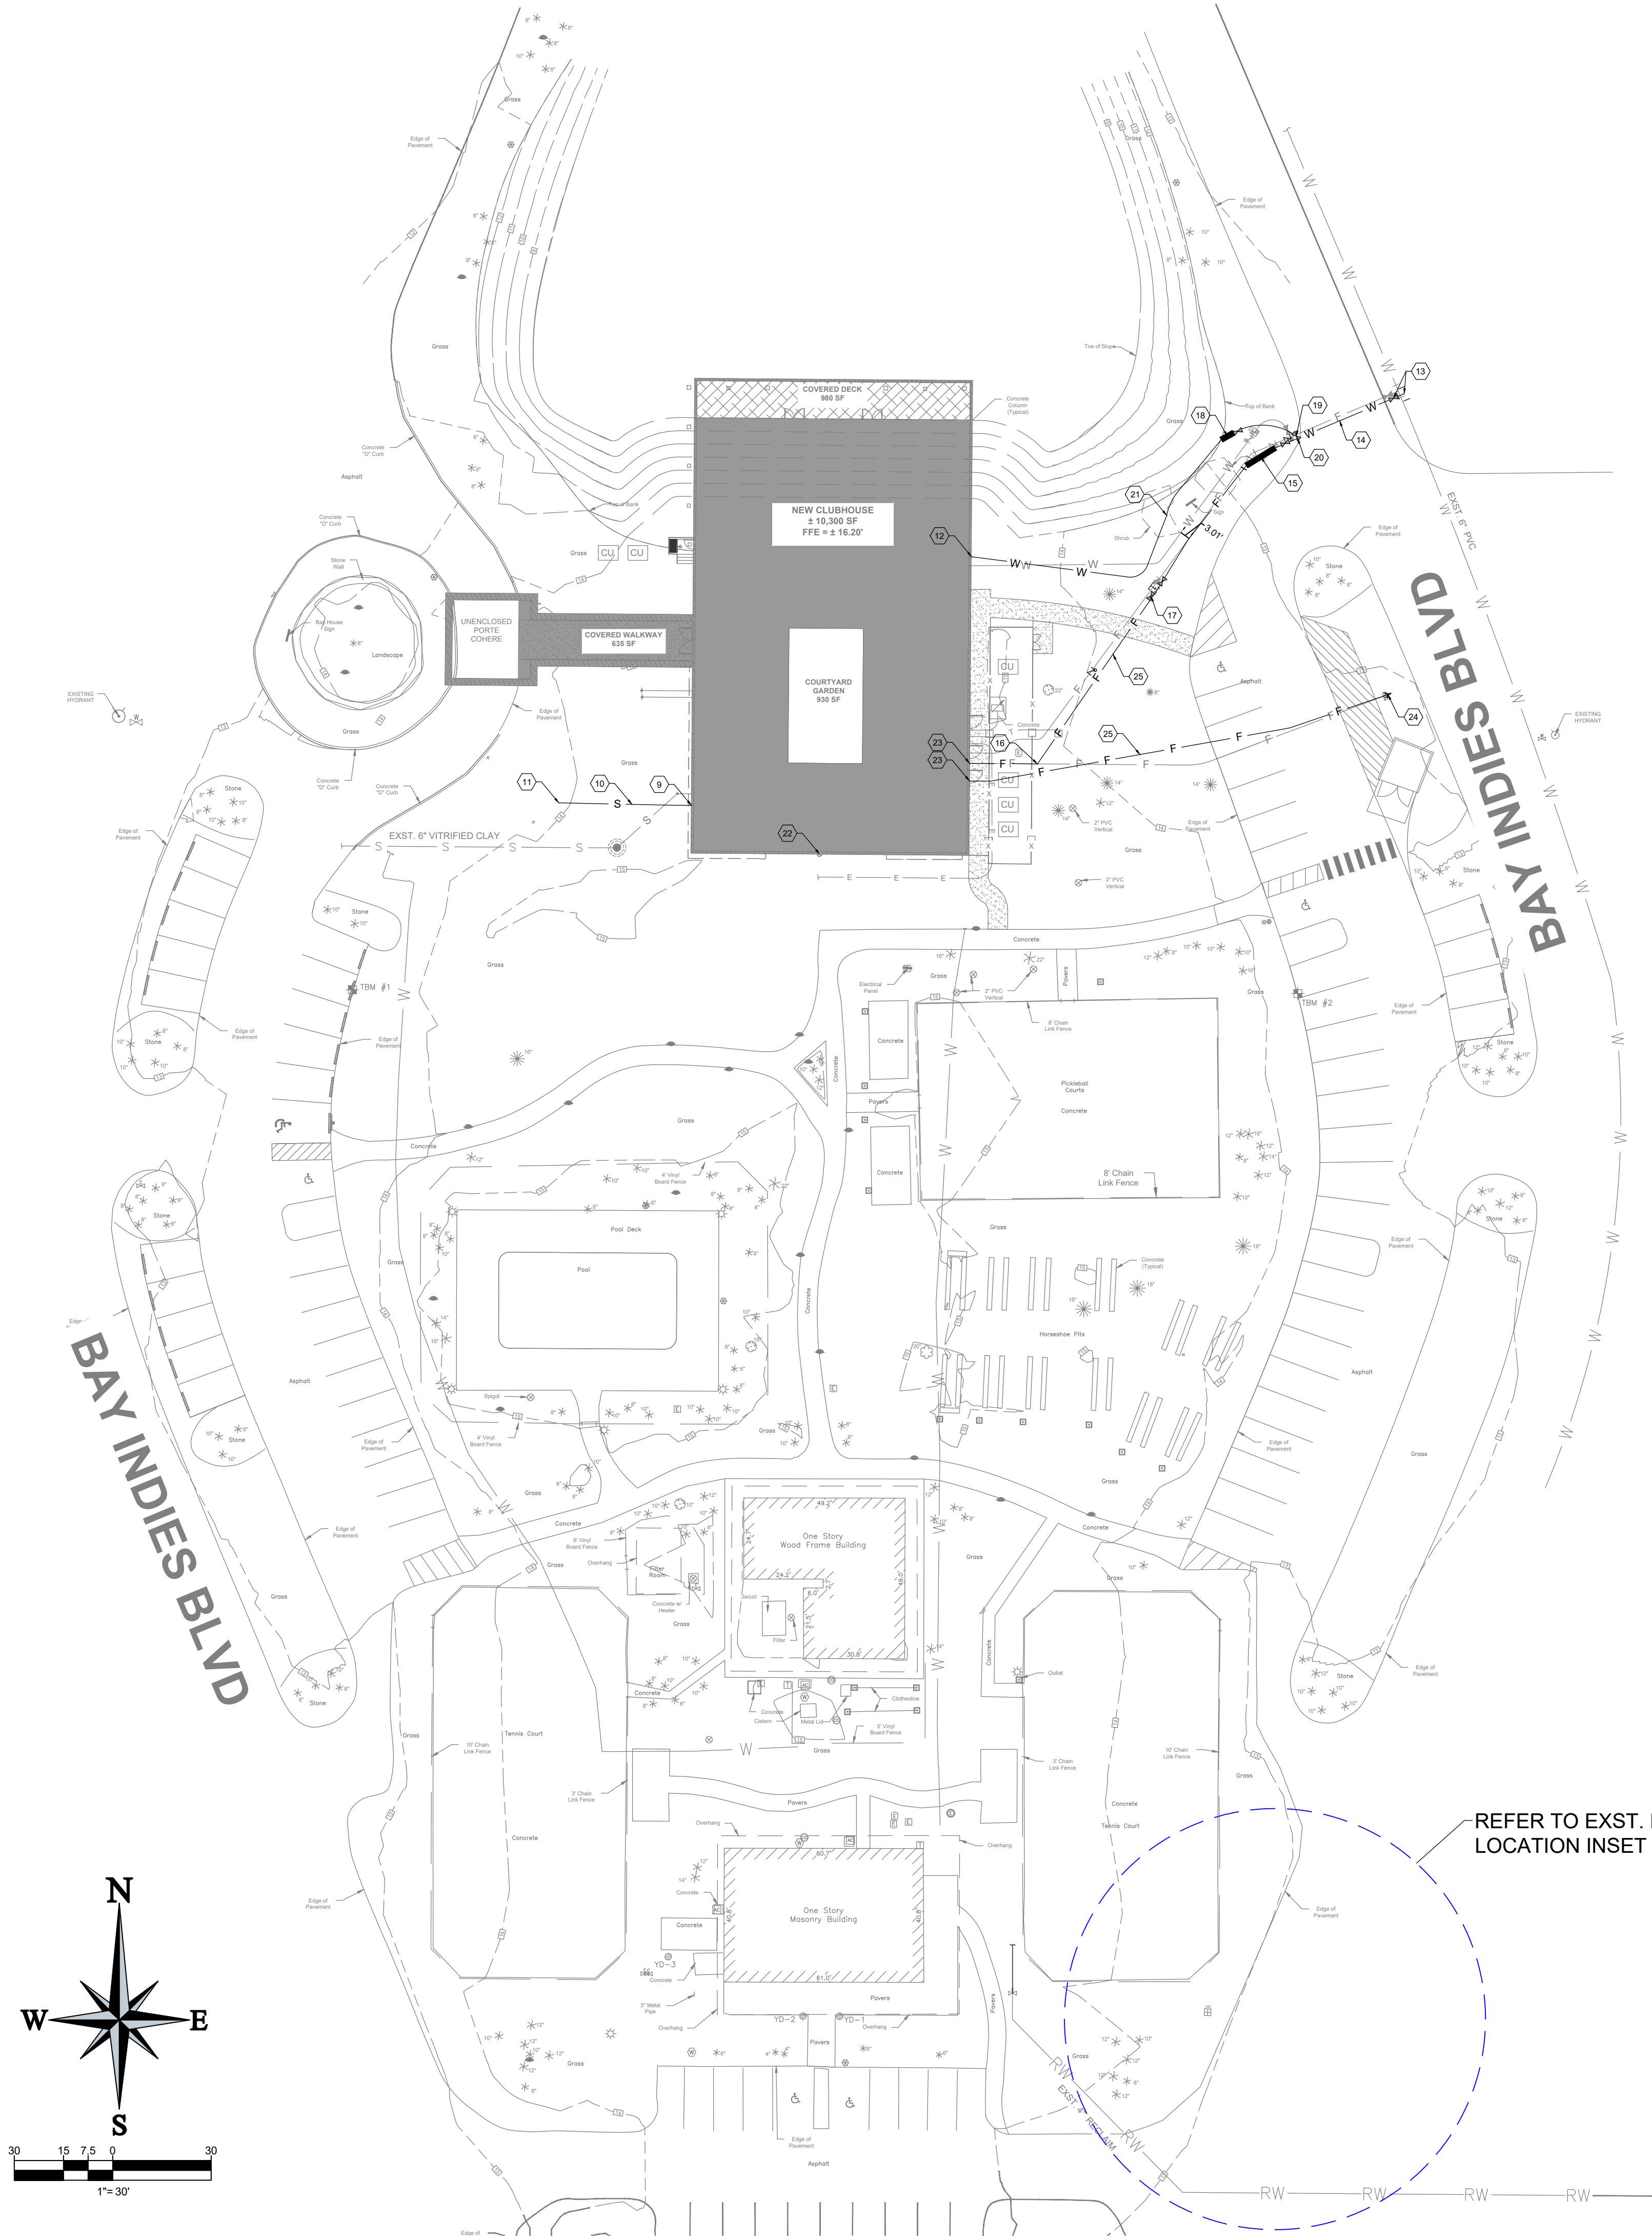

REFER TO EXST. RECLAIM METER
LOCATION INSET FOR DETAILS.

UTILITY LEGEND	
	EXISTING PROPERTY BOUNDARY LINE
	EXISTING ADJOINING PROPERTY LINE
	EXISTING ACCESS EASEMENT
	EXISTING 5' INTERVAL CONTOUR LINE
	EXISTING 1' INTERVAL CONTOUR LINE
	PROPOSED 5' INTERVAL CONTOUR LINE
	PROPOSED 1' INTERVAL CONTOUR LINE
	EXISTING CURB
	PROPOSED CURB
	PROPOSED BUILDING
	PROPOSED WATER STRUCTURES
	PROPOSED SANITARY STRUCTURES
	PROPOSED WATER
	PROPOSED FIRE
	PROPOSED SANITARY
	PROPOSED ELECTRIC
	PROPOSED TELECOMMUNICATIONS
	EXISTING STORM STRUCTURES
	EXISTING SANITARY STRUCTURES
	EXISTING WATER STRUCTURES
	EXISTING STORM
	EXISTING WATER MAIN
	EXISTING SANITARY
	EXISTING UNDERGROUND ELECTRIC
	EXISTING OVERHEAD WIRES
	EXISTING TELEPHONE
	EXISTING GAS MAIN



UTILITY KEYED NOTES:

ELECTRIC:

- PROPOSED POINT OF CONNECTION TO EXISTING TRANSFORMER FOR UNDERGROUND ELECTRIC SERVICE. CONTRACTOR SHALL COORDINATE WITH WITH UTILITY COMPANY (FLORIDA POWER & LIGHT).
- PROPOSED CONDUIT FOR ELECTRICAL SERVICE. CONTRACTOR SHALL COORDINATE WITH UTILITY COMPANY (FLORIDA POWER & LIGHT).
- PROPOSED BUILDING LOCATION FOR FOR UNDERGROUND ELECTRIC SERVICE (FLORIDA POWER & LIGHT). REFER TO ELECTRICAL PLANS FOR DETAILS.
- PROPOSED FUTURE STUB OUT FOR ELECTRIC SERVICE.
- PROPOSED POINT OF CONNECTION FOR UNDERGROUND TELEPHONE/CABLE SERVICE. CONTRACTOR SHALL COORDINATE WITH UTILITY COMPANY (FRONTIER COMMUNICATIONS).
- PROPOSED (2) 4" UNDERGROUND CONDUITS FOR TELECOMMUNICATION SERVICE. CONTRACTOR SHALL COORDINATE WITH UTILITY COMPANY (FRONTIER COMMUNICATIONS).
- PROPOSED BUILDING LOCATION FOR UNDERGROUND TELEPHONE/CABLE SERVICE (FRONTIER COMMUNICATIONS). REFER TO ELECTRICAL PLANS FOR DETAILS.
- PROPOSED CONDENSING UNIT (TYPICAL). REFER TO ELECTRICAL PLANS FOR DETAILS.

SEWER:

- PROPOSED APPROXIMATE LOCATION FOR SANITARY SEWER TIE IN TO THE BUILDING. REFER TO ARCHITECTURAL PLANS FOR DETAILS.
- PROPOSED 6" GREEN PVC (SDR 26) SANITARY SEWER SERVICE. SANITARY SEWER PIPE TO BE RUN AT MINIMUM SLOPE OF 1.04% AND THE CONTRACTOR TO PROVIDE 36" MINIMUM COVER.
- PROPOSED 6" GREEN PVC (SDR 26) POINT OF CONNECTION TO EXISTING MANHOLE. THE CONTRACTOR SHALL PERFORM CORE DRILLING AND INSTALL A SEAL BOOT AS METHOD OF CONNECTION.

WATER:

- PROPOSED APPROXIMATE LOCATION FOR POTABLE WATER TIE IN TO THE BUILDING. REFER TO ARCHITECTURAL PLAN FOR DETAILS.
- PROPOSED 6" CUT-IN TEE CONNECTION WITH A 6" GATE VALVE TO EXISTING 6" PVC WATER MAIN. CONTRACTOR TO FIELD VERIFY THE EXISTING MAIN AT THIS LOCATION.
- PROPOSED 6" BLUE C-900 PVC DOMESTIC WATER SERVICE, PER CITY OF VENICE STANDARD DETAILS.
- PROPOSED 6" FIRE BACKFLOW PREVENTOR
- PROPOSED 45" BEND.
- PROPOSED 6" X 4" REDUCER, PER CITY OF VENICE STANDARD DETAILS.
- PROPOSED 2" METER AND BACKFLOW PREVENTOR, PER CITY OF VENICE STANDARD DETAIL
- PROPOSED 2" GATE VALVE, PER CITY OF VENICE STANDARD DETAIL
- PROPOSED 6"X2' TEE CONNECTION.
- PROPOSED 2" BLUE PE WATER SERVICE, PER CITY OF VENICE STANDARD DETAILS.
- PROPOSED FUTURE HOSE BIBB AT THE BUILDING. REFER TO ARCHITECTURAL PLANS.

FIRE:


- PROPOSED APPROXIMATE LOCATION FOR FIRE SERVICE LINE TIE IN TO THE BUILDING. REFER TO ARCHITECTURAL PLAN FOR DETAILS.
- PROPOSED FDC LOCATION. REFER TO ARCHITECTURAL PLANS.
- PROPOSED 4" BLUE PE FIRE SERVICE, PER CITY OF VENICE STANDARD DETAILS.

UTILITY NOTES:

- ALL DIMENSIONS ARE TO GROUND LEVEL IMPROVEMENTS (FACE OF CURB, CONCRETE SLAB, ETC.) UNLESS NOTED OTHERWISE. REFER TO ARCHITECTURAL PLANS FOR BUILDING DETAILS.
- ALL DIMENSIONS FROM PROPERTY LINES ARE PERPENDICULAR UNLESS OTHERWISE NOTED.
- CONTRACTOR TO SEED ALL DISTURBED AREA UNLESS NOTED OTHERWISE.
- THE CONTRACTOR IS SPECIFICALLY CAUTIONED THAT THE LOCATION AND / OR ELEVATION OF EXISTING UTILITIES AS SHOWN ON THESE PLANS IS BASED ON RECORDS OF THE VARIOUS UTILITY COMPANIES, AND WHERE POSSIBLE, MEASUREMENTS TAKEN IN THE FIELD. THE INFORMATION IS NOT TO BE RELIED UPON AS BEING COMPLETE OR EXACT. THE CONTRACTOR MUST CALL THE APPROPRIATE UTILITY COMPANIES AT LEAST 72 HOURS BEFORE ANY EXCAVATION TO REQUEST EXACT FIELD LOCATION OF UTILITIES. IT SHALL BE THE CONTRACTORS RESPONSIBILITY TO RELOCATE ALL EXISTING UTILITIES WHICH CONFLICT WITH THE PROPOSED IMPROVEMENTS SHOWN ON THE PLANS.
- REFER TO ARCHITECTURAL PLANS FOR SITE ELECTRICAL PLANS.

GENERAL NOTES:

- REFER TO COVER SHEET FOR VERTICAL DATUM.

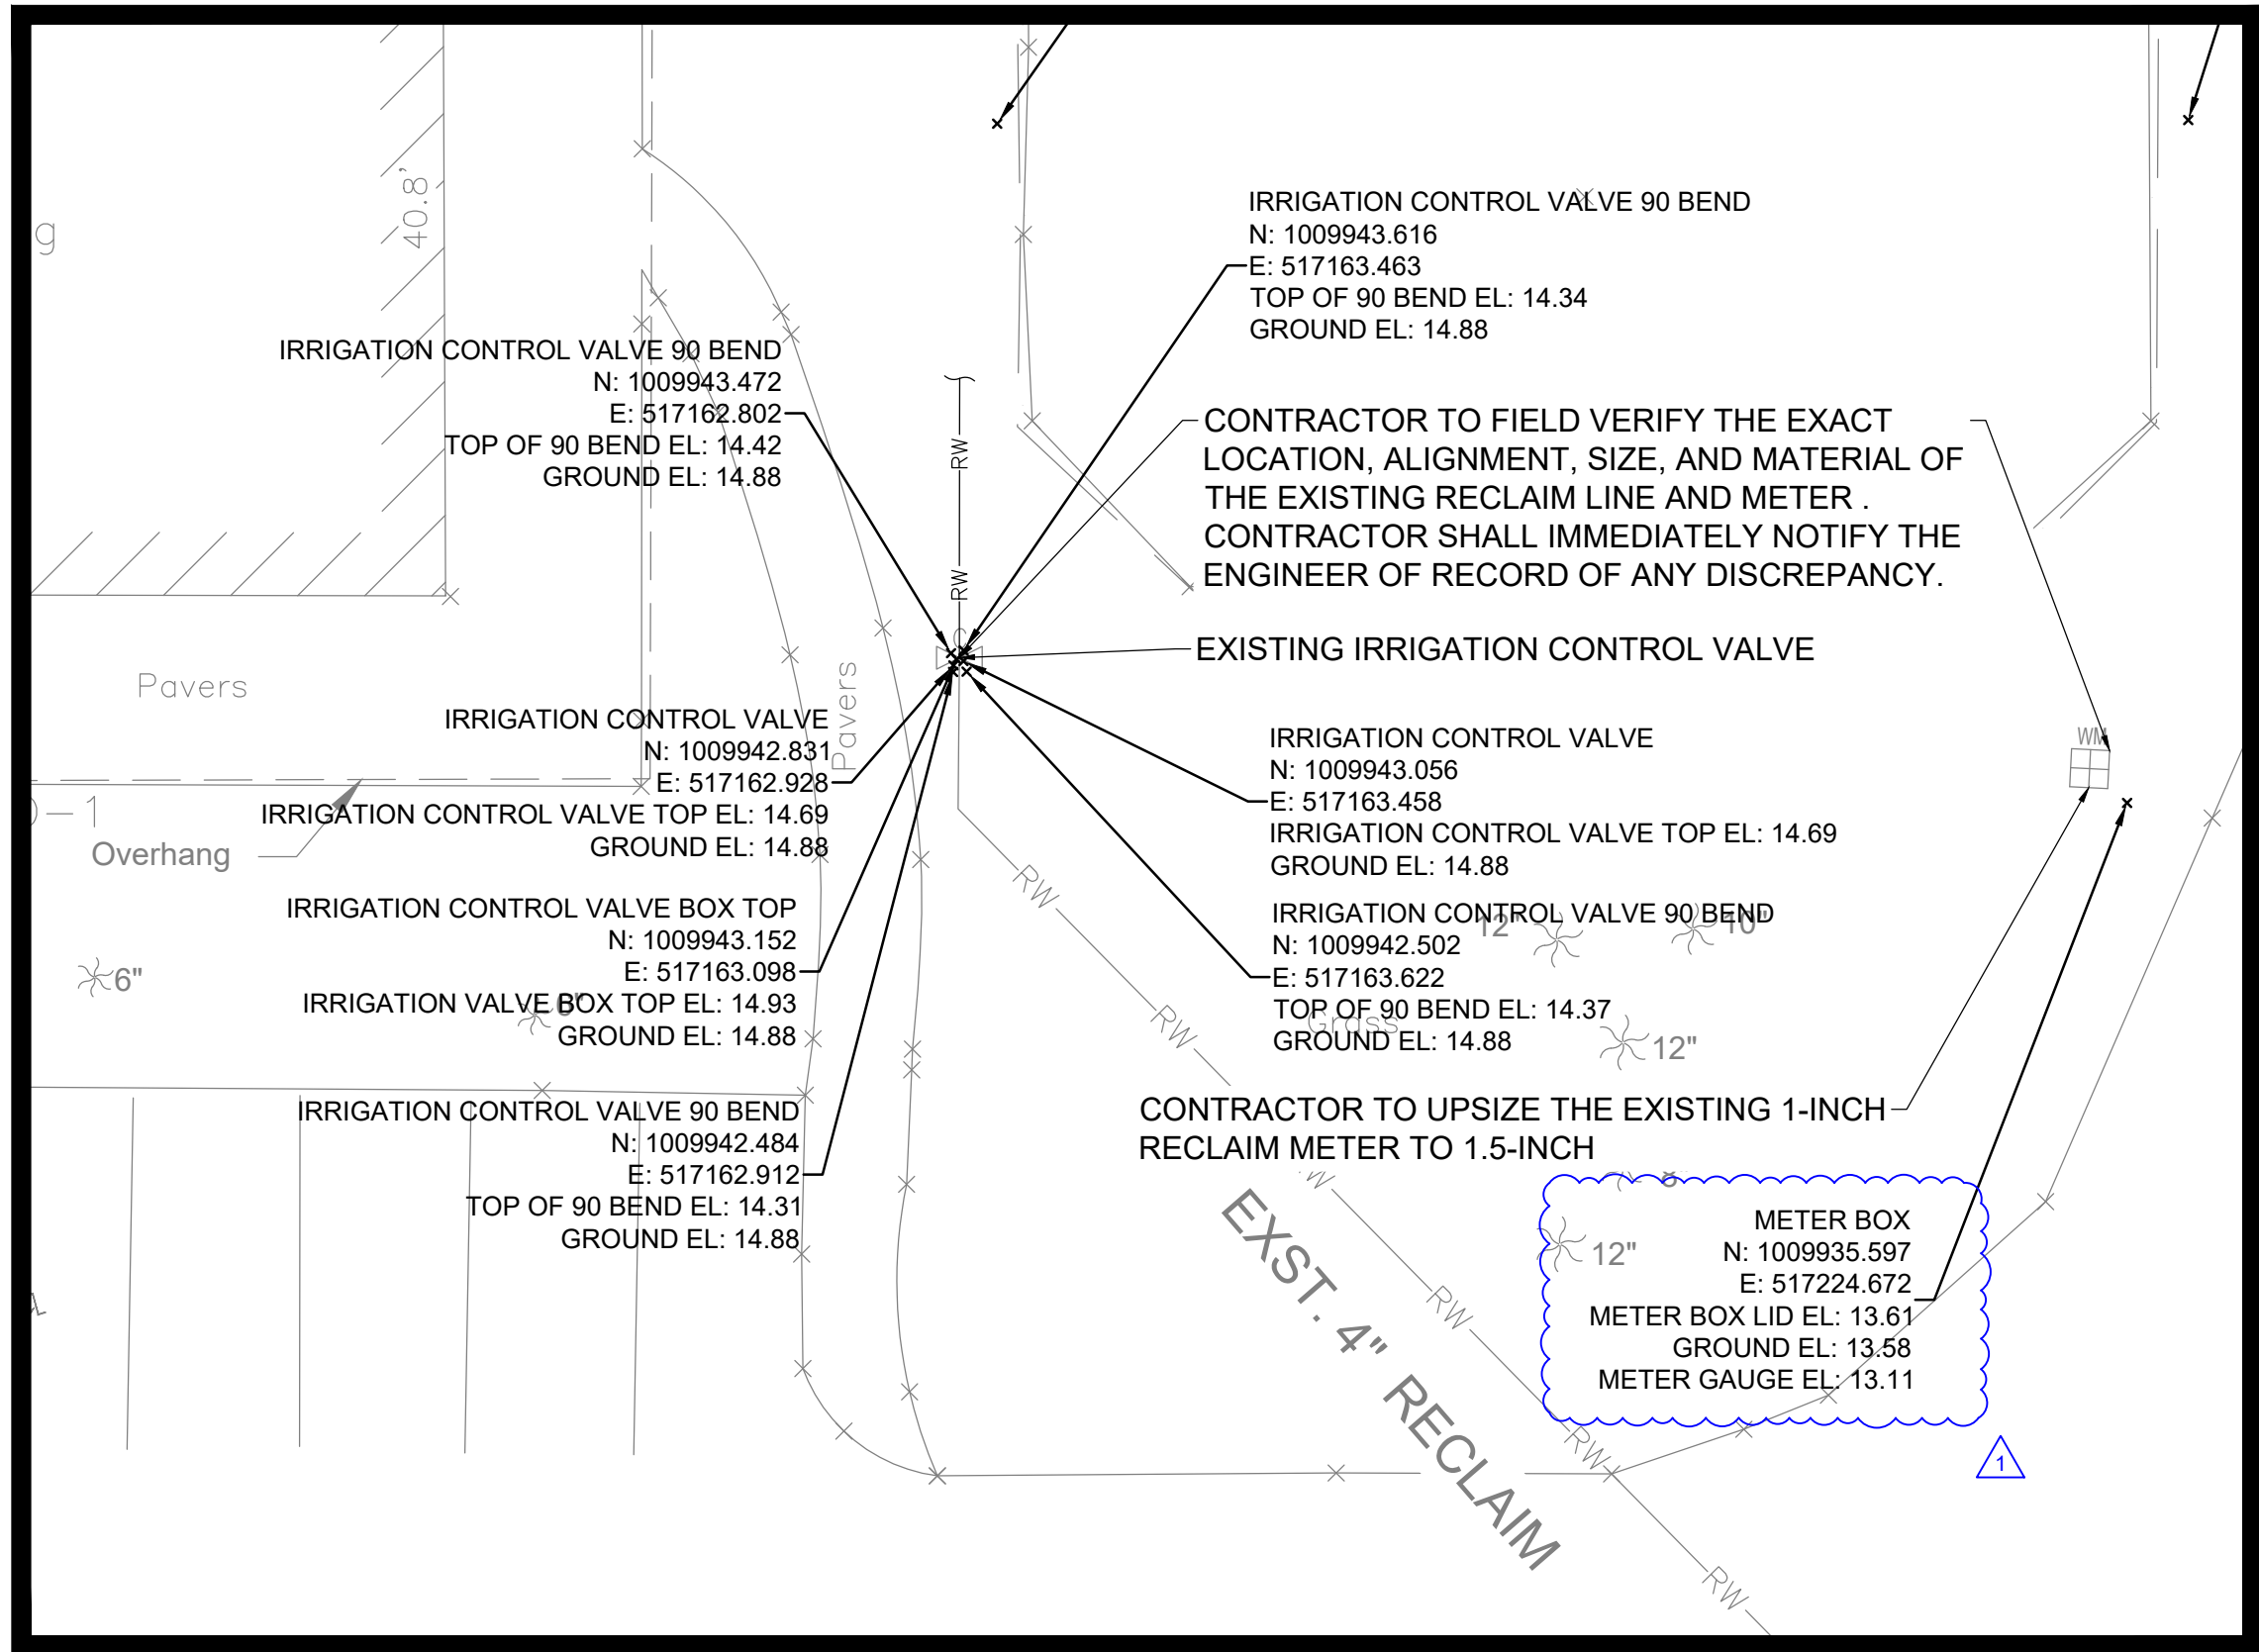

EXISTING RECLAIM METER LOCATION INSET

SCALE: 1" = 10'

Bowman

CERTIFICATE OF AUTHORIZATION LICENSE NO. 30462

BOWMAN CONSULTING GROUP, LTD.
5404 CYPRESS CEMTER DR
SUITE 140
TAMPA, FL 33609
PHONE: (813) 474-7424
BOWMAN.COM

OVERALL UTILITY PLAN
BAY INDIES CLUBHOUSE
950 RIDGEWOOD AVE
VENICE, FL 34285

CITY OF VENICE

811 KNOW WHAT'S BELOW ALWAYS CALL 811 BEFORE YOU DIG
www.call811.com

PROFESSIONAL ENGINEER
No. 47054
STATE OF FLORIDA
MOTHOY W. JOHNSON
LICENSE

PLAN STATUS

REV	DATE	COMMENT
1	2026/06/16	CITY OF VENICE REV1

MM	ADH	TJ
DESIGN	DRAWN	CHKD
SCALE	1" = 30'	
JOB No.	011528-01-001	
DATE	10/14/2024	

SHEET **C6.1**

NE CLUBHOUSE BLDG. CORNER
N: 1010434.5635
E: 517151.0551

COVERED DECK
980 SF

NEW CLUBHOUSE
± 10,300 SF
FFE ± 16.20'


COURTYARD GARDEN
930 SF

COVERED WALKWAY
635 SF

SE CLUBHOUSE BLDG. CORNER
N: 1010289.8979
E: 517149.9136

EXISTING FIRE HYDRANT
N: 1010327.968
E: 517329.621
TOP OF HYDRANT EL: 15.03

BAY INDIES BLVD

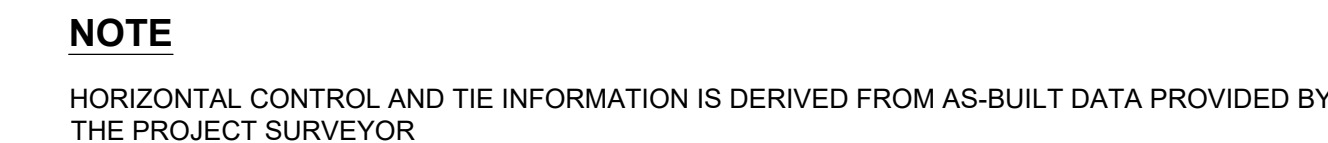

UTILITY LEGEND

	EXISTING PROPERTY BOUNDARY LINE
	EXISTING ADJOINING PROPERTY LINE
	EXISTING ACCESS EASEMENT
	EXISTING 5' INTERVAL CONTOUR LINE
	EXISTING 1' INTERVAL CONTOUR LINE
	PROPOSED 5' INTERVAL CONTOUR LINE
	PROPOSED 1' INTERVAL CONTOUR LINE
	EXISTING CURB
	PROPOSED CURB
	PROPOSED BUILDING
	PROPOSED WATER STRUCTURES
	PROPOSED SANITARY STRUCTURES
	PROPOSED WATER
	PROPOSED FIRE
	PROPOSED SANITARY
	PROPOSED ELECTRIC
	PROPOSED TELECOMMUNICATIONS
	EXISTING STORM STRUCTURES
	EXISTING SANITARY STRUCTURES
	EXISTING WATER STRUCTURES
	EXISTING STORM
	EXISTING WATER MAIN
	EXISTING SANITARY
	EXISTING UNDERGROUND ELECTRIC
	EXISTING OVERHEAD WIRES
	EXISTING TELEPHONE
	EXISTING GAS MAIN

