INC.

RECORD DRAWINGS September 24, 2021

APPROVED

CASSATA SQUARE

PARCELS B & C

WATER RECORD DRAWING

DEVELOPER:

MPS DEVELOPMENT AND CONSTRUCTION, LLC 333 SOUTH TAMIAMI TRAIL. SUITE 205 **VENICE, FL. 34285**

LEGAL DESCRIPTION:

Part of Lots 1, 2, 32, 33, 34, 35, 36 and 37, Block 79, VENICE GULF VIEW SECTION, recorded in Plat Book 2, Page 77, Public Records of Sarasota County, Florida; AND a partion of a vacated alley, per Resolution, recorded in Official Records Book 363, Page 107, Public Records of Sarasota County, Florida, described as follows:

Book 585, Page 107, Public Records of Sarasta County, Florida, described as follows:

BOOK at the Solthwest Corner of 15.47 Block 78, Qu'il Wiss Section of Verlace, as recorded in Pist Block 2, Page 77, of the Public Records of Sarasta County, Florida, same being a point on the North Right of Way line of Marin Avenue (80' Mich Public Relight of Way). There Seg 95757°T, doing said North Right of Way Line, a distance of 15.50' feet to the North Rien of a 20 feet wide alley at the Section of 18.50' feet to the North Rien of a 20 feet wide alley at the Section of 18.50' feet to the North Rien of a 20 feet wide alley at the Section of 18.50' feet to the North Rien of a 20 feet wide alley at the Section 19.50' feet to the North Rien 19.50' feet wide alley at the Section 19.50' feet wide alley at the Section 19.50' feet wide alley at the Section 19.50' feet to the Section 19.50' feet wide alley at the Section 19.50' feet wide alley at the Section 19.50' feet to the North Rien 19.50' feet wide alley at the Section 19.50' feet wide 19.50' feet to the North Section 19.50' feet wide 19.50' feet to the North Section 19.50' feet wide 19.50' feet to the North Section


Parcel contains 23290 square feet, or 0.5347 acres more or less.

DESCRIPTION: PARCEL "C"

All or part of Lots 2, 3, and 4, Block 79, VENICE GULF VIEW SECTION, recorded in Plat Book 2, Page 77, of the Public Records of Sarasota County, Florida, described as follows:

RECOVER OF STATEMENT COUNTY, FROMD, DESCRIBED AS TO ROBBET AS THE STATEMENT COUNTY, FROMD, DESCRIBED AS THE STATEMENT COUNTY, FROMD, THE

Parcel contains 10036 square feet, or 0.2304 acres more or less.

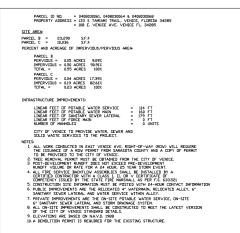



LOCATION MAP

SECTION 7 TOWNSHIP 39S RANGE 19E

CITY OF VENICE NOTES

ALL UTILITIES, WHETHER PUBLIC OR PRIVATE, SHALL MEET CITY OF VENICE STANDARDS. CONTACT PUBLIC WORKS SOLID WASTE DIVISION (941-486-2422) FOR APPROVAL OF DUMPSTER LOCATION AND LAYOUT PRIOR TO CONSTRUCTION.

UTILITIES

COMCAST CABLEVISION OF WEST FLORIDA, INC. SEOS FRUITVILLE ROAD SARASDIA, FL 34222

10-28-20

NO. DATE BY REVISIONS

REVISE NOTE 2 AS PER CITY COMMENTS.
REVISE COVER SHEET FOR RECORD DRAVINGS

CIVIL ENGINEER

PROFESSIONAL ENGINEERING RESOURCES. INC. 10225 ULMERTON ROAD, SUITE 4D LARGO, FL. 33771 (727) 408-5207

SURVEYOR

BRITT SURVEYING, INC. 606 CYPRESS AVE. VENICE, FL. 34285 (941) 493-1396

LANDSCAPE ARCHITECT

HAZELTINE NURSERIES, INC. P.O. BOX 236 VENICE, FL. 34292 (941) 485-1272


INDEX :


- 1. COVER SHEET
- 2. MASTER SITE PLAN
- -3. EXISTING CONDITION PLAN
- 4. SITE, SIGNAGE AND STRIPING PLAN
- 5. WATER AND SANITARY SEWER PLAN
- 6. DRAINAGE PLAN
- 7. GRADING PLAN
- 8. DIMENSIONING PLAN
- 9. MASTER UTILITY PLAN
- 10. SURVEY
- 11. DEMOLITION AND TREE REMOVAL PLAN
- 12. BEST MANAGEMENT PLAN
- 13. BEST MANAGEMENT DETAILS
- 14. GENERAL AND CONSTRUCTION NOTES
- 15-16. PAVING, GRADING AND DRAINAGE DETAILS
 - 17. REFUSE TRUCK TURNING MOVEMENT PLAN
 - 18. PROPOSED PARCEL MAP
 - 19. PROPOSED EASEMENT PLAN


- L1. PROPOSED LIGHTING PLAN





NO. 25628 MA.REG. INO. 35628

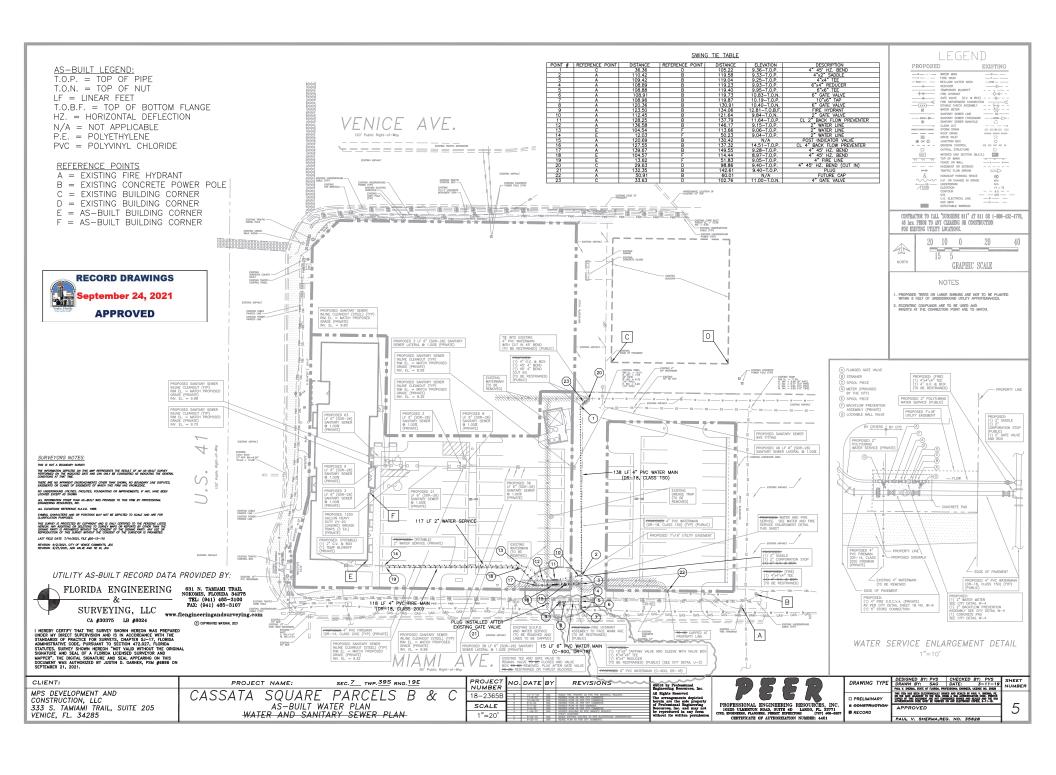


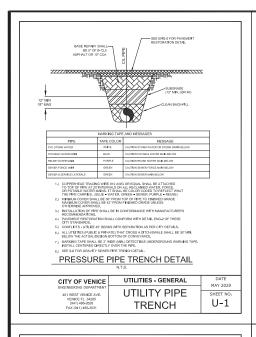


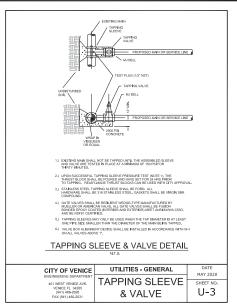


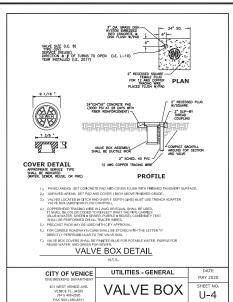

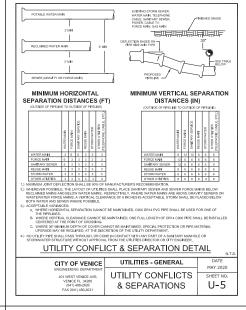

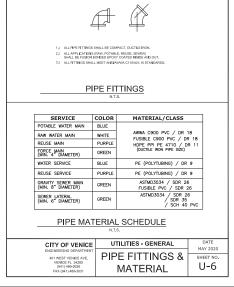

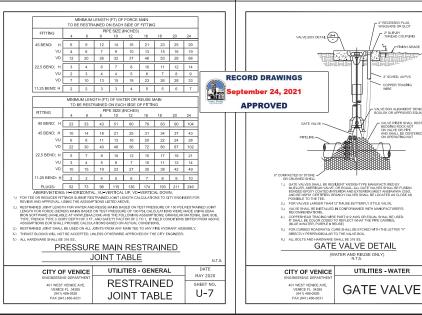

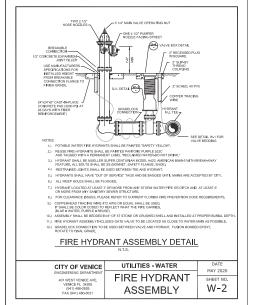


MAY 2020

SHEET NO.

W-1

DRAWING TYPE DESIGNED BY: PVS CHECKED BY: PVS DRAWN BY: SAG DATE: 3-11-19
MR. x Seelan Sittle Of Roma, INCORRANGE DESIGN, LIDER OF MESS CLIENT: SEC. 7 TWP. 395 RNG. 19E PROJECT NO. DATE BY REVISIONS SHEET PROJECT NAME: p2018 by Professional Engineering Resources, Inc. MPS DEVELOPMENT AND THE SITM WAS BEEN ELECTRONICALLY SIGNED AND SEALED BY PASK V. SHERMA, P.C. ON THE SATE ADJACENT TO THE SEAL USING A SHA MUNICIPATION CODE, PRINTED COPIES OF THIS SECULATOR ARE NOT CONCESSIONED SIGNED AND SEALED AND SEALE CASSATA SQUARE PARCELS B & C 18-2365E CONSTRUCTION, LLC 333 S. TAMIAMI TRAIL, SUITE 205 □ PRELIMINARY SCALE □ CONSTRUCTION APPROVED CITY OF VENICE WATER AND SEWER DETAILS VENICE, FL. 34285 N.T.S. 9-19-21 SAC REVISED THIS SHEET TO RECORD DRIVINGS 8-2-25 SAC ACCESS THIS SHEET AS PER ENGINEER.

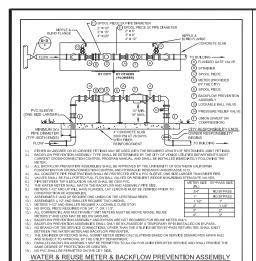

ABOVE GROUND COMMERCIAL/MULTI-UNIT/SINGLE SERVICE/MASTER METER (WITH BY-PASS AROUND METER ONLY) N.T.S.

UTILITIES - WATER

WATER & REUSE

METER & BACKFLOW


MAY 2020

W-4

CITY OF VENICE


401 WEST VENICE AVE.


VENICE FL 34285 (941) 486-2626 FAX (941) 480-3031

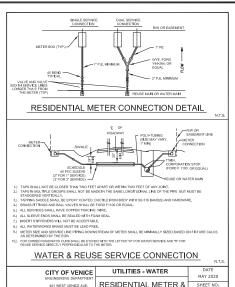



SERVICE CONNECTION


VENICE FL 34285 (941) 486-2626 FAX (941) 480-3031

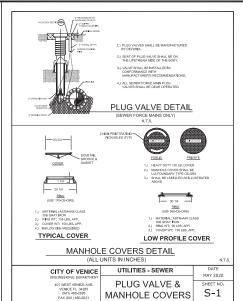

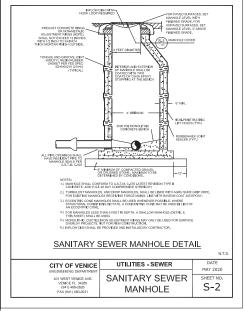

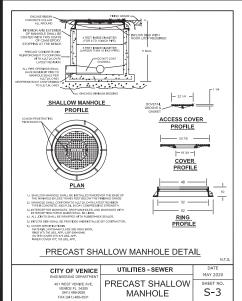

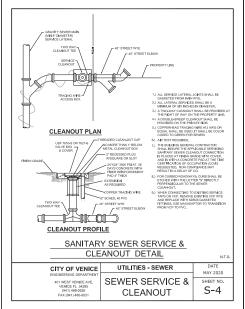

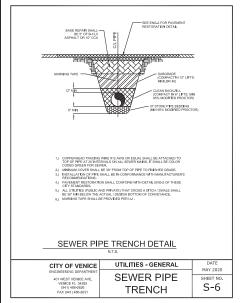



									_
CLIENT:	PROJECT NAME:	SEC. 7 TWP. 395 RNG. 19E	PROJECT NUMBER	MO BAILBI KETIOTO	c2018 by Professional Engineering Resources, Inc.		DRAWING TYPE	DESIGNED BY: PVS CHECKED BY: PVS SH DRAWN BY: SAG DATE: 3-11-19 NU.	HEET UMBER
MPS DEVELOPMENT AND CONSTRUCTION, LLC	CASSATA SOUA	ARE PARCEIS B & C	18-2365B	3	All Rights Reserved The arrangements depicted	5 6 K	□ PRELIMINARY	THE STEP WAS BODD DESTROYERALLY SHEEP AND SEALING THE FAST, VI. SECTION, M. CONTROL THE STEP ADMINISTRATION OF SEAL USING A STAN AND SEALING COOK. PRINCED COOKS OF THE DESCRIPTION OF SEAL USING A STAN AND SEALING COOK. PRINCED COOKS OF THE DESCRIPTION OF SEAL USING A STAN AND SEALING AND SEALING AND SEALING AND SEALING AND SEALING AND SEAL OF SEAL	\neg
333 S. TAMIAMI TRAIL, SUITE 205	0,,00,,,,	WATER AND SEWER DETAILS	SCALE	_	herein are the sole property of Professional Engineering Resources, inc. and may not be reproduced in any form PROFESSIONAL 10225 ULMERTON CIVIL ENGINEERS, PLANN	ENGINEERING RESOURCES, INC. ROAD, SUITE 4D LARGO, FL 33771 ES. PREMIT EXPENITORS (727) 408-5207	□ CONSTRUCTION ■ RECORD	APPROVED	21
VENICE, FL. 34285	OITT OF VENTOE	WATER AND SEVEN BETALES	N.T.S.	2 8-19-21 SAG MEVISION THIS SHEET TO RECORD SHAWING 1 8-9-20 SAG ACCEPT THIS SHEET AS PER ENGINEER.		F AUTHORIZATION NUMBER: 4401		PAUL V. SHERMA.REG. NO. 35628	

W-8