FLOOD ZONE: THE SITE APPEARS TO LIE WITHIN FLOOD ZONE "X" ACCORDING TO FEDERAL EMERGENCY MANAGEMENT AGENCY (FEMA) - FLOOD INSURANCE RATE MAP (FIRM) COMMUNITY-PANEL NO. 125144 0244 F (MAP NUMBER IJISCO244F, FREVISED NOVEMBER 4, 2016.

SETBACKS: SETBACKS: STREET YARD SIDE YARD: REAR YARD:

CHIBMONE DE L'ATTE SOURCE DE L'ATTE DE L'ATTE

THE WASTERNEY, THE WASTE, AND THE AND ANASON AND THE AND ANASON WILLTH PRINTS

A BUTTO DITTAINING CONSTRUCTION AND A BUT ACCORDANCE WITH SAMASOTA COUNTY SECURICAL

A WASTER WASTERNIA CONTROLLED AND A BUTTO OF A COUNTY SECURICAL

A WASTER WASTER CONTROLLED AND A BUT AND A COUNTY SECURICAL

LOCATION AS A WASTERNIA CONTROLLED AND A BUTTON

LOCATION AS A WASTERNIA CONTROLLED AND A COUNTY SECURICAL

AND A WASTERNIA CONTROLLED AND A COUNTY SECURICAL

AND A WASTERNIA CONTROLLED AND A COUNTY SECURICAL

AND A WASTERNIA CONTROLLED AND A COUNTY SECURITY S

MRIT MUST DE CORTARDO FINO CITY OF VENICE ARJUNDA, RESOUNCES IT MONOFT DES DOS ESCRED FINE-DEVENIFORME AND Y COUNTER OR MUST, 23-1-56, A STORM EVERY STORME EVERY COUNTER OR A CERTIFICIO FINALLO RE INSTALLED BY A CERTIFICATO FINALLO REPORTED BY THE MUST A CERTIFICATO FINALLO REPORTED BY THE MUST A CERTIFICATO FINALLO REPORTED BY THE MUST A CERTIFICATOR OF THE MUST AND THE MUST A COUNTER PROBLEM OF THE MUST A COUNTER PROBLEM OF THE MUST AS COUNTER FINALLO REPORTED SERVICE MODION SARASOTA COUNTER PROBLEM OF THE MUST AS COUNTER FINALLO REPORTED SERVICE MODION SARASOTA COUNTER PROBLEM OF THE MUST AS COUNTER FINALLO REPORTED SERVICE MODION SARASOTA COUNTER PROBLEM OF THE MUST AS COUNTER FINALLO REPORTED SERVICE MODION SARASOTA COUNTER PROBLEM OF THE MUST AS COUNTER FINALLO REPORTED SERVICE MODION SARASOTA COUNTER FINALLO REPORTED SERVICE MODION SARASOTA COUNTER FINALLO REPORTED SERVICE FINALLO REPORE FINALLO REPORTED SERVICE FINALLO REPORTED SERVICE FINALLO REPOR

PERMIT / FILE NOS.			
ADDRESS / CONTROL NO.			
WATER COMMITMENT			
SEWER COMMITMENT			
SWFWMD			
WATER DEP			
SEWER DEP			
PARCEL ID	0389-01-0000, 0389-01-0001		

INFRASTRUCTURE IMPROVEMENTS				
LINEAR FEET OF POTABLE WATER (8°)	-	2,332	LF	
LINEAR FEET OF POTABLE WATER (4°)	-	404	LF	
LINEAR FEET OF RECLAIM MAIN (6")	-	119	LF	
LINEAR FEET OF SANITARY SEWER MAIN	-	2,081	LF	
LINEAR FEET OF FORCE MAIN	-	1050	LF	

CITY OF VENICE TO PROVIDE POTABLE WATER.

SARASOTA COUNTY TO PROVIDE SANITARI SEWER TO THE PROJECT





SARASOTA COUNTY, FLORIDA SECTION 34, TOWNSHIP 38 SOUTH, RANGE 19 EAST

	PUD RE	ZONE	SUM OF PLAT WITHIN MI			Y PLAT CIELO SE 1	PRELIMINARY (AKA CIELO	
LAND USE	AREA (AC.)	96	AREA (AC.)	%	AREA (AC.)	%	AREA (AC.)	%
RESIDENTIAL	182	34.5%	108.51	27.0%	15.63	17.4%	6.65	18.7%
AMENITY AREA	4	0.8%	4.87	1.2%	1.05	1.2%	0.52	1.5%
ROAD ROW	50	9.5%	32.41	8.1%	4.56	5.1%	2.35	6.6%
WETLANDS	131		74.33		39.58		8.56	
CONSERVATION	9		18.48		6.06		3.25	
LAKES	94		95.55		10.213		4.347	
OTHER OPEN SPACE	57		78.85		13.077		9.84	
TOTAL OPEN SPACE	291	55.2%	267.71	66.6%	68.93	76.6%	26.00	73.2%
IMPERVIOUS	N/A		103.16	25.7%	8.623	9.6%	10.597	29.8%
TOTAL AREA	527.32	100%	401.82	100%	89.98	100%	35.52	100%
LOT TYPE					a a			
SINGLE FAMILY			239		0		0	
DETACHED A LOTS	N/A		255			U .		U.
SINGLE FAMILY	80.07075		99			71	0	1
DETACHED B LOTS SINGLE FAMILY	N/A	٩						
ATTACHED (PAIRED			12	e.	0		0	
VILLAS)	N/A	4	120		, and the second			
MULTI FAMILY	N/A		0		0		0	
SINGLE FAMILY								
DETACHED D LOTS	N/A		107		0		0	
SINGLE FAMILY				73		0	0	
DETACHED E LOTS	N/A		/3		0		0	
SINGLE FAMILY ATTACHED (TOWNHOME)	N/A		0		0		126	
LOT TOTAL	135	0	64	4	71		126	
DU/AC	2.5	2.56		i3	0.79		3.55	



March 3, 2022

APPROVED

UTILITIES RECORD DRAWINGS

FIORE

(F.K.A. CIELO PH. 2)

HEET NO.	DESCRIPTION
1	COVER SHEET
- 2	EXISTING SITE CONDITIONS & DEMOLITION PLAN
	MASTER SITE PLAN
	AERIAL SITE PLAN
5-7	SITE PLAN
- 8	TYPICAL ROADWAY SECTIONS
9	MASTER DRAINAGE PLAN
10-12	NEIGHBORHOOD GRADING PLAN
13-14	CROSS SECTIONS
15	DRAINAGE STRUCTURE DATA
16	MASTER UTILITY PLAN
17	WATER & SEWER PLAN
18-20	ROADWAY PLAN & PROFILE
21	SIDEWALK, SIGNING & PAVEMENT MARKING PLAN
	PUMP STATION DESIGN
23	PUMP STATION DETAILS
24-25	DRAINAGE DETIALS
26	GENERAL ENGINEERING
27-28	SIDEWALK DETAILS
29	GENERAL UTILITIES
30-31	POTABLE WATER SYSTEM DETAILS
32-33	SANITARY SEWER SYSTEM DETAILS
34	INTERSECTION IMPROVEMENTS
35	PRE DEVELOPMENT DRAINAGE AREA
36	POST DEVELOPMENT DRAINAGE AREA
37	SURFACE WATER MANAGEMENT PLAN
38	ADDRESS PLAN
39	AMENDMENT COMPARISON
L1-L9	PERMIT LANDSCAPE PLANS
L10-L11	TREE REMOVAL PLANS
LIU-LII	
	CEC PLANS (BY OTHERS)
	STANDARD FABRICATION PLANS FOR SINGLE & THREE PHASE
	DUPLEX MOTOR CONTROL PANELS
	MOTOR CONTROL PANEL LAYOUT
2	MOTOR CONTROL PANEL-BILL OF MATERIALS
3A-3B	MOTOR CONTROL PANEL WIRING
4A-4B	CONTROL SCHEMATIC
	STANDARD INSTALLATION PLANS FOR DUPLEX MOTOR
	CONTROL PANEL (MCP) AND REMOTE TELEMETRY UNIT (RTU)
1-3	PANEL INSTALLATION DETAILS
	STANDARD FABRICATION PLANS FOR PLC REMOTE TELEMETRY
	RTU PANEL LAYOUT
2	RTU PANEL BILL OF MATERIALS
3-4A	RTU PANEL WIRING

P⊕INT BREAK SURVEYING, LLC

NEAL COMMUNITIES

5800 Lakewood Ranch Blvd. N. Saraota, Florida 34240 Phone: (941) 328-1111

PREPARED BY:



Clearview LAND DESIGN, P.L.

Engineering Business C.A. No.: 28858 3010 W Azeele St., Suite 150, Tampa, Florida 33609 Office: 813-223-3919 Fax: 813-223-3975

THE ENGINEER OR SURVEYOR, WITH INFORMATION PROVIDED BY THE CONTRACTOR, SHALL PROVIDE RECORD DRAWINGS THAT MEET THE REQUIREMENTS OF THE SARASOTA COUNTY UNIFORM WASTEWATER CODE, LATEST EDITION.







02.24.2022	REVISE RECORD DRAWINGS 188-208	JRC	Th
01-26-2022	RECORD DRAWINGS	JRC	l,
09-20-2021 08-16-2021 07-24-2021	12,15 17-20,22,23 9,11,12,15	CMF CMF CMF	"
06-18-2021	11,14,15,19,20,L1,L5,L7	CMF	_
04-21-2021	13,15	CMF	DAT
04-06-2021	22,23,29-31 8.12.15-17.16	CMF	1
12,05,2020	1.8.12.14.16-19.26.29-31	CMF	_
08-04-2020	1.16.17	GLN	
06-24-2020	1.6.38.L1-L7	CMF	
04-20-2020 03-10-2020	1-7,11-13,17-19 1.17.37	CMF CMF	Г
12-20-2019	PERMIT PLANS	CMF	DES
DATE	GHETTENO		DD.


REVISIONS


(F.K.A. CIELO PH. 2)
(F.R.A. CIELO I II. 2)
n digitally signed and scaled by CHRISTOPHER M. FISHER, P.E. on the date adjacent to the inted copies of this document are not considered signed and scaled and the signature must be verified on any electronic copies.
CHRISTOPHER FISHER NO. 85555 FLORIDA PROFESSIONAL ENGINEER


DATE: 02-24-2022	JOB NO. NCI-CO-003
	National Geodetic Vertical Datum (NGVD 29) om NGVD 29 to NAVD 88 = -1.11 Feet
STREET & DRAINAG	GE WATER & SANITARY SEWER
DESIGNED BY: CMF DRAWN BY: DNS	DESIGNED BY: CMF DRAWN BY: DNS
FILE: CV	SHEET 1 OF 39
	02-24-2022 Elevations based on Conversion fro STREET & DRAINAG DESIGNED BY: CMF DRAIN BY: DN5 FILE:

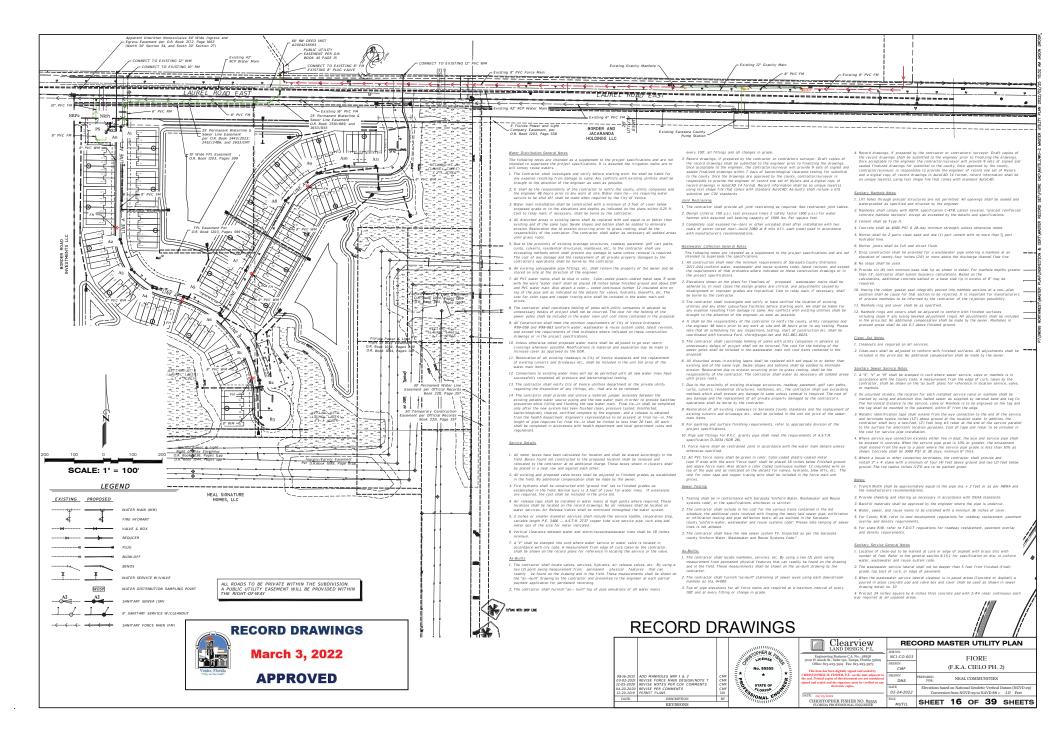


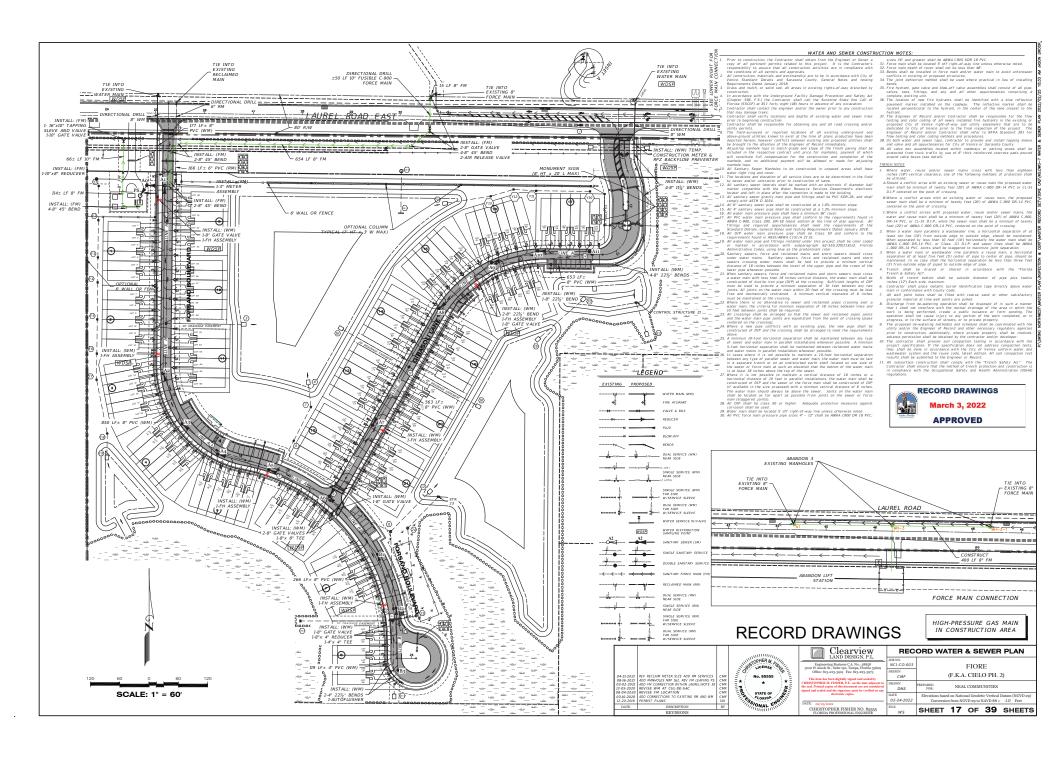


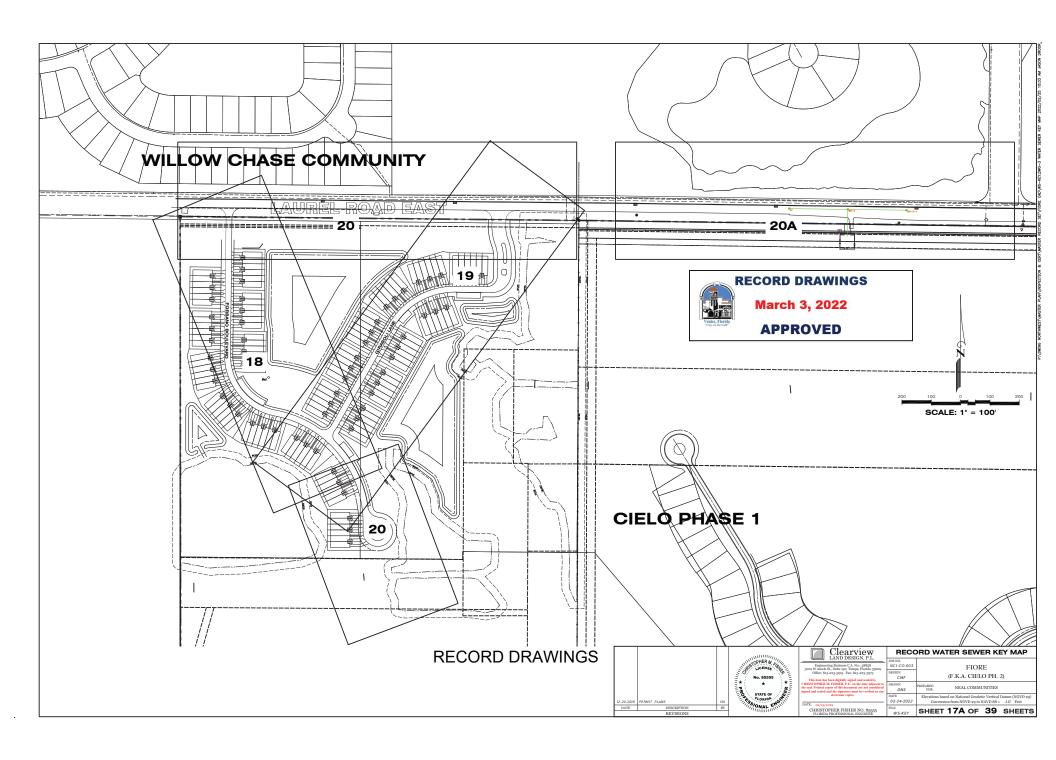

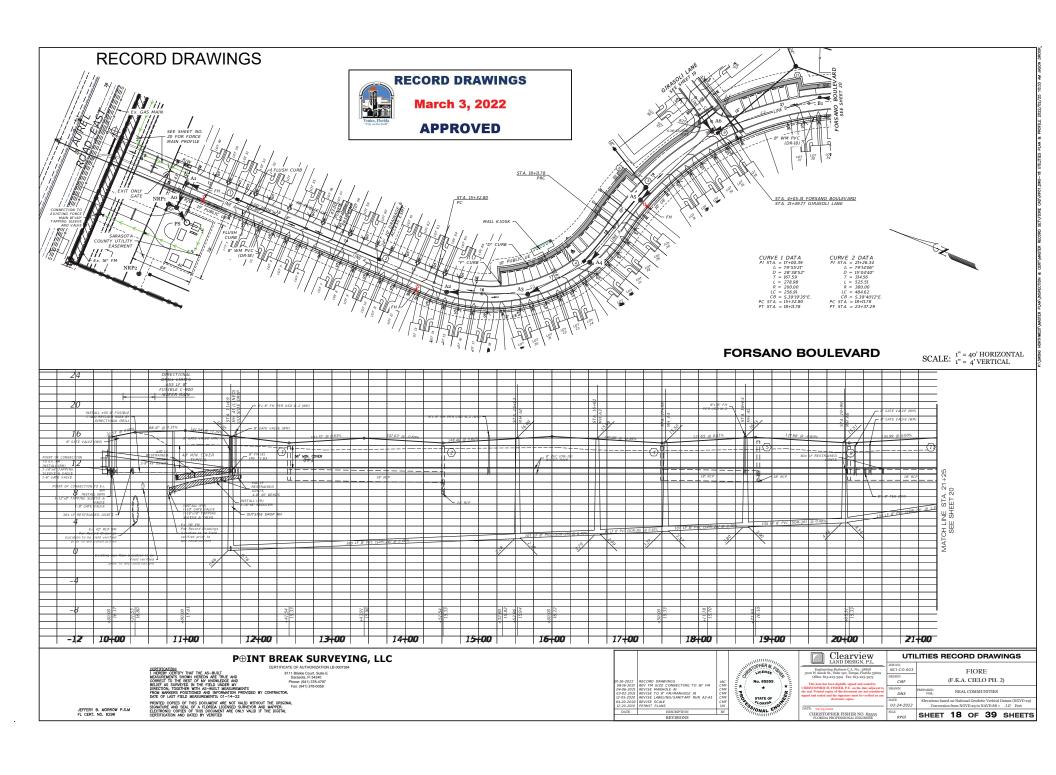

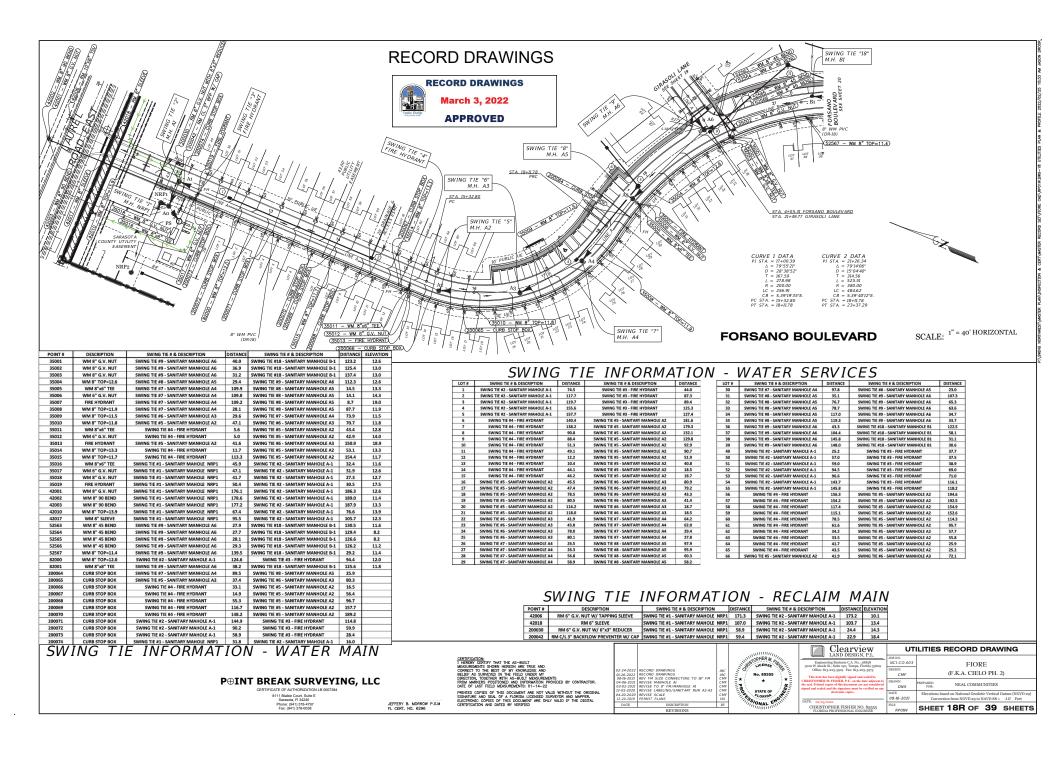

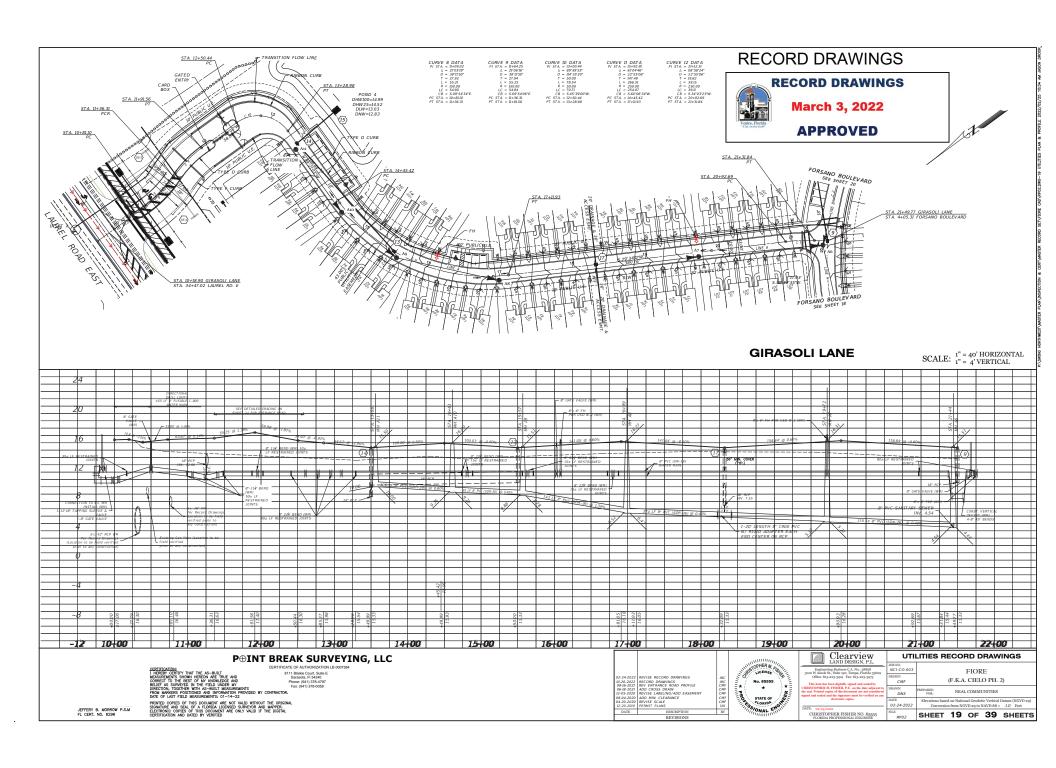

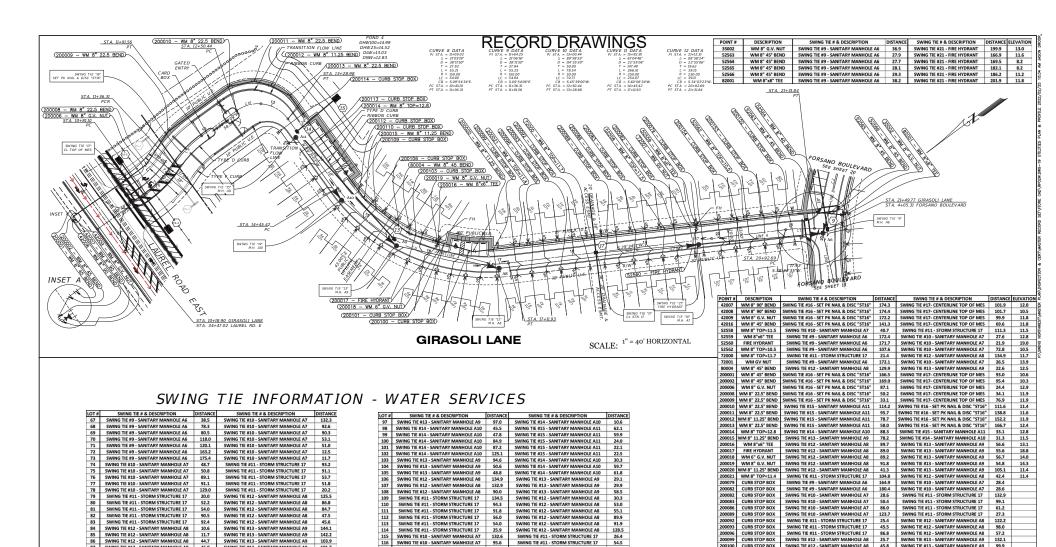

P⊕INT BREAK SURVEYING, LLC

CERTIFICATE OF AUTHORIZATION LB 0007384 8111 Blaikle Court, Suite E Sarasota, Fl 34240 Phone: (941) 378-4797

SWING TIE #13 - SANITARY MANHOLE A9

SWING TIE #13 - SANITARY MANHOLE A9

SWING TIE #13 - SANITARY MANHOLE A9

SWING TIE #14 - SANITARY MANHOLE A10

SWING TIE #14 - SANITARY MANHOLE A10
SWING TIE #14 - SANITARY MANHOLE A10

SWING TIE #14 - SANITARY MANHOLE A10

SWING TIE #13 - SANITARY MANHOLE A9
SWING TIE #14 - SANITARY MANHOLE A10

SWING TIE #13 - SANITARY MANHOLE A9 63.4

46.8

SWING TIE #12 - SANITARY MANHOLE A8

SWING TIE #12 - SANITARY MANHOLE A8

SWING TIE #12 - SANITARY MANHOLE A8 85.1

SWING TIE #12 - SANITARY MANHOLE A8 122.9

SWING TIE #12 - SANITARY MANHOLE A8 124.9

SWING TIE #13 - SANITARY MANHOLE A9 20.9
ELVING TIE #13 - SANITARY MANHOLE A9 22.5

SWING TIE #13 - SANITARY MANHOLE A9 57.3
SWING TIE #13 - SANITARY MANHOLE A9 59.6

SWING TIE #13 - SANITARY MANHOLE A9 95.2



SWING TIE #10 - SANITARY MANHOLE A7 93.5

SWING TIE #10 - SANITARY MANHOLE A7 59.5

SWING TIE #10 - SANITARY MANHOLE A7

SWING TIE #9 - SANITARY MANHOLE A6

57.7

SWING TIE #9 - SANITARY MANHOLE A6

174.0

SWING TIE #9 - SANITARY MANHOLE A6 125.1

SWING TIE #9 - SANITARY MANHOLE A6 122.9

SWING TIE #9 - SANITARY MANHOLE A6 87.6

SWING TIE #9 - SANITARY MANHOLE A6 85.6

SWING TIE #9 - SANITARY MANHOLE A6 49.6

SWING TIE #11 - STORM STRUCTURE 17

SWING TIE #10 - SANITARY MANHOLE A7 31.1

SWING TIE #10 - SANITARY MANHOLE A7 58.4

SWING TIE #10 - SANITARY MANHOLE A7 60.5
SWING TIE #10 - SANITARY MANHOLE A7 94.7

SWING TIE #10 - SANITARY MANHOLE A7 96.9
SWING TIE #10 - SANITARY MANHOLE A7 137.6

SWING TIE #11 - STORM STRUCTURE 17

SWING TIE #11 - STORM STRUCTURE 17

SWING TIE #10 - SANITARY MANHOLE A7

02-24-2022 01-26-2022 08-16-2021 06-18-2021 12-05-2020 08-04-2020 04-20-2020 12-20-2019	REVISED RECORD DRAWINGS RECORD DRAWINGS REV ENTRANCE ROAD PROFILE ADD CROSS DRAIN REVISE LABELING/ADD EASEMENT ADD MIN. CLEARANCE REVISE SCALE PERMIT PLANS	JRC JRC CMF CMF CMF CMF CMF INI	
DATE	DESCRIPTION		
	REVISIONS		



CURB STOP BOX

CURB STOP BOX

CURB STOP BOX

CURB STOP BOX

SWING TIE INFORMATION - WATER MAIN UTILITIES RECORD DRAWINGS Clearview CMF DNS

200132 CURS STOP BOX SWINGT IE 93-SMITTARY MONHHOLD ALL 32.2 SWINGT IE 93-SMITTARY MONHHOLD AT 313.2 SWINGT IE 93-SMITTARY MONHHOLD AS 94.7 SWINGT IE 93-SWINGT I

80.9

121.2

SWING TIE #12 - SANITARY MANHOLE A8

SWING TIE #12 - SANITARY MANHOLE A8

SWING TIE #13 - SANITARY MANHOLE A9

SWING TIE #15 - SANITARY MANHOLE A11

SWING TIE #13 - SANITARY MANHOLE A9 57.5

SWING TIE #14 - SANITARY MANHOLE A10 87.9

FIORE (F.K.A. CIELO PH. 2) CHRISTOPHER FISHER NO. 85555 SHEET 19R OF 39 SHEETS


SWING TIE #13 - SANITARY MANHOLE A9
SWING TIE #13 - SANITARY MANHOLE A9


SWING TIE #13 - SANITARY MANHOLE A9

SWING TIE #14 - SANITARY MANHOLE A10

SWING TIE #14 - SANITARY MANHOLE A10 48.7

SWING TIE #15 - SANITARY MANHOLE A11 32.6

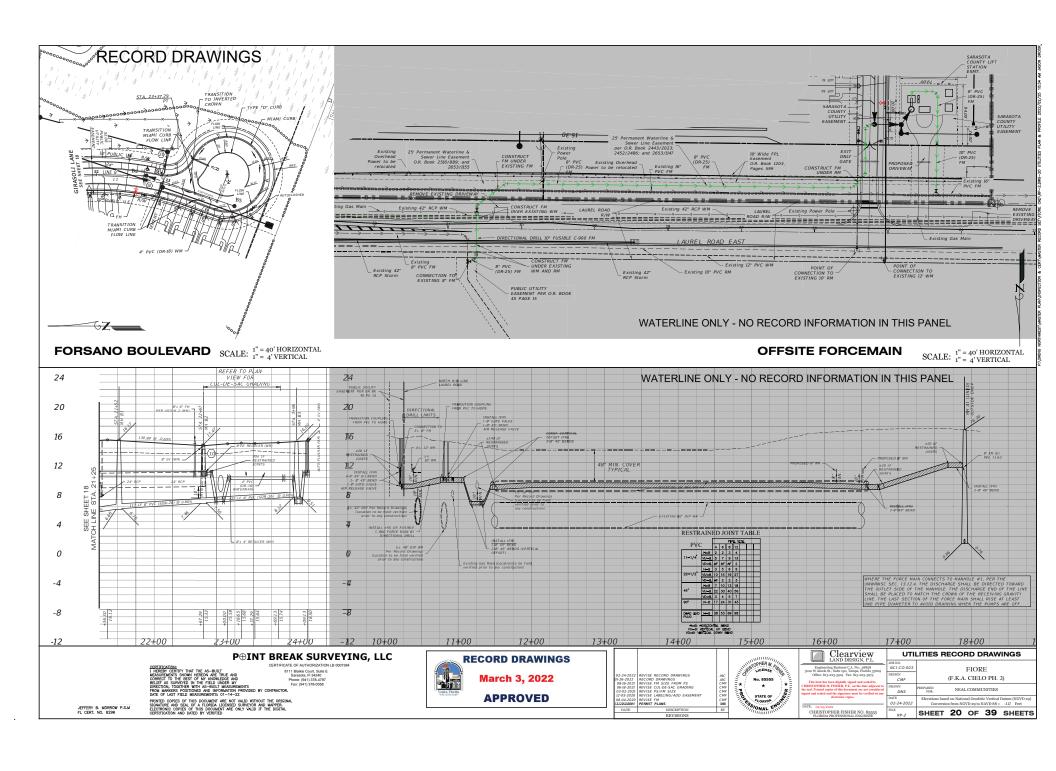

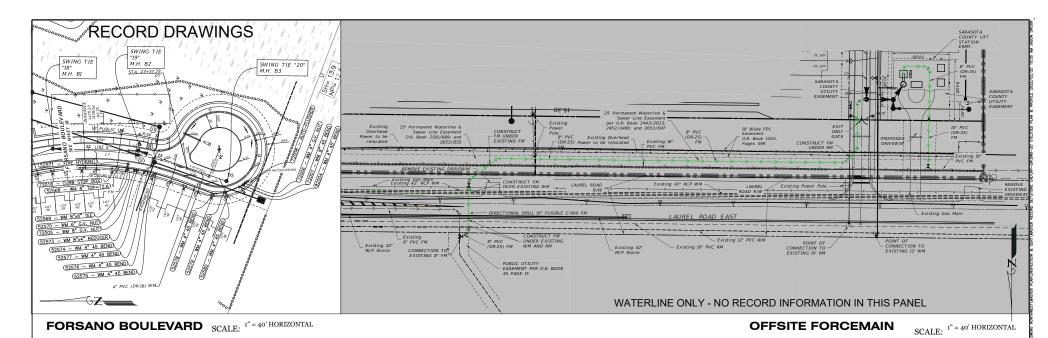

SWING TIE INFORMATION - WATER SERVICES

LOT#	SWING TIE # & DESCRIPTION	DISTANCE	SWING TIE # & DESCRIPTION	DISTANCE
40	SWING TIE #18 - SANITARY MANHOLE B-1	46.5	SWING TIE #19 - SANITARY MANHOLE B-2	83.7
41	SWING TIE #18 - SANITARY MANHOLE B-1	48.3	SWING TIE #19 - SANITARY MANHOLE B-2	81.5
42	SWING TIE #18 - SANITARY MANHOLE B-1	85.3	SWING TIE #19 - SANITARY MANHOLE B-2	45.2
43	SWING TIE #19 - SANITARY MANHOLE B-2	40.0	SWING TIE #20 - SANITARY MANHOLE B-3	101.3
44	SWING TIE #19 - SANITARY MANHOLE B-2	76.9	SWING TIE #20 - SANITARY MANHOLE B-3	60.1
45	SWING TIE #19 - SANITARY MANHOLE B-2	79.0	SWING TIE #20 - SANITARY MANHOLE B-3	58.0
46	SWING TIE #19 - SANITARY MANHOLE B-2	115.2	SWING TIE #20 - SANITARY MANHOLE B-3	30.1
47	SWING TIE #19 - SANITARY MANHOLE B-2	117.1	SWING TIE #20 - SANITARY MANHOLE B-3	28.6
48	SWING TIE #19 - SANITARY MANHOLE B-2	152.1	SWING TIE #20 - SANITARY MANHOLE B-3	26.4
OG PARK	SWING TIE #18 - SANITARY MANHOLE B-1	95.3	SWING TIE #19 - SANITARY MANHOLE B-2	34.0

SWING TIE INFORMATION - WATER MAIN

POINT #	DESCRIPTION	SWING TIE # & DESCRIPTION	DISTANCE	SWING TIE # & DESCRIPTION	DISTANCE	ELEVATION
52568	WM 8" TOP=12.6	SWING TIE #18 - SANITARY MANHOLE B-1	93.6	SWING TIE #19 - SANITARY MANHOLE B-2	35.3	12.6
52569	WM 8"x6" TEE	SWING TIE #18 - SANITARY MANHOLE B-1	104.6	SWING TIE #19 - SANITARY MANHOLE B-2	29.2	12.3
52570	WM 6" G.V. NUT	SWING TIE #18 - SANITARY MANHOLE B-1	104.5	SWING TIE #19 - SANITARY MANHOLE B-2	28.3	13.3
52571	FIRE HYDRANT	SWING TIE #18 - SANITARY MANHOLE B-1	105.0	SWING TIE #19 - SANITARY MANHOLE B-2	23.3	18.0
52573	WM 8"x4" REDUCER	SWING TIE #19 - SANITARY MANHOLE B-2	27.0	SWING TIE #20 - SANITARY MANHOLE B-3	123.2	11.5
52574	WM 8" 45° BEND	SWING TIE #19 - SANITARY MANHOLE B-2	28.1	SWING TIE #20 - SANITARY MANHOLE B-3	113.5	10.6
52575	WM 8" 45° BEND	SWING TIE #19 - SANITARY MANHOLE B-2	39.1	SWING TIE #20 - SANITARY MANHOLE B-3	98.0	10.9
52576	WM 8" 45° BEND	SWING TIE #19 - SANITARY MANHOLE B-2	37.2	SWING TIE #20 - SANITARY MANHOLE B-3	100.1	8.3
52577	WM 8" 45° BEND	SWING TIE #19 - SANITARY MANHOLE B-2	30.6	SWING TIE #20 - SANITARY MANHOLE B-3	108.7	8.0
52578	WM 4" 45° BEND	SWING TIE #19 - SANITARY MANHOLE B-2	117.3	SWING TIE #20 - SANITARY MANHOLE B-3	25.2	11.1
52579	WM 4" 45° BEND	SWING TIE #19 - SANITARY MANHOLE B-2	128.7	SWING TIE #20 - SANITARY MANHOLE B-3	17.2	11.1
52580	WM 4" 45° BEND	SWING TIE #19 - SANITARY MANHOLE B-2	130.1	SWING TIE #20 - SANITARY MANHOLE B-3	15.7	8.1
72005	WM 8" G.V. NUT	SWING TIE #19 - SANITARY MANHOLE B-2	26.4	SWING TIE #20 - SANITARY MANHOLE B-3	126.7	13.3
72006	WM 4" G.V. NUT	SWING TIE #19 - SANITARY MANHOLE B-2	149.5	SWING TIE #20 - SANITARY MANHOLE B-3	23.6	12.7
72007	WM 8" 45° BEND	SWING TIE #19 - SANITARY MANHOLE B-2	147.7	SWING TIE #20 - SANITARY MANHOLE B-3	21.5	11.5
72008	AUTO-FLUSHER	SWING TIE #19 - SANITARY MANHOLE B-2	151.7	SWING TIE #20 - SANITARY MANHOLE B-3	26.3	15.9
72018	CURB STOP BOX	SWING TIE #18 - SANITARY MANHOLE B-1	90.9	SWING TIE #19 - SANITARY MANHOLE B-2	37.3	
82004	WM 4" 45° BEND	SWING TIE #19 - SANITARY MANHOLE B-2	144.4	SWING TIE #20 - SANITARY MANHOLE B-3	18.3	8.2

RECORD DRAWINGS

March 3, 2022

APPROVED


THERE THE FORCE MAIN CONNECTS TO MANHOLE #1. PER THE WINWFINS CS ECS 13.124. THE OSCIANGES SHALL BE DIRECTED TOWARD THE OUTLET SIDE OF THE MANHOLE THE DISCHARGE FIND OF THE LINL SHALL BE PLACED TO MAICH THE CROWN OF THE RECEIVING GRAVITY LINE. THE LAST SECTION OF THE FORCE MAIN SHALL RISE AT LEAST ONE PIPE DIAMETER TO AUGUD DRAINING WHEN THE PUMPS ARE OFF.


P⊕INT BREAK SURVEYING, LLC





LINE. T	HE LAST SECT	MATCH THE CROWN OF THE RECEIVING GRAVITY TION OF THE FORCE MAIN SHALL RISE AT LEAST TO AVOID DRAINING WHEN THE PUMPS ARE OFF.
Clearview		LITIES RECORD DRAWINGS
Engineering Business C.A. No.: 28858 2010 W Azsele St., Suite 150, Tampa, Florida 23600	JOB NO. NCI-CO-003	FIORE
Office: 813-223-3919 Fax: 813-223-3975	DESIGN CMF	(F.K.A. CIELO PH. 2)


This item has been diritally signed and scaled by	CMF	(F.K.A. CILLO I II. 2)		
	DRAWN DNS	PREPARED NEAL COMMUNITIES FOR:		
	DATE 08-16-2022	Elevations based on National Geodetic Vertical Datum (NGVD 29) Conversion from NGVD 29 to NAVD 88 = -1.11 Feet		
CHRISTOPHER FISHER NO. 85555 FLORIDA PROFESSIONAL ENGINEER	FILE RECORD 20A	SHEET 20R OF 39 SHEETS		

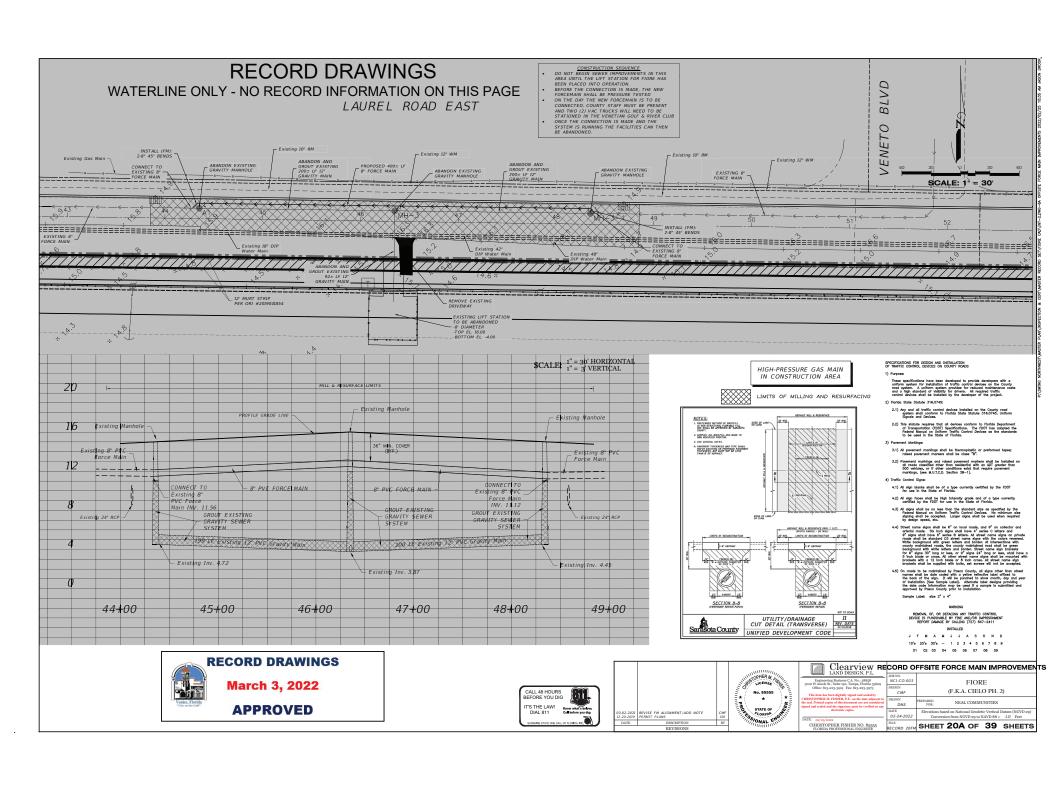


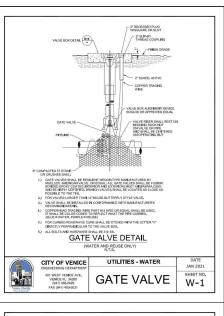

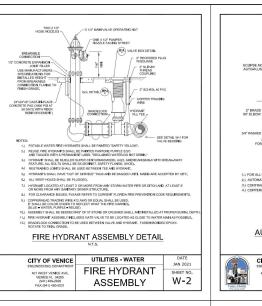

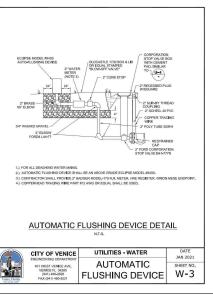

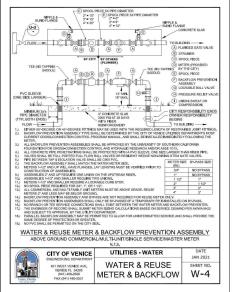

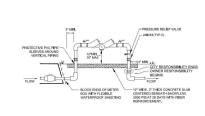

- ALL ABOVE GROUND PEPING SHALL BE RIGID COPPER.

 THE WATTER RETER AND BEDOCKLOW PEPINETES SHALL BE THE SAME SIZE.

 INSTALLED IMMEDIATELY AFFER THE UTILITY WATER METER, FER THE CROSS CONNECTION CONTROL MANJAL

 LINESS OTHERWISE AFFORD DAY IN WATER OF THE CITY OF VOMEO UTILITIES DIRECTOR AND WITH A SIGNED

 WANDER ARGEMENT BY THE CUSTOMER.

 ON BRANCH ON THE CONNECTIONS SHALL MUST BE LIVED IN THE WATER METER AND BACKFLOW PREVENTER.

 THE SHALL SHA


BACKFLOW PREVENTION ASSEMBLY

(RESIDENTIAL, NOT MASTER METERED)

CITY OF VENICE


UTILITIES - WATER BACKFLOW ASSEMBLY (NO MASTER METER)

JAN 2021 SHEET NO. W-5

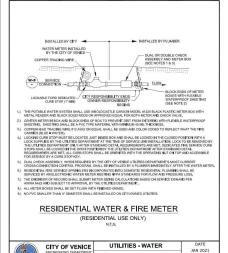

RESIDENTIAL WATER &

FIRE METER

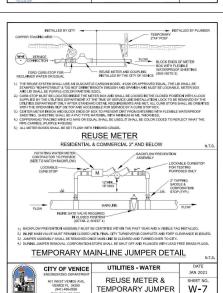

- 1		CITY
	Venice, Florida	401 WE VEN (9 FAX

TEMPORARY JUMPER

45 BEND RESIDENTIAL METER CONNECTION DETAIL METER CONNECTION WATER & REUSE SERVICE CONNECTION CITY OF VENICE JAN 2021 RESIDENTIAL METER & SHEET NO. SERVICE CONNECTION W-8

RECORD DRAWINGS



March 3, 2022

APPROVED

RECORD DRAWINGS

SHEET NO.


W-6







Clearview	RECORD POTABLE WATER SYSTEM DETAILS				
 Engineering Business CA. No.: 28858 3010 W Azeele St., Suite 150, Tampa, Florida 33609 Office: 813-223-3919 Fax: 813-223-3975 This item has been digitally signed and sealed by	JOB NO. NCI-CO-003 DESIGN WAL	FIORE (F.K.A. CIELO PH. 2)			
	WAL	PREPARED NEAL COMMUNITIES FOR:			
	DATE 02-24-2022	Elevations based on National Geodetic Vertical Datum (NGVD 29) Conversion from NGVD 29 to NAVD 88 = -1.11 Feet			
CHRISTOPHER FISHER NO. 85555 FLORIDA PROFESSIONAL ENGINEER	FILE WMD	SHEET 30 OF 39 SHEETS			

ew	RECORD POTABLE WATER SYSTEM DETAILS					
28858 lorida 33600	JOB NO. NCI-CO-003		FIORE			
23-3975 I scaled by	DESIGN WAL		(F.K.A. CIELO PH. 2)			
date adjacent to e not considered	DRAWN WAL	PREPARED FOR:	NEAL COMMUNITIES			

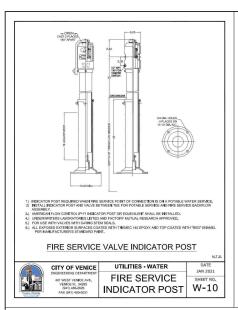

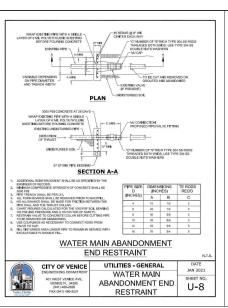

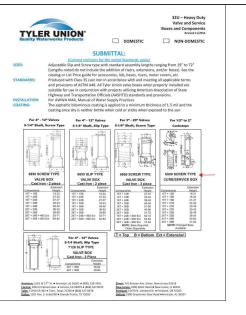



RECORD DRAWINGS

			.autillin.		RECORD	POTABLE WATE	R SYSTE	M DETAILS
		No. 85555	Engineering Business CA. No. 28858 South Waxeele St., Suite 150, Tampa, Florida 33609 Office 813-223-9910 Fax: 813-223-9975 This item has been divitally sized and waled by	JOB NO. NCI-CO-003 DESIGN WAL	1		2)	
24 05 2021	W004TC 05T4W5 TO 2021	cur	* /g	the seal. Printed copies of this document are not considered sized and sealed and the signature must be verified on any	WAL	PREPARED NEAL CO	OMMUNITIES	
2-05-2020	UPDATE DETAILS TO 2020	CMF INI	CORIDA CITAL		DATE 02-24-2022			
DATE	DESCRIPTION REVISIONS	BY	WALL THE	CHRISTOPHER FISHER NO. 85555 FLORIDA PROFESSIONAL ENGINEER	FILE WMD	SHEET 31 C	of 39	SHEETS
	2-05-2020 2-20-2019		2-05-2020 UPDATE DETAILS TO 2020 CMF 2-20-2019 PERMIT PLANS INI DATE DESCRIPTION BY	04-06-2021 UPDATE DETAILS TO 2021 CMF 2-20-3029 PERMIT PLANS TO 2020 CMF 101 DIXT DISSCRIPTION BY	LAND DESIGN, P.L. LOND DESIGN,	LAND DESIGN; P. L.	LAND DESIGN, P. L.	LAND DESIGN, P. L. DESIGN P. L. D