
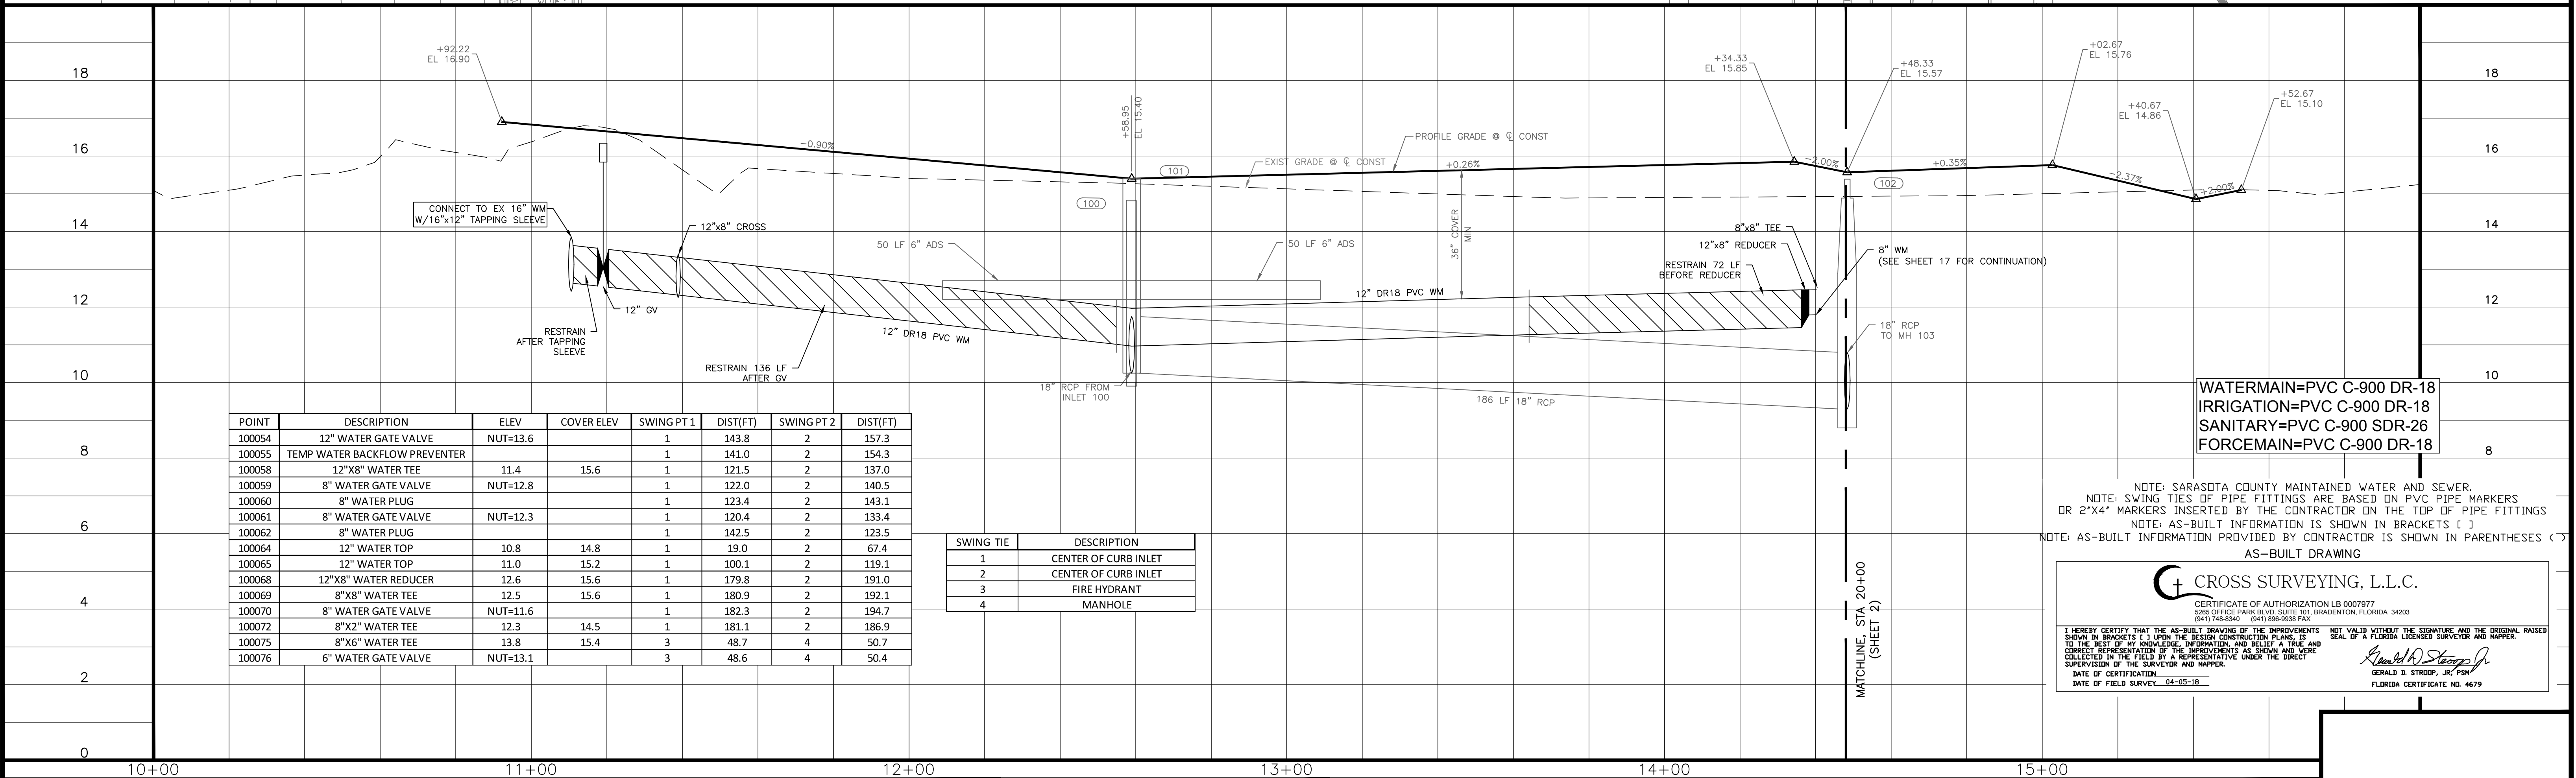


PARTIAL CLEARANCE AS-BUILTS

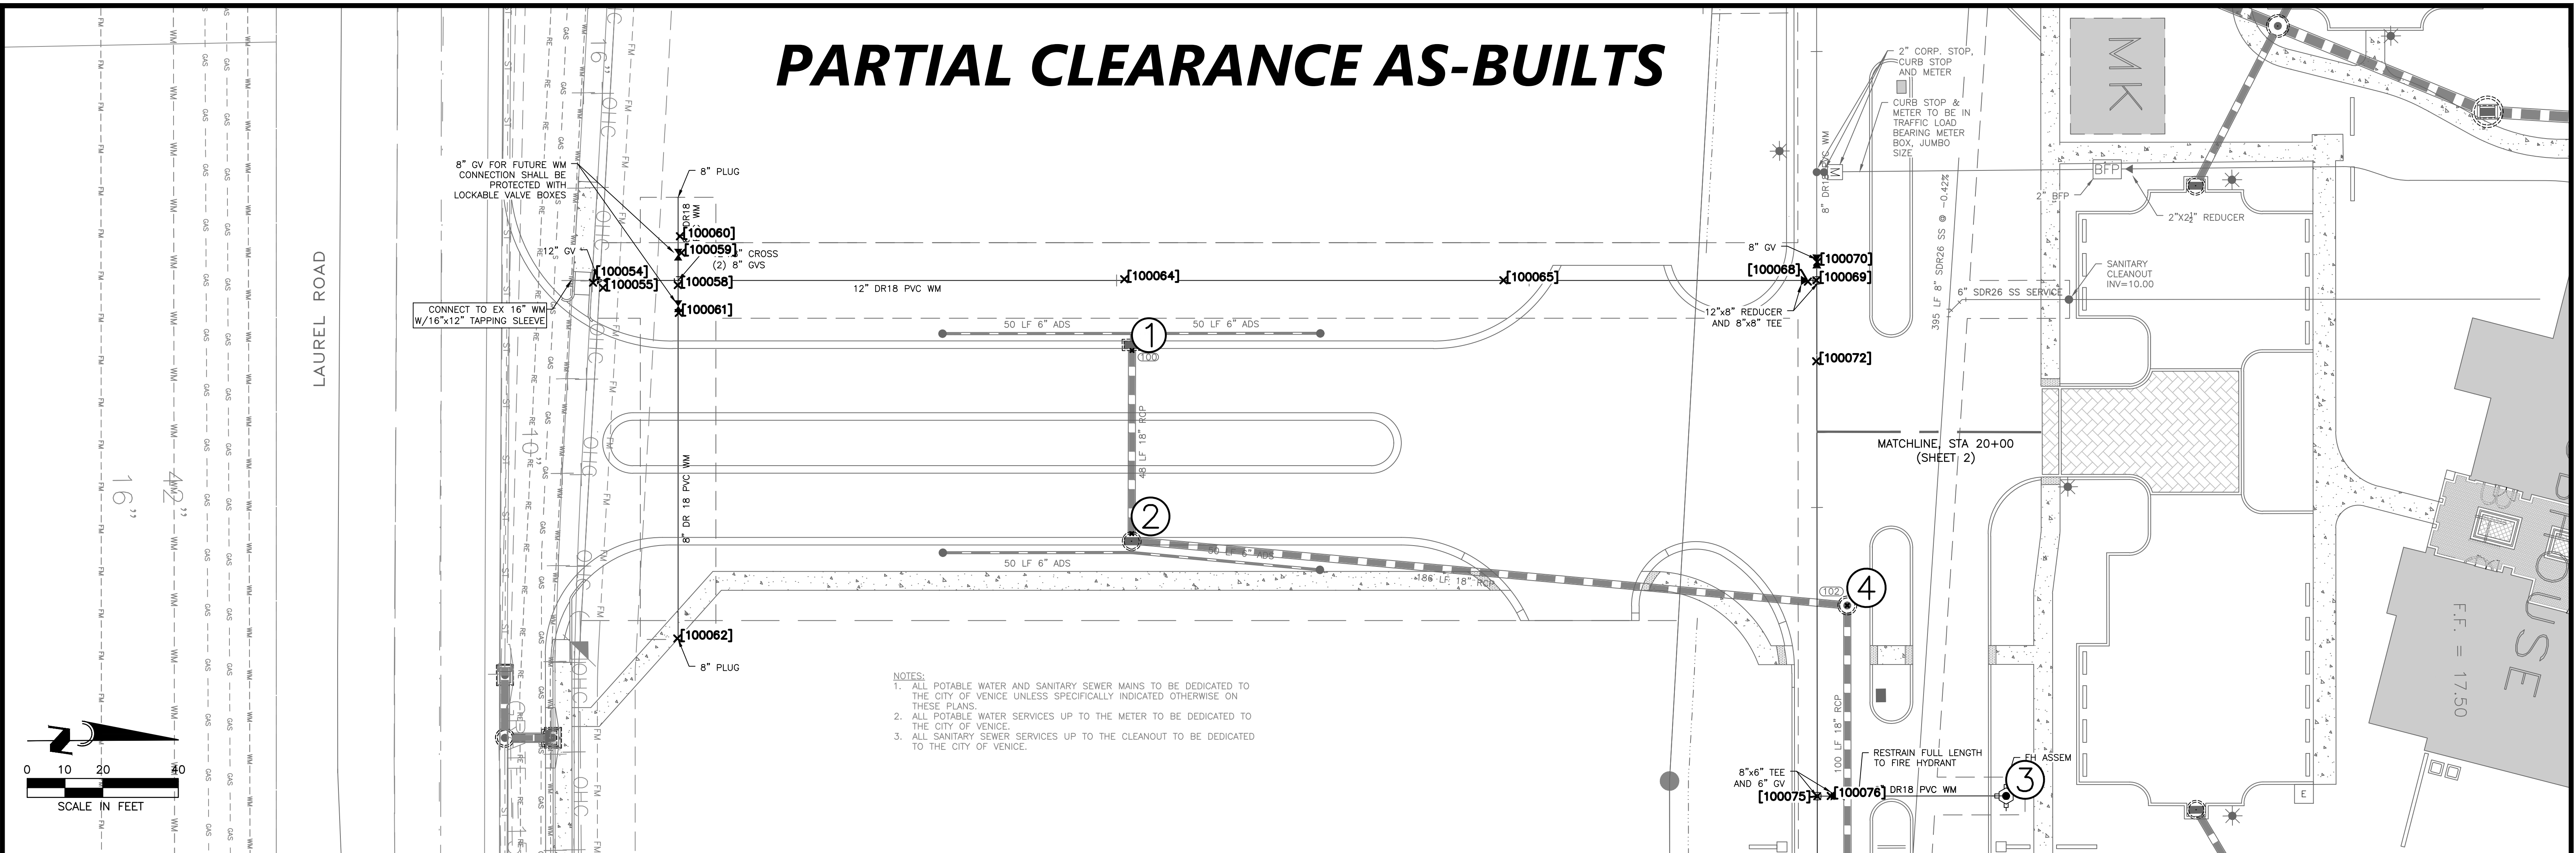

CALL BEFORE YOU DIG!
"SUNSHINE STATE ONE-CALL CENTER"
1-800-432-4770

THE CONTRACTOR SHALL NOTIFY "SUNSHINE STATE ONE-CALL CENTER" AND ALL OTHER UTILITIES FOR LOCATION OF EXISTING FACILITIES PRIOR TO BEGINNING CONSTRUCTION.

R E V I S I O N S		
BY	DATE	DESCRIPTION

ENGINEERING, INC.
8340 CONSUMER COURT
SARASOTA, FL 34240
EB #4334

PHONE: (941) 377-9178

PROJECT: TREVISO GRAND APARTM	
SCALE: 1"=20'H, 1"=2'V	APPROVED BY:
DATE: 09/22/17	D. SHAWN LEINS, P.E. FLORIDA CERTIFICATE NO. 41078
CLIENT: TRI OF TREVISO GRAND, LLC	
TITLE: PLAN AND PROFILE STA 10+00 TO 16+00	

ENTS	
DRAWN BY:	MK
DRWG. NO:	TOWN01-09A-PP
JOB NO:	TOWN0001
SHEET NO:	1


PARTIAL CLEARANCE AS-BUILTS

SEE SHEET 1 FOR MORE
AS-BUILT INFORMATION

POINT	DESCRIPTION	ELEV	COVER ELEV	SWING PT 1	DIST(FT)	SWING PT 2	DIST(FT)
100079	8" WATER GATE VALVE	NUT=13.2		3	54.0	4	70.3
100080	8" WATER BLOWOFF			3	55.4	4	74.9

SWING TIE	DESCRIPTION
3	FIRE HYDRANT
4	MANHOLE

- NOTES:
- ALL POTABLE WATER AND SANITARY SEWER MAINS TO BE DEDICATED TO THE CITY OF VENICE UNLESS SPECIFICALLY INDICATED OTHERWISE ON THESE PLANS.
 - ALL POTABLE WATER SERVICES UP TO THE METER TO BE DEDICATED TO THE CITY OF VENICE.
 - ALL SANITARY SEWER SERVICES UP TO THE CLEANOUT TO BE DEDICATED TO THE CITY OF VENICE.

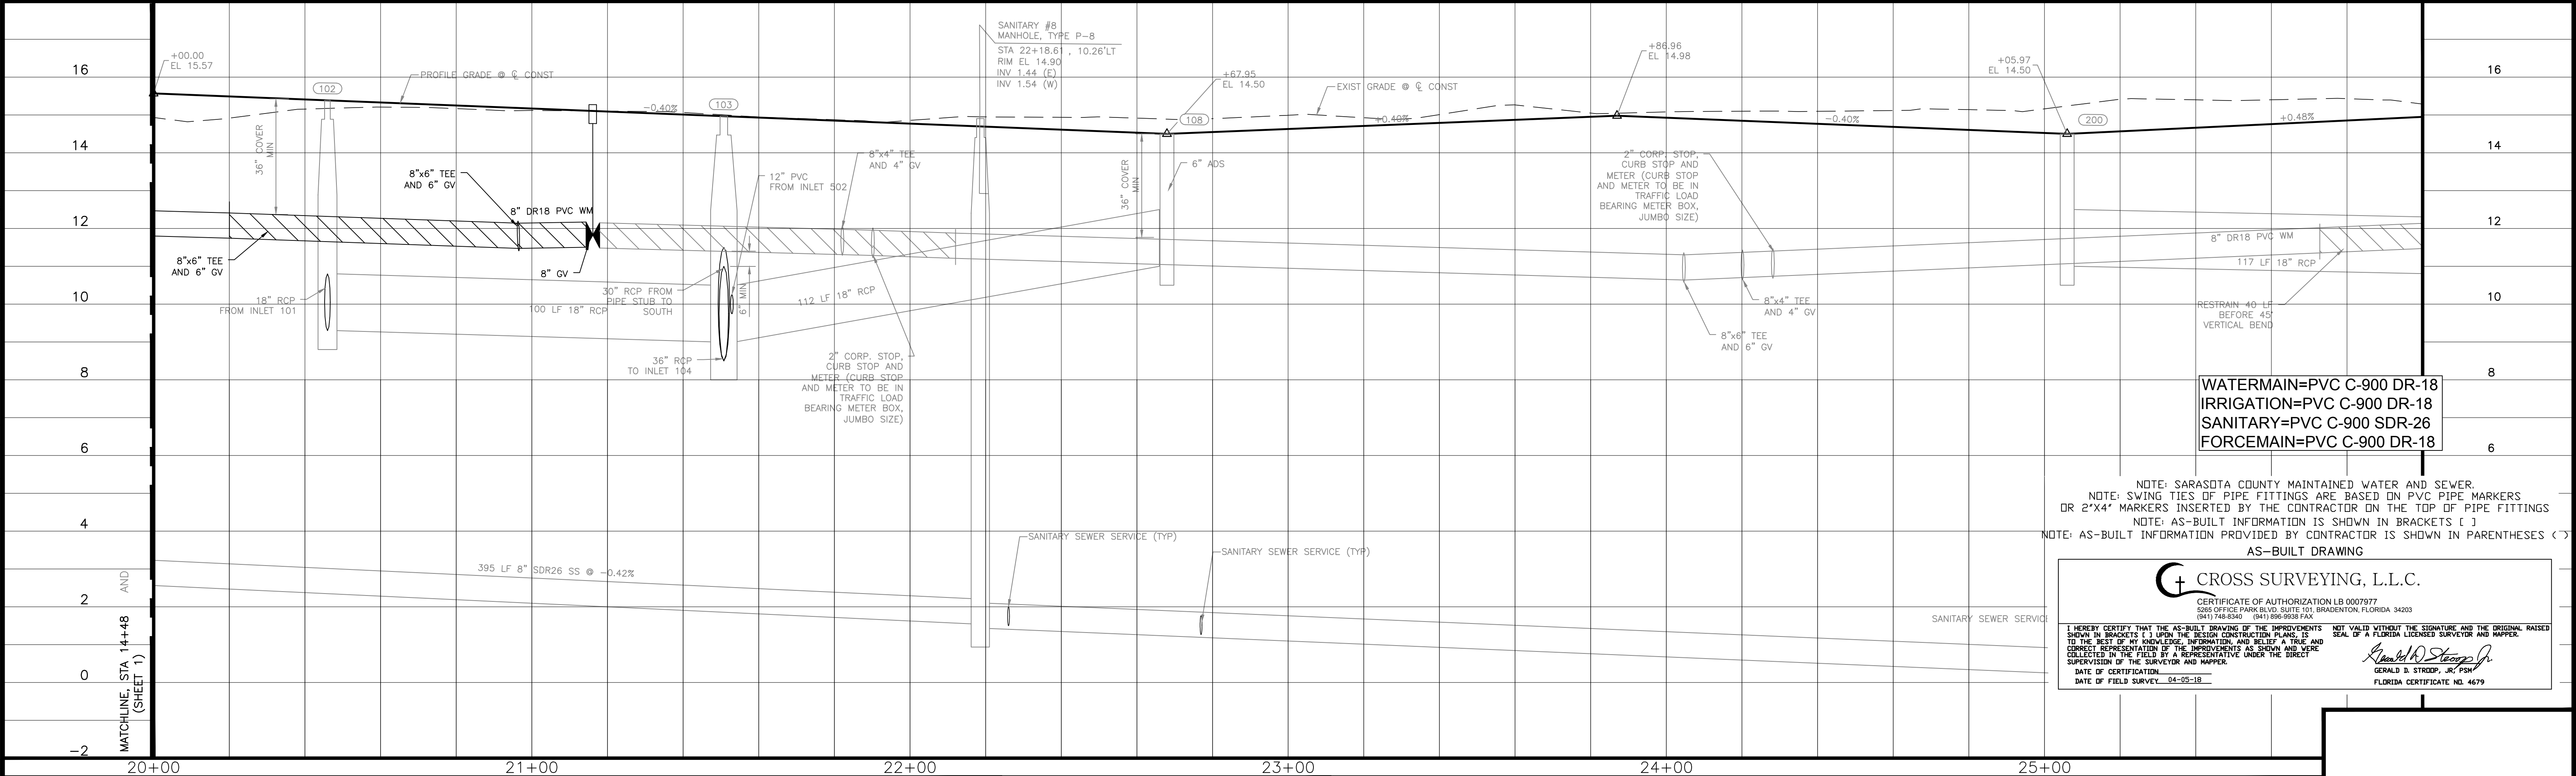

CALL BEFORE YOU DIG!
"SUNSHINE STATE ONE-CALL CENTER"
1-800-432-4770
THE CONTRACTOR SHALL NOTIFY "SUNSHINE STATE ONE-CALL CENTER" AND ALL OTHER UTILITIES FOR LOCATION OF EXISTING FACILITIES PRIOR TO BEGINNING CONSTRUCTION.

REVISIONS		
BY	DATE	DESCRIPTION

ENGINEERING, INC.
540 CONSUMER COURT
SARASOTA, FL 34240
EB #4334
PHONE: (941) 371-9178

TREVISIO GRAND APARTMENTS	
SCALE: 1"=20'H, 1"=2'V	APPROVED BY: D. SHAWN LEINS, P.E. FLORIDA CERTIFICATE NO. 41078
DATE: 09/22/17	CLIENT: TRI OF TREVISIO GRAND, LLC
TITLE: PLAN AND PROFILE STA 20+00 TO 26+00	DATE OF FIELD SURVEY: 04-05-18

CROSS SURVEYING, L.L.C.	
CERTIFICATE OF AUTHORIZATION LB 0007877 5205 OFFICE PARK BLVD., SUITE 101, BRADENTON, FLORIDA 34203 (941) 748-8340 (941) 896-9938 FAX	NOT VALID WITHOUT THE SIGNATURE AND THE ORIGINAL RAISED SEAL OF A FLORIDA LICENSED SURVEYOR AND MAPPER.
I HEREBY CERTIFY THAT THE AS-BUILT DRAWING OF THE IMPROVEMENTS NOTED WITHIN THE SIGNATURE AND THE ORIGINAL RAISED SEAL OF A FLORIDA LICENSED SURVEYOR AND MAPPER, IS TO THE BEST OF MY KNOWLEDGE, INFORMATION, AND BELIEF A TRUE AND CORRECT REPRESENTATION OF THE IMPROVEMENTS AS SHOWN AND WERE COLLECTED IN THE FIELD BY A REPRESENTATIVE UNDER THE DIRECT SUPERVISION OF THE SURVEYOR AND MAPPER.	DATE OF CERTIFICATION: 09-22-17 DATE OF FIELD SURVEY: 04-05-18
GERALD D. STROUD, JR., PLS	FLORIDA CERTIFICATE NO. 4679