



| PLANT SCHEDULE | | | | | | | | |
|-----------------------------------|-----------|--------------------------------------|------------------------------|-------------------------------------|-----------|-----------|----------|----------------------|
| SYMBOL | CODE | QTY | BOTANICAL NAME | COMMON NAME | SIZE | CONTAINER | DROUGHT | FL NATIVE / FRIENDLY |
| TREES | | | | | | | | |
| BS | 49 | BURSERA SIMARUBA | GUMBO LIMBO | 4" CAL. - 14' OA. HT. MIN. | CONT/B&B | TOLERANT | | NATIVE |
| EF | 28 | EUGENIA FOETIDA | SPANISH STOPPER | 2.5" CAL. 8' HT X 6' SPRD | CONT/B&B | TOLERANT | | NATIVE |
| MG | 10 | MAGNOLIA GRANDIFLORA | SOUTHERN MAGNOLIA | 3" CAL. 12' OA. HT. X 6' SPRD. | CONT/B&B | TOLERANT | | NATIVE |
| PE | 17 | PINUS ELLIOTTII VAR. DENSA | FLORIDA SLASH PINE | 3" CAL. 12' OA. MIN. HT. X 6' SPRD. | CONT/B&B | TOLERANT | | NATIVE |
| QV | 52 | QUERCUS VIRGINIANA | SOUTHERN LIVE OAK | 3" CAL. 12' OA. HT. X 6' SPRD. | CONT/B&B | TOLERANT | | NATIVE |
| TD | 25 | TAXODIUM DISTICHUM | BALD CYPRESS | 3" CAL. 12' OA. HT. X 6' SPRD. | CONT/B&B | TOLERANT | | NATIVE |
| SHRUB AREAS | | | | | | | | |
| CHR | 2,034 | CHRYSOBALANUS ICACO 'RED TIP' | RED TIP COCO PLUM | 24" HT X 24" SPRD | CONTAINER | TOLERANT | 24" O.C. | NATIVE |
| CME | 230 | CARISSA MACROCARPA 'EMERALD BLANKET' | EMERALD BLANKET NATAL PLUM | 24" HT. X 24" SPRD. | CONTAINER | TOLERANT | 24" O.C. | FRIENDLY |
| IVN | 357 | ILEX VOMITORIA 'NANA' | DWARF YAUPOON HOLLY | 36" HT. X 36" SPRD. | CONTAINER | TOLERANT | 36" O.C. | NATIVE |
| RHI | 371 | RHAPHOLEPIS INDICA | INDIAN HAWTHORN | 36" HT. X 36" SPRD. | CONTAINER | TOLERANT | 36" O.C. | FRIENDLY |
| TRA | 3,312 | TRACHELOSPERMUM ASIATICUM | ASIATIC JASMINE | 6" HT. X 12" SPRD W 3-4 RUNNERS | CONTAINER | TOLERANT | 18" O.C. | FRIENDLY |
| BUILDING FOUNDATION SHRUBS | | | | | | | | |
| LMB-F | 12 | LIROPE MUSCARI 'BIG BLUE' | BIG BLUE LILYTURF | 12" HT. X 12" SPRD. | CONTAINER | TOLERANT | 24" O.C. | FRIENDLY |
| RHI-F | 16 | RHAPHOLEPIS INDICA | INDIAN HAWTHORN | 24" HT. X 24" SPRD. | CONTAINER | TOLERANT | 36" O.C. | FRIENDLY |
| SOD | | | | | | | | |
| SOD | 47,480 SF | STENOTAPHRUM SECUNDATUM 'PALMETTO' | PALMETTO ST. AUGUSTINE GRASS | FULL, TIGHT COVERAGE | PALLET | | | |



| PROP SITE LEGEND | |
|------------------------|-------------------|
| PROPERTY LINE | — |
| EASEMENT LINE | — — — |
| SETBACK LINE | — — — — |
| INTERIOR PROPERTY LINE | — — — — — |
| LEASE LINE | — — — — — — |
| LIMIT OF WORK | — — — — — — — |
| LIMIT OF DISTURBANCE | — — — — — — — — |
| CURB | — — — — — — — — — |
| UTILITY POLE | ● |
| TYPICAL SIGN | ▼ |
| BOLLARD | ○ |
| UTILITY POLE W/ LIGHT | ● — |
| TYPICAL LIGHT | ● ● |
| PARKING COUNT | (X) |

| REV | DATE | COMMENT | DRAWN BY | CHECKED BY |
|-----|-----------|----------------|----------|------------|
| 1 | 9/11/25 | CITY OF VENICE | EP KA | |
| 2 | 11/6/2025 | CITY OF VENICE | SH KA | |



ISSUED FOR MUNICIPAL & AGENCY REVIEW & APPROVAL

THIS DRAWING IS INTENDED FOR MUNICIPAL AND/OR AGENCY REVIEW AND APPROVAL. IT IS NOT INTENDED AS A CONSTRUCTION DOCUMENT UNLESS INDICATED OTHERWISE.

PROJECT No.: FLA250080.00-0A
DRAWN BY: TM/EP
CHECKED BY: BV/KA
DATE: 9/1/25
CAD ID.: P-CIVIL-LAND

SITE CONSTRUCTION PLANS



LAUREL ROAD & TWIN LAUREL BOULEVARD
NOKOMIS, FL 34275
CITY OF VENICE
S 29; T 38 S; R 19 E

BOHLER //

600 N. WESTSHORE BLVD. SUITE 950
TAMPA, FLORIDA 33609
Phone: (813) 812-4100
Fax: (813) 812-4101

FLORIDA BUSINESS CERT. OF AUTH. No. 30780

THIS ITEM HAS BEEN DIGITALLY SIGNED AND SEALED BY GRETTE MCGEE, W/ SIGNMAN, X. ON THE DATE ADJACENT TO THE SEAL SIGNATURE. THE SEAL SIGNATURE MUST BE VERIFIED ON ANY ELECTRONIC COPIES.

SHEET TITLE:

LANDSCAPE PLAN


SHEET NUMBER:
L-702

REVISION 2 - 11/06/25

MATCHLINE - SHEET L-703

TM
© 2025 BOHLER CONSULTING ENGINEERING, LLC. ALL RIGHTS RESERVED. THIS DRAWING CONTAINS DRAWING NUMBER FLA250080.00-0A, DRAWN BY TM/EP, CHECKED BY BV/KA, AND APPROVED BY SH/KA. THIS DRAWING IS FOR THE USE OF THE CITY OF VENICE, FLORIDA, AND IS NOT FOR PUBLIC RELEASE.

BOHLER
SITE CIVIL AND CONSULTING ENGINEERING
LAND SURVEYING
LANDSCAPE ARCHITECTURE
SUSTAINABLE DESIGN
PROGRAM MANAGEMENT
PERMITTING SERVICES

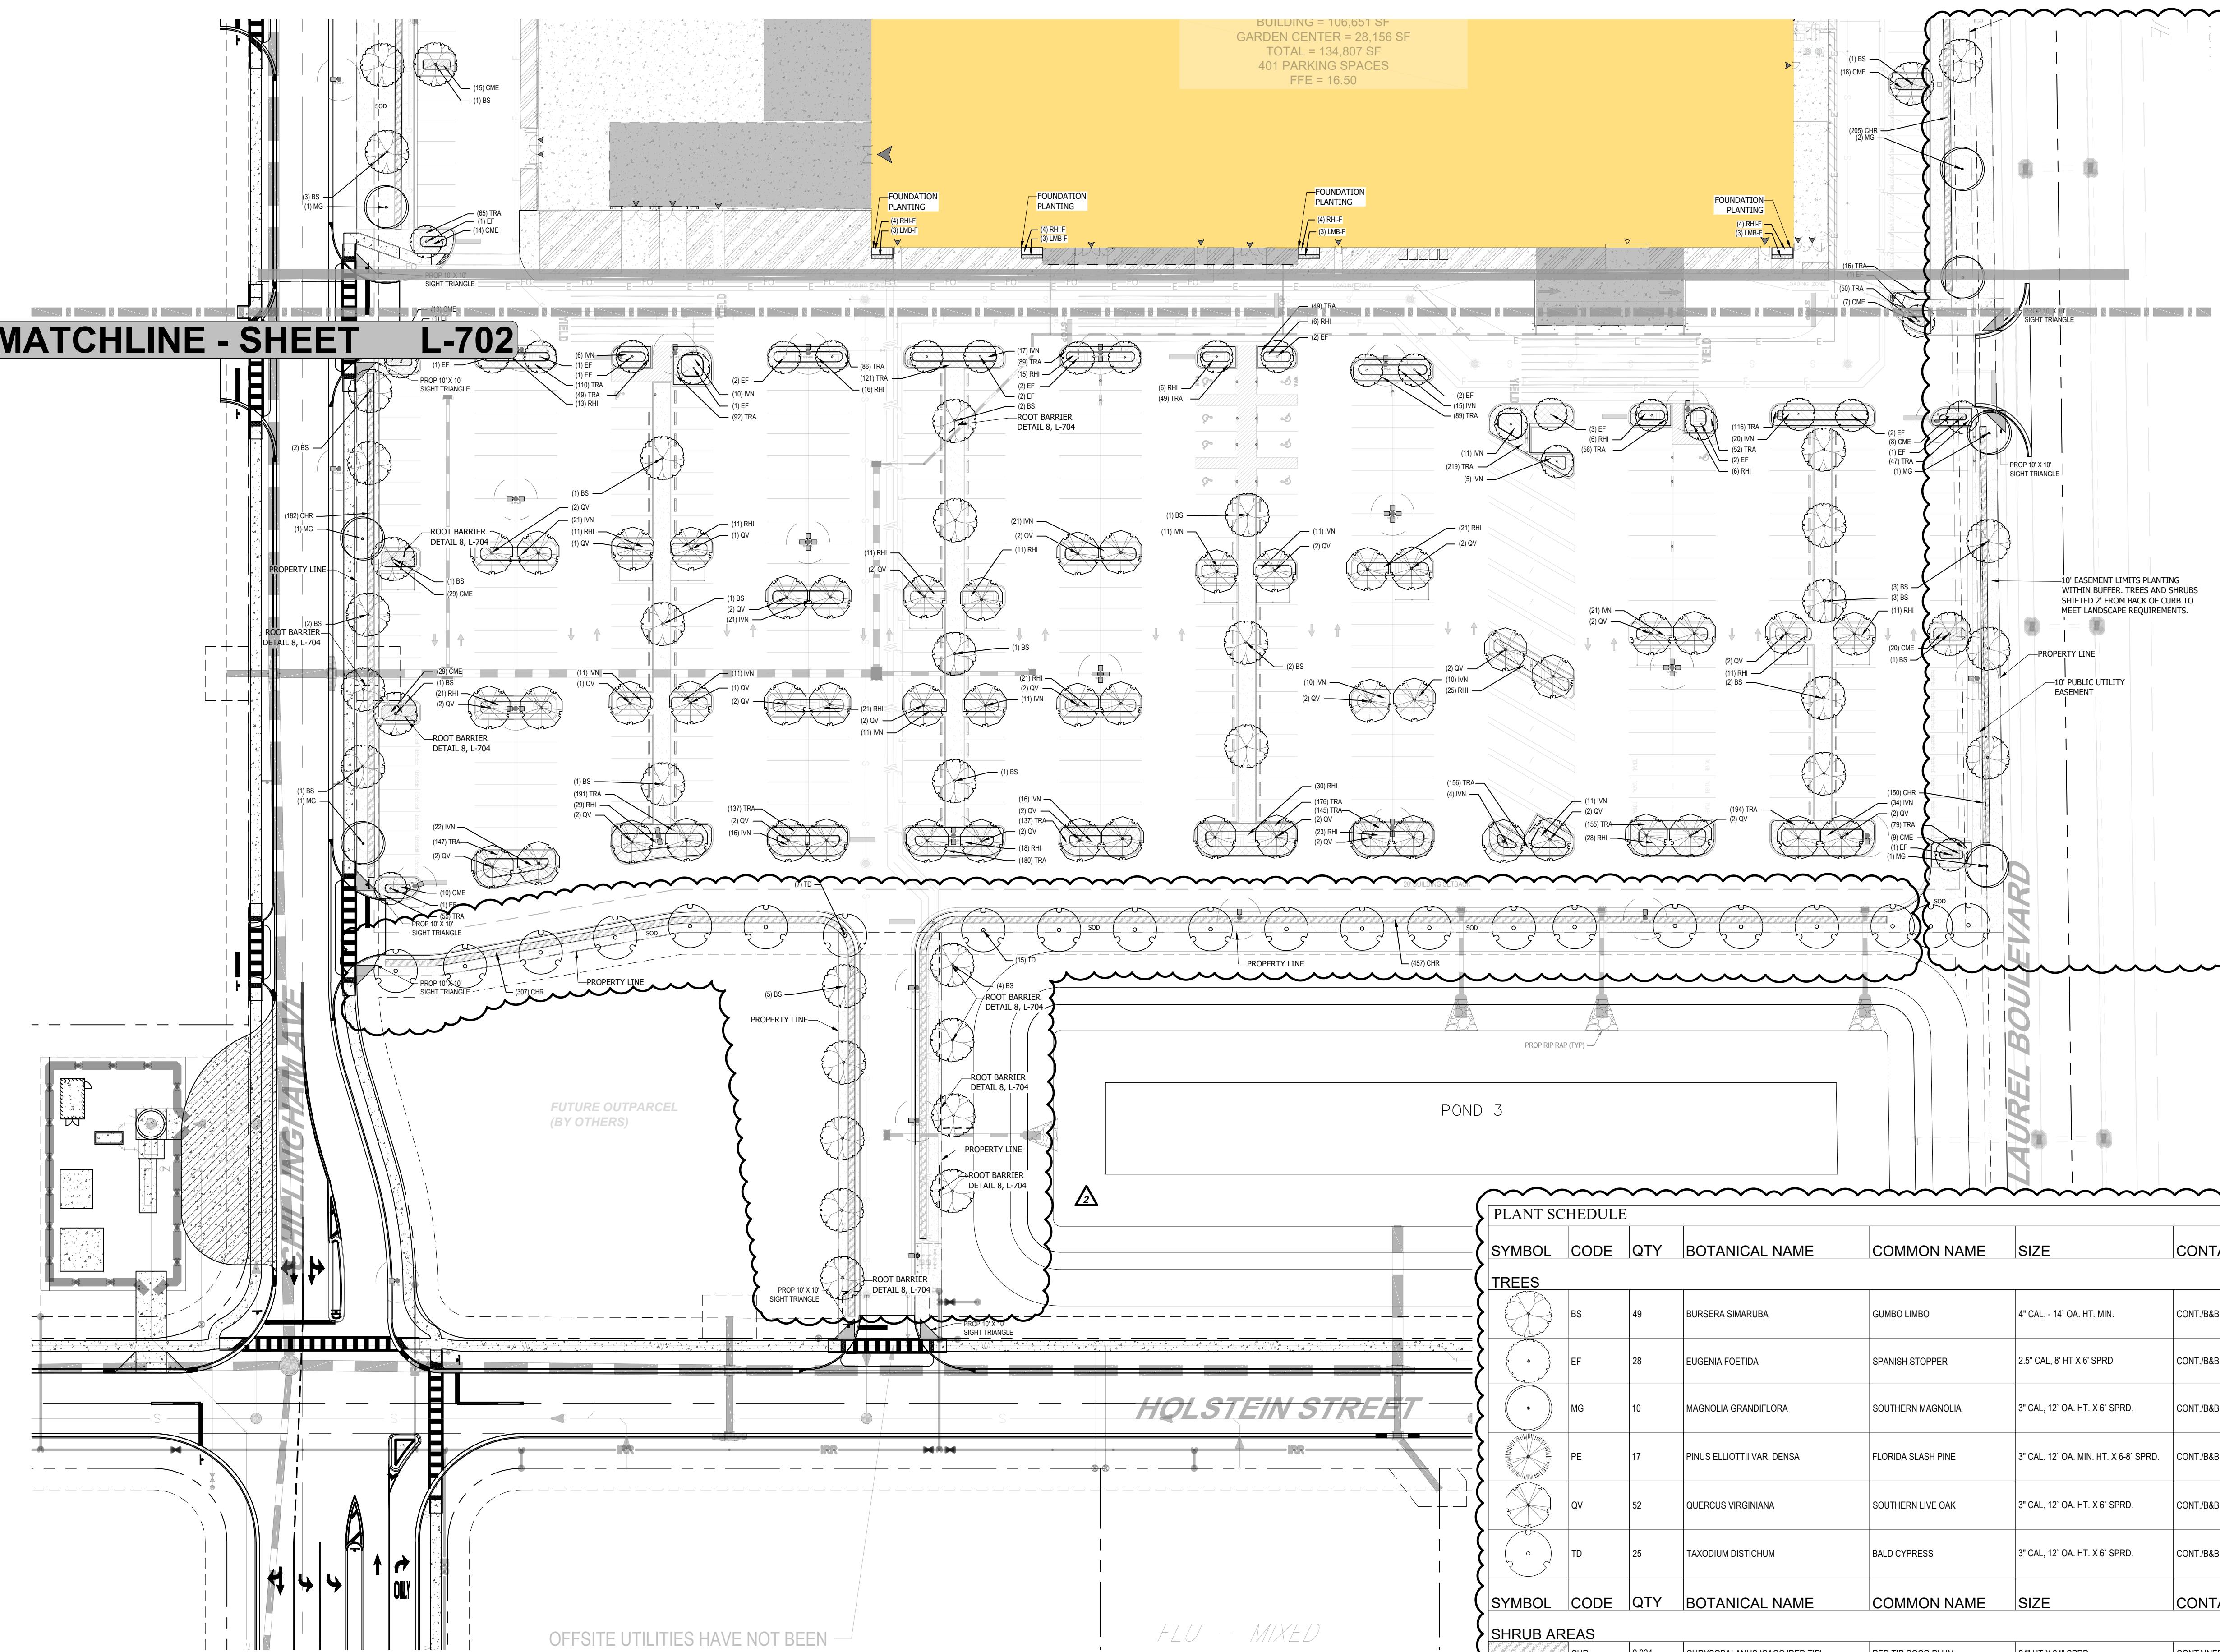

| PROP SITE LEGEND | |
|------------------------|-------------------|
| PROPERTY LINE | — |
| EASEMENT LINE | — — — |
| SETBACK LINE | — — — — |
| INTERIOR PROPERTY LINE | — — — — — |
| LEASE LINE | — — — — — — |
| LIMIT OF WORK | — — — — — — — |
| LIMIT OF DISTURBANCE | — — — — — — — — |
| CURB | — — — — — — — — — |
| UTILITY POLE | ● |
| TYPICAL SIGN | ▼ |
| BOLLARD | ○ |
| UTILITY POLE W/ LIGHT | ● — |
| TYPICAL LIGHT | ● ● |
| PARKING COUNT | (X) |

| REVISIONS | | |
|-----------|-----------|----------------------------|
| REV | DATE | COMMENT |
| 1 | 9/11/25 | CITY OF VENICE EP KA |
| 2 | 11/6/2025 | CITY OF VENICE SH KA |



ISSUED FOR MUNICIPAL & AGENCY REVIEW & APPROVAL

THIS DRAWING IS INTENDED FOR MUNICIPAL AND/OR AGENCY REVIEW AND APPROVAL. IT IS NOT INTENDED AS A CONSTRUCTION DOCUMENT UNLESS INDICATED OTHERWISE.

PROJECT No.: FLA250080.00-0A
DRAWN BY: TM/EP
CHECKED BY: BV/KA
DATE: 9/1/25
CAD ID.: P-CIVL-LAND

PROJECT: SITE CONSTRUCTION PLANS



LAUREL ROAD & TWIN
LAUREL BOULEVARD
NOKOMIS, FL 34275
CITY OF VENICE
S 29; T 38 S; R 19 E

BOHLER

600 N. WESTSHORE BLVD. SUITE 950
TAMPA, FLORIDA 33609
Phone: (813) 812-4100
Fax: (813) 812-4101

FLORIDA BUSINESS CERT. OF AUTH. No. 30780

THIS ITEM HAS BEEN DIGITALLY SIGNED AND
SEALED BY GRETTE MICOLE WILHELM, AIA, ON THE
DATE ADJACENT TO THE SIGNATURE. THE SIGNATURE MUST
BE VERIFIED ON ANY ELECTRONIC COPIES.

SHEET TITLE:

LANDSCAPE PLAN

SHEET NUMBER:

L-703

REVISION 2 - 11/06/25

| PLANT SCHEDULE | | | | | | | |
|-----------------------------------|-----------|-------------------------------------|------------------------------|---------------------------------------|-----------|-----------|----------|
| SYMBOL | CODE | QTY | BOTANICAL NAME | COMMON NAME | SIZE | CONTAINER | DROUGHT |
| TREES | | | | | | | |
| BS | 49 | BURSERA SIMARUBA | GUMBO LIMBO | 4" CAL - 14" OA. HT. MIN. | CONT/B&B | TOLERANT | NATIVE |
| EF | 28 | EUGENIA FOETIDA | SPANISH STOPPER | 2.5" CAL, 5' HT X 5' SPRD. | CONT/B&B | TOLERANT | NATIVE |
| MG | 10 | MAGNOLIA GRANDIFLORA | SOUTHERN MAGNOLIA | 3" CAL, 12" OA. HT. X 6' SPRD. | CONT/B&B | TOLERANT | NATIVE |
| PE | 17 | PINUS ELLIOTTII VAR. DENSA | FLORIDA SLASH PINE | 3" CAL, 12" OA. MIN. HT. X 6-8' SPRD. | CONT/B&B | TOLERANT | NATIVE |
| QV | 52 | QUERCUS VIRGINIANA | SOUTHERN LIVE OAK | 3" CAL, 12" OA. HT. X 6' SPRD. | CONT/B&B | TOLERANT | NATIVE |
| TD | 25 | TAXODIUM DISTICHUM | Bald Cypress | 3" CAL, 12" OA. HT. X 6' SPRD. | CONT/B&B | TOLERANT | NATIVE |
| SHRUB AREAS | | | | | | | |
| CHR | 2,034 | CHRYSOBALANUS ICACO 'RED TIP' | RED TIP COCO PLUM | 24" HT X 24" SPRD. | CONTAINER | TOLERANT | 24" O.C. |
| CME | 230 | CARISA MACROCARPA 'EMERALD BLANKET' | EMERALD BLANKET NATAL PLUM | 24" HT X 24" SPRD. | CONTAINER | TOLERANT | 24" O.C. |
| IVN | 357 | ILEX VOMITORIA 'NANA' | DWARF YAUPOON HOLLY | 36" HT X 36" SPRD. | CONTAINER | TOLERANT | 36" O.C. |
| RHI | 371 | RHAPHIOLEPIS INDICA | INDIAN HAWTHORN | 36" HT X 36" SPRD. | CONTAINER | TOLERANT | 36" O.C. |
| TRA | 3,312 | TRACHELOSPERMUM ASIATICUM | ASIAN JASMINE | 6" HT X 12" SPRD W/ 3/4 RUNNERS | CONTAINER | TOLERANT | 18" O.C. |
| BUILDING FOUNDATION SHRUBS | | | | | | | |
| LMB-F | 12 | LIRIOPE MUSCARI 'BIG BLUE' | BIG BLUE LILY TURF | 12" HT X 12" SPRD. | CONTAINER | TOLERANT | 24" O.C. |
| RHI-F | 16 | RHAPHIOLEPIS INDICA | INDIAN HAWTHORN | 24" HT X 24" SPRD. | CONTAINER | TOLERANT | 36" O.C. |
| SOD | | | | | | | |
| SOD | 47,480 SF | STENOTAPHRUM SECUNDATUM 'PALMETTO' | PALMETTO ST. AUGUSTINE GRASS | FULL, TIGHT COVERAGE | PALLET | | |

Landscape Notes:

1. A PRE-INSTALLATION MEETING WITH THE CITY ARBORIST IS REQUIRED PRIOR TO LANDSCAPING ACTIVITIES INCLUDING REMOVAL OF TREES AND/OR INSTALLATION OF PLANT MATERIAL.
2. ALL EXISTING TREES PROPOSED TO REMAIN ARE TO BE SEPARATED FROM THE LIMITS OF DISTURBANCE OF THE CONSTRUCTION AREA BY TREE PROTECTION FENCING AND SIGNAGE. THE TREE PROTECTION FENCING SHALL BE LOCATED AT THE EDGE OF THE TREE PROTECTION ZONE AS DEPICTED ON THE PLAN OR AT THE EDGE OF THE DRIPLINE(S) IF A TREE PROTECTION ZONE IS NOT DESIGNATED. NO MATERIAL STORAGE OR CONSTRUCTION ACCESS IS PERMITTED WITHIN THE TREE PROTECTION ZONE.
3. ALL EXISTING TREES SHALL BE PRUNED TO ANSI A-300 STANDARDS TO CORRECT POTENTIAL HAZARDS.
4. A TREE REMOVAL PERMIT IS REQUIRED PRIOR TO REMOVAL OR RELOCATION OF ANY TREE OR PALM CONTACT THE COUNTY TO OBTAIN PERMIT INFORMATION.
5. CONTRACTOR SHALL NOTIFY SUNSHINE ONE CALL OF FLORIDA, INC. AT 1-800-432-4770 A MINIMUM OF 2 FULL BUSINESS DAYS PRIOR TO DIGGING. CONTRACTOR IS RESPONSIBLE FOR AVOIDING DAMAGE TO UTILITIES FROM PLANT INSTALLATION.
6. TREE RELOCATIONS:
A. EXISTING TREES TO BE RELOCATED SHALL BE ROOT PRUNED A MINIMUM OF 120 DAYS PRIOR TO RELOCATION.
B. MINIMUM ROOT BALL SIZES SHALL BE IN ACCORDANCE WITH ANSI STANDARDS AS FOLLOWS:
CALIPER MINIMUM ROOT BALL DIAMETER
1 16
2 24
3 32
4 42
5 54
6 60
7 70
8 80
>8 12 INCHES PER INCH OF TRUNK DIAMETER
TRANPLANTED TREES WITH UNDERSIZED ROOT BALLS MAY BE REJECTED BY THE CITY ARBORIST AND REPLACEMENT TREES MAY BE REQUIRED.
- C. A TEMPORARY IRRIGATION SYSTEM SHALL BE PROVIDED DURING AND FOR THE FIRST 40 DAYS AFTER ROOT PRUNING.
7. ALL PLANTING MUST FOLLOW PLANTING SPECIFICATIONS AND DETAILS SHOWN ON THE PLAN.
8. SUBSTITUTIONS OF PLANT SPECIES OR SPECIFICATIONS MUST BE APPROVED IN WRITING BY THE CITY AND COUNTY PRIOR TO USE.
9. ALL INVASIVE EXOTIC VEGETATION SHALL BE DISPOSED OF OR TREATED AS PER THE LOCAL OR REGIONAL GOVERNING AUTHORITIES REQUIREMENTS OR RECOMMENDATIONS.
10. ALL PLANT MATERIAL PLANTED PER THIS LANDSCAPE PLAN SHALL BE FLORIDA GRADE #1 OR BETTER, AS SPECIFIED IN THE CURRENT EDITION OF THE FLORIDA DEPARTMENT OF AGRICULTURE'S GRADES AND STANDARDS FOR NURSERY PLANTS. DAMAGED PLANT MATERIAL SHALL BE REJECTED AND REPLACED PRIOR TO INSTALLATION.
11. ALL SIZES SHOWN FOR PLANT MATERIAL ARE TO BE CONSIDERED MINIMUMS.
12. WHERE QUANTITIES AND/OR SPECIES DIFFER BETWEEN THE PLANTING PLANS AND PLANT LISTS, THE PLANS SHALL TAKE PRECEDENCE.
13. ALL NEW PLANT MATERIAL SHALL BE WARRANTED BY THE CONTRACTOR FOR A MINIMUM PERIOD OF ONE YEAR. THE WARRANTY PERIOD SHALL BEGIN AFTER ACCEPTANCE OF THE PLANTS BY THE CITY AND COUNTY.
14. PLANT BEDS TO BE TREATED WITH PRE-EMERGENT HERBICIDE PRIOR TO PLANTING.
15. ALL TREE AND PALM STAKING AND SUPPORT SHALL BE REMOVED ONE YEAR AFTER INSTALLATION.
16. ALL LANDSCAPE MATERIAL SHALL BE THOROUGHLY WATERED AT THE TIME OF PLANTING, NO DRY PLANTING PERMITTED.
17. CONTRACTOR SHALL BE RESPONSIBLE FOR PROVIDING TEMPORARY WATER PROVISIONS UNTIL SUCH TIME AS THE IRRIGATION SYSTEM IS OPERATIONAL.
18. ALL WIRE GUYS AND/OR FABRIC STRAPS SHALL BE FLAGGED WITH FLORESCENT COLORED TAPE.
19. MULCHING:
ALL LANDSCAPE AREAS NOT COVERED BY SOD SHALL BE COVERED BY A MINIMUM 3-INCH LAYER OF MULCH.
D. A MULCH RING WITH A MINIMUM RADIUS OF 24 INCHES (48 INCH DIAMETER), IS REQUIRED AROUND ALL NEWLY INSTALLED TREES AND PALMS.
E. CYPRESS OR COLORED MULCH SHALL NOT BE USED.
F. NO MULCH SHALL BE PLACED TOUCHING OR WITHIN SIX INCHES OF THE TRUNK OF A TREE OR PALM.
20. ALL NEWLY LANDSCAPED AREAS SHALL BE EXCAVATED DOWN TO A DEPTH OF 24 INCHES BELOW FINAL GRADE AND BACK FILLED WITH CLEAN DEBRIS-FREE SOIL. EXISTING SOIL MAY BE REUSED FOR BACKFILLING IF DEBRIS IS REMOVED AND ORGANIC CONTENT IS SUFFICIENT OR SOIL IS AUGMENTED WITH TOPSOIL. CONSTRUCTION ACCESS SHALL BE RESTRICTED FROM THE LANDSCAPE AREA AFTER EXCAVATION AND BACKFILL IS COMPLETE.
21. THE LOCATION OF PLANT MATERIAL AS SHOWN ON THESE PLANS IS FINAL. THE FINAL LOCATIONS CAN BE ADJUSTED ON SITE TO ACCOMMODATE UNFORESEEN FIELD CONDITIONS. THESE CHANGES MUST COMPLY WITH ALL SAFETY SETBACK CRITERIA AND BE DIRECTED OR APPROVED BY THE CONSULTANT AND THE COUNTY CODES.
22. REPORT ANY AND ALL DISCREPANCIES BETWEEN THE CONSTRUCTION DRAWINGS AND FIELD CONDITIONS TO THE CONSULTANT AND COUNTY IMMEDIATELY.
23. THE CONTRACTOR IS RESPONSIBLE FOR VERIFYING ALL PLANT COUNTS AND REPORT ANY DISCREPANCIES TO THE CONSULTANT AND COUNTY PRIOR TO CONSTRUCTION.
24. BEFORE CONSTRUCTION BEGINS THE CONTRACTOR IS RESPONSIBLE FOR LOCATING ALL UNDERGROUND UTILITIES AND SHALL AVOID DAMAGE TO ALL UTILITIES DURING CONSTRUCTION. IF SUCH DAMAGE OCCURS THE CONTRACTOR IS RESPONSIBLE FOR ANY NECESSARY REPAIRS AND THEY SHOULD BE MADE IMMEDIATELY AT THE CONTRACTOR'S EXPENSE.
25. ALL WORK MUST COMPLY WITH THE FLORIDA STATE STATUTE 553.81- "PROTECTION OF UNDERGROUND PIPELINES."
26. THE CONTRACTOR MUST COMPLY WITH ALL STATE AND LOCAL WATER QUALITY STANDARDS.

27. THE LOCATION OF ALL THE UTILITIES SHOWN ON THE PLAN IS APPROXIMATE. THE EXACT LOCATION SHALL BE DETERMINED BY THE CONTRACTOR ON SITE. ALL PLANTING MAY BE ADJUSTED TO AVOID CONFLICTS WITH UTILITIES AND/OR EXISTING ABOVE GROUND ELEMENTS. ANY ADJUSTMENTS GREATER THAN 10 FEET SHALL BE DONE ONLY WITH THE APPROVAL OF THE CONSULTANT AND THE COUNTY.
28. CAUTION SHOULD BE EXERCISED WHEN WORKING NEAR EXISTING PLANTING AND ANY FURNISHING THAT IS TO REMAIN ON SITE TO PREVENT ANY DAMAGE. ANY SIGNS, STRUCTURES, OR PLANTING SHALL BE REPLACED AT THE CONTRACTOR'S EXPENSE IF DAMAGED BEYOND USE. DAMAGED BEYOND USE WILL BE DETERMINED BY THE CONSULTANT AND THE COUNTY.
29. ANY PUBLIC LAND CORNER WITHIN THE LIMITS OF CONSTRUCTION IS TO BE PROTECTED. IF A CORNER MONUMENT IS IN DANGER OF BEING DESTROYED AND HAS NOT BEEN PROPERLY REFERENCED, THE CONTRACTOR SHALL NOTIFY THE DISTRICT LOCATION SURVEYOR IMMEDIATELY.
30. MAINTENANCE OF TRAFFIC FOR THIS PROJECT SHALL BE IN ACCORDANCE WITH THE MANUAL OF UNIFORM TRAFFIC CONTROL DEVICES FOR STREETS AND HIGHWAYS U.S. DEPARTMENT OF TRANSPORTATION (F.H.W.A.). ATTENTION IS DIRECTED TO STANDARD INDEX NUMBER 623 OF THE ROADWAY AND TRAFFIC DESIGN STANDARDS.
31. THE CONTRACTOR SHALL INSURE THAT INSTALLATION OF ALL PLANTING IN MEDIANES AND RIGHT OF WAYS CONFORMS TO CRITERIA SET FORTH IN F.D.O.T. ROADWAY AND TRAFFIC DESIGN STANDARDS AND IN F.D.O.T. MAINTENANCE RATING PROGRAM.
32. ANY MAINTENANCE THAT INVOLVES TRAFFIC ACTIVITY SHALL BE COORDINATED WITH THE COUNTY BEFORE AND DURING CONSTRUCTION ACTIVITIES.
33. CONTRACTOR IS RESPONSIBLE FOR CLEANING ALL WORK AREAS AT THE END OF EACH WORKING DAY. ANY DEBRIS SHALL BE COLLECTED AND DEPOSITED APPROPRIATELY OFF SITE DAILY. ALL MATERIALS, PRODUCTS, AND EQUIPMENT SHALL BE STORED IN AN ORGANIZED FASHION.
34. THE CONTRACTOR IS RESPONSIBLE FOR OBTAINING ALL PERMITS THAT ARE REQUIRED BY THE CITY FOR TREE REMOVAL, RELOCATION, TREE PROTECTION OR INSTALLATION BEFORE BEGINNING WORK.
35. ALL EXISTING TREES TO REMAIN SHALL BE PROTECTED BY INSTALLING PROTECTIVE BARRIERS AROUND THE DRIP LINE OF TREES. THESE PROTECTIVE BARRIERS SHALL BE SEEN EASILY BY OPERATORS OF TRUCKS AND OTHER EQUIPMENT. THEY SHALL BE CONSTRUCTED OF STURDY MATERIALS (NOT FLAGGING OR RIBBON) AND SHALL BE INSTALLED PRIOR TO AND DURING CONSTRUCTION.
36. DO NOT STORE OR USE ANY MATERIALS OR EQUIPMENT WITHIN THE DRIP LINE OF ANY TREE THAT IS TO BE RELOCATED OR PROTECTED IN PLACE UNLESS THE ACTIVITY IS BEING DONE TO PROTECT THE TREES.
37. DO NOT DISCHARGE OR CONTAMINATE THE SOIL WITHIN THE DRIP LINE OF ANY OF THE TREES TO BE RELOCATED OR PROTECTED IN PLACE. THIS INCLUDES SUBSTANCES SUCH AS PAINT, OIL, SOLVENTS, PETROLEUM PRODUCTS, ASPHALT, CONCRETE, MORTAR, OR ANY OTHER MATERIAL THAT MAY CAUSE DAMAGE TO THE TREE'S ROOT SYSTEM.
38. CLEARING OF VEGETATION WITHIN THE DRIP LINE OF THE TREES DESIGNATED TO BE PROTECTED IN PLACE OR RELOCATED SHALL BE PERFORMED CAUTIOUSLY WITH HAND TOOLS TO MINIMIZE ANY DAMAGE TO THE TREE'S ROOT SYSTEM.
39. DO NOT ATTACH ANYTHING TO TREES THAT ARE TO REMAIN ON THE SITE UNLESS IT IS SOMETHING THAT WILL PROTECT AND NOT DAMAGE THE TREE.
40. KEEP A NATURAL GRADE ABOVE THE DRIP LINE ON ANY TREE THAT IS TO BE PROTECTED IN PLACE. ANY PRESERVED TREES DISTURBED DURING CONSTRUCTION MUST BE RETURNED TO ITS ORIGINAL GRADE AFTER CONSTRUCTION.
41. ALL LANDSCAPE AND PLANTING SHALL COMPLY WITH COUNTY LAND USE POLICY AND WITH CHAPTER 62B-55 OF THE FLORIDA ADMINISTRATIVE CODE.
42. ALL PLANT MATERIAL FURNISHED BY THE CONTRACTOR UNLESS OTHERWISE SPECIFIED SHALL BE FLORIDA NO. 1 GRADE OR BETTER, AND SHALL BE INSTALLED AS SPECIFIED IN GRADES AND STANDARDS FOR NURSERY PLANTS PUBLISHED BY THE FLORIDA DEPARTMENT OF AGRICULTURE AND CONSUMER SERVICES. ALL PLANT MATERIAL MUST BE HEALTHY, VIGOROUS MATERIALS, FREE OF PESTS AND DISEASES.
43. ALL SIZES SHOWN FOR PLANT MATERIAL ON THE PLANS ARE TO BE CONSIDERED AS MINIMUMS. ALL PLANT MATERIAL MUST NOT EXCEED THESE MINIMUM REQUIREMENTS FOR BOTH HEIGHT AND SPREAD. ANY OTHER REQUIREMENTS FOR SPECIFIC SHAPE OR EFFECT AS NOTED ON THE PLAN OR SPECIFICATIONS WILL ALSO BE REQUIRED FOR ACCEPTANCE. ANY SUBSTITUTIONS MUST BE APPROVED BY THE CONSULTANT AND THE COUNTY.
44. THE CONTRACTOR IS RESPONSIBLE FOR ALL PLANTING MEETING SPECIFICATIONS AS NOTED BEFORE INSTALLATION. CONTRACTOR SHALL IMMEDIATELY REMOVE ALL PLANTING THAT DOES NOT MEET SPECIFICATIONS AND BE HELD RESPONSIBLE TO REPLACE IT WITH APPROPRIATE PLANTING.
45. IN THE EVENT OF A VARIATION BETWEEN THE PLANT LISTS AND THE ACTUAL QUANTITY OF PLANTS SHOWN, THE PLANS HOLD TRUE.
46. ALL ROOT BALLS SHALL CONFORM TO THE SIZE STANDARDS SET FORTH.
47. ALL PLANT MATERIALS MUST BE PROTECTED DURING TRANSPORT AND DELIVERY TO THE JOB SITE WITH SHADE CLOTH OR OTHER ACCEPTABLE MEANS OF WINDBURN PREVENTION.
48. CONTRACTORS SHALL FIELD VERIFY ALL INFORMATION PRIOR TO INITIATING PLANTING INSTALLATION. ALL EXISTING PLANTING SHALL REMAIN INTACT AND UNDISTURBED UNLESS OTHERWISE NOTED ON THE PLANS.
49. CONTRACTOR SHALL FIELD STAKE THE LOCATION OF ALL PLANT MATERIAL PRIOR TO INSTALLATION FOR THE REVIEW AND APPROVAL OF THE CONSULTANT.
50. ALL TREES MUST BE FLORIDA #1, STRAIGHT TRUNKED, FULL HEADED, AND MEET ALL REQUIREMENTS SPECIFIED.
51. CONTRACTOR TO REPLACE REJECTED PLANT MATERIAL WITHIN ONE WEEK OF NOTICE.

SOIL PREPARATION, SOIL MIX, FERTILIZER, & MULCH NOTES:

52. INSTALLATION- ALL PLANT MATERIAL SHALL BE INSTALLED IN A SOUND HIGH QUALITY MANNER AND ACCORDING TO GOOD PLANTING PROCEDURES WITH THE QUALITY OF PLANT MATERIALS AS HERINAFTER DESCRIBED. ALL ELEMENTS OF LANDSCAPING SHALL BE INSTALLED SO AS TO MEET ALL APPLICABLE ORDINANCES AND CODE REQUIREMENTS.
53. CONTRACTOR IS RESPONSIBLE FOR WATERING AND MAINTAINING ALL TREES AND LANDSCAPE PER DIVISION 32. CONTRACTOR SHALL INSURE THAT ALL DRAINAGE AND PERCOLATION OF ALL PLANTING PITS PRIOR TO INSTALLATION OF PLANT MATERIAL. CONTRACTOR IS RESPONSIBLE FOR REPLACEMENT OF PLANTS IF DEAD OR DYING PRIOR TO FINAL ACCEPTANCE.
54. TYPICALLY SHRUB AND GROUNDCOVER PLANTINGS ARE SHOWN AS MASS PLANTING BEDS. PLANTS SHOULD BE PLACED ON A TRIANGULAR SPACING SHOWN IN THE PLANTING DETAILS. PLANT CENTER TO CENTER DIMENSIONS (O.C.) ARE LISTED ON THE PLANT LIST.
55. TREES GROWN IN GROW BAGS OR GROW BAG TYPE MATERIAL MUST HAVE THE GROW BAG REMOVED ENTIRELY BEFORE PLANTING.
56. BALLED AND BURLAPPED MATERIAL SHALL HAVE THE TOP ONE HALF (1/2) OF THE BURLAP AROUND THE BASE OF THE TRUNK CUT AND PULLED BACK. DO NOT REMOVE THE BURLAP BUT WIRE CAGES, STRAPS, ETC. MUST BE CUT AND REMOVED COMPLETELY BEFORE INSTALLATION.
57. CONTRACTOR SHALL REFER TO THE LANDSCAPE PLANTING DETAILS, PLANT LIST, GENERAL NOTES, AND ANY OTHER MATERIALS FROM THE LANDSCAPE ARCHITECT FOR COMPLETE LANDSCAPE PLANTING INSTRUCTIONS.
58. THE FOLLOWING GUIDELINES SHALL BE FOLLOWED TO ENSURE SUCCESSFUL TRANSPLANTING OF TREES:
a. ANY TREE BEING RELOCATED SHALL NOT BE UNNECESSARILY DAMAGED DURING REMOVAL, TRANSPORT, OR REPLANTING OF THAT TREE.
b. TREES MUST BE ROOT PRUNED APPROPRIATELY PRIOR TO REMOVAL.
c. DURING AND FOLLOWING TRANSPLANTING THE ROOT BALL MUST BE KEPT MOIST AT ALL TIMES.
d. TRANSPLANTED TREES SHALL BE BRACED AT LEAST ONE FULL YEAR.
e. TRANSPLANTED TREES SHALL NOT BE FERTILIZED AT PLANTING TIME BUT SHALL BE WATERED SUFFICIENTLY UNTIL THE TREE GROWTH IS REESTABLISHED.
f. RELOCATED TREES/PALMS WILL BE MOVED IN ACCORDANCE WITH MINIMUM STANDARDS SET FORTH IN ANSI A-300.
g. ALL CROWN PRUNING SHALL BE DONE IN ACCORDANCE WITH NATIONAL ARBORIST ASSOCIATION STANDARDS OR PALM PRUNING IN ACCORDANCE WITH CITY STANDARDS.
59. CONTRACTOR SHALL REGRADE ALL AREAS DISTURBED BY PLANT REMOVAL, RELOCATION, AND/OR INSTALLATION WORK. CONTRACTOR SHALL REPLACE (BY EQUAL SIZE AND QUALITY) ANY AND ALL EXISTING PLANT MATERIAL DISTURBED OR DAMAGED BY PLANT REMOVAL, RELOCATION OR INSTALLATION.
60. CONTRACTOR SHALL BE RESPONSIBLE TO REPLACE ALL PORTIONS OF EXISTING LAWN AREAS DAMAGED WHILE COMPLETING PLANTING INSTALLATION WITH SAME GRASS SPECIES TO THE SATISFACTION OF THE CONSULTANT AND THE COUNTY.
61. GENERAL GRADING TO APPROXIMATELY 1 INCH SHALL BE PROVIDED BY THE CONTRACTOR. ALL FINISHED SITE GRADING AND FINAL DECORATIVE BERM SHAPING SHALL BE PROVIDED BY THE CONTRACTOR.
62. ALL LANDSCAPE MATERIALS SHALL BE MAINTAINED TO PROVIDE CONTINUOUS CLEAR ZONES FOR SIGHT VISIBILITY FOR PEDESTRIANS AND VEHICULAR TRAFFIC AND LANDSCAPE MAINTENANCE SHALL CONFORM TO STANDARD INDEX 546 CRITERIA SET FORTH IN F.D.O.T. ROADWAY AND TRAFFIC DESIGN STANDARDS.
63. APPLICATION SCHEDULE: WATER NEW TREES, PALMS, AND SHRUBS EVERY DAY FOR THE FIRST TWO WEEKS, THREE TIMES A WEEK FOR THE SECOND TWO WEEKS, AND THREE TIMES A WEEK FOR THE NEXT EIGHT WEEKS FOR A TOTAL OF A SIX DAY WATERING PERIOD. NO FURTHER WATERING WILL BE REQUIRED. HAND WATERING SCHEDULE TO START AT FINAL ACCEPTANCE OF PROJECT.
64. EARTH BERM 4" HIGH OUTSIDE THE PROPOSED ROOT BALL PRIOR TO WATERING. APPLY A MINIMUM OF 4" OF WATER WITHIN THE SAUCER, OR 1.3 GALLONS PER INCH OF TRUNK DIAMETER, WHICH EVER IS MORE AT EACH WATERING. WATER APPLICATION SHOULD SATURATE THE ROOT BALL TO ITS ENTIRE DEPTH. DO NOT WATER IF ROOT BALL IS ALREADY SATURATED.
65. HANDWATERING IS IN ADDITION TO THE UNDERGROUND IRRIGATION SYSTEM.
66. THE CONTRACTOR MUST REPAIR, AT CONTRACTOR'S SOLE COST, ALL DAMAGE DONE TO ANY NEW OR EXISTING LANDSCAPE ITEMS DURING THE COURSE OF CONSTRUCTION INCLUDING BUT NOT LIMITED TO NOT LIMITED TO TREES, SHRUBS, GROUNDCOVER, SOD OR ASSOCIATED PROPERTY, OR IRRIGATION SYSTEMS EQUIPMENT, ETC. AND MUST BEAR ALL COSTS ASSOCIATED WITH SAME. IN NO EVENT, BUT NOT THE LIMITED TO, REDESIGN, RE-LEVEL, RE-POSITION, OR RELOCATE ANY CONSTRUCTION ITEM, THE CONTRACTOR IS RESPONSIBLE FOR IT AND MUST REPLACE ALL LANDSCAPE RELATED ITEMS, AND ANY UNDERGROUND ACCESSORY EQUIPMENT DAMAGED DURING CONSTRUCTION AND MUST BEAR ALL COSTS ASSOCIATED WITH SAME. THE REPAIR OF ANY NEW OR EXISTING CONSTRUCTION OR PROPERTY MUST RESTORE SUCH CONDITIONS PRIOR TO COMMENCEMENT OF THE CONSTRUCTION, AND IN CONFORMANCE WITH APPLICABLE CODES, STANDARDS, REGULATIONS, STANDARDS, REQUIREMENTS AND STATUTES. THE CONTRACTOR MUST REPAIR OR COMPENSATE ASSOCIATED WITH SAME. THE CONTRACTOR MUST PROMPTLY DOCUMENT ALL EXISTING DAMAGE AND NOTIFY, IN WRITING, THE OWNER AND THE CONSTRUCTION MANAGER PRIOR TO THE START OF CONSTRUCTION.
67. IF PROVIDED, REFER TO IRRIGATION PLANS FOR ADDITIONAL NOTES AND DETAILS.

IRRIGATION NOTES:

1. XERISCAPE PRINCIPLES HAVE BEEN APPLIED TO THIS LANDSCAPE PLAN AS SPECIFIED IN SFWMD's XERISCAPE PLANT GUIDE II AND SHALL BE APPLIED ALL THROUGHOUT LANDSCAPE INSTALLATION AND MAINTENANCE.
2. THE CONTRACTOR SHALL MAINTAIN TEMPORARY IRRIGATION OR PROVIDE HAND WATERING FOR ALL RELOCATED TREES AND PALMS FROM NOTICE TO PROCEED UNTIL PERMANENT IRRIGATION SYSTEM IS OPERABLE.
3. THE IRRIGATION SYSTEM SHALL BE CONFIGURED TO ACCOMMODATE EXISTING TREES AND PALMS PER PLANS.
4. ALL LANDSCAPED AREAS MUST BE IRRIGATED IN ACCORDANCE WITH ALL LOCAL/ COUNTY REQUIREMENTS.
5. REMOVE EXISTING IRRIGATION EQUIPMENT WHICH INTERFERES WITH ANY CONSTRUCTION. THIS INCLUDES, BUT IS NOT LIMITED TO, CONTROLLERS, SPRINKLER HEADS, PIPE, QUICK COUPLERS, BACKFLOW PREVENTERS, CONTROL WIRE AND CONDUITS. ADDITIONALLY THE CONTRACTOR IS RESPONSIBLE FOR MAINTAINING THE EXISTING SYSTEM THROUGHOUT THE CONSTRUCTION PROCESS.
6. CONTRACTOR SHALL COORDINATE ALL PLANTING WORK WITH IRRIGATION WORK. INSPECT IRRIGATION SYSTEM AND INSURE THAT ADEQUATE WATER IS AVAILABLE BEFORE BEGINNING PLANTING OPERATIONS. IRRIGATION SYSTEMS WILL NOT PROVIDE SUFFICIENT QUANTITIES OF WATER FOR NEWLY PLANTED MATERIALS. THE LANDSCAPE CONTRACTOR IS RESPONSIBLE FOR DEEP ROOT HAND WATERING.

7.

IF PROVIDED, REFER TO IRRIGATION PLANS FOR ADDITIONAL NOTES AND DETAILS.



ISSUED FOR MUNICIPAL & AGENCY REVIEW & APPROVAL

THIS DRAWING IS INTENDED FOR MUNICIPAL AND/ OR AGENCY REVIEW AND APPROVAL. IT IS NOT INTENDED AS A CONSTRUCTION DOCUMENT UNLESS INDICATED OTHERWISE.

PROJECT No.: FLA250080 00-0A
DRAWN BY: TM/EP
CHECKED BY: BV/KA
DATE: 9/15/25
CADD ID: P-CIVIL-LAND

SITE CONSTRUCTION PLANS



LAUREL ROAD & TWIN
LAUREL BOULEVARD
NOKOMIS, FL 34275
CITY OF VENICE
S 29; T 38 S; R 19 E

BOHLER //
600 N. WESTSHORE BLVD. SUITE 950
TAMPA, FLORIDA 33609
Phone: (813) 812-4100
Fax: (813) 812-4101

FLORIDA BUSINESS CERT. OF AUTH. No. 30780
THIS ITEM HAS BEEN DIGITALLY SIGNED AND
SEALED BY GRETTE MCGEE, W/ SIGNMAN, ON
THE DATE ADJACENT TO THE SEAL. THE SIGNATURE MUST
BE VERIFIED ON ANY ELECTRONIC COPIES.

LANDSCAPE NOTES

SHEET NUMBER:

L-705

REVISION 2 - 11/06/25