

PLANT SCHEDULE							
SYMBOL	CODE	QTY	BOTANICAL NAME	COMMON NAME	SIZE	CONTAINER	NATIVE
TREES							
BS	49		BURSERA SIMARUBA	GUMBO LIMBO	4" CAL. - 14' OA. HT. MIN.	CONT/B&B	NATIVE
EF	28		EUGENIA FOETIDA	SPANISH STOPPER	2.5" CAL. 8 HT X 6' SPRD	CONT/B&B	NATIVE
MG	14		MAGNOLIA GRANDIFLORA	SOUTHERN MAGNOLIA	3" CAL. 12' OA. HT. X 6' SPRD.	CONT/B&B	NATIVE
PE	17		PINUS ELLIOTTII VAR. DENSA	FLORIDA SLASH PINE	3" CAL. 12' OA. MIN. HT. X 6-8' SPRD.	CONT/B&B	NATIVE
QV	52		QUERCUS VIRGINIANA	SOUTHERN LIVE OAK	3" CAL. 12' OA. HT. X 6' SPRD.	CONT/B&B	NATIVE
TD	23		TAXODIUM DISTICHUM	BALD CYPRESS	3" CAL. 12' OA. HT. X 6' SPRD.	CONT/B&B	NATIVE
SHRUB AREAS							
CHR	719		CHRYSOBALANUS ICACO 'RED TIP'	RED TIP COCO PLUM	24" HT X 24" SPRD	CONTAINER	NATIVE
CME	250		CARISSA MACROCAPP'A 'EMERALD BLANKET'	EMERALD BLANKET NATAL PLUM	36" HT X 36" SPRD.	CONTAINER	NO
IVN	357		ILEX VOMITORIA 'NANA'	DWARF YAUPOON HOLLY	36" HT X 36" SPRD.	CONTAINER	NATIVE
LMB	1,868		LIRIOPE MUSCARI 'BIG BLUE'	BIG BLUE LILYTURF	12" HT. X 12" SPRD.	CONTAINER	NO
RHI	371		RHAPHOLEPIS INDICA	INDIAN HAWTHORN	36" HT X 36" SPRD.	CONTAINER	NATIVE
BUILDING FOUNDATION SHRUBS							
LMB-F	12		LIRIOPE MUSCARI 'BIG BLUE'	BIG BLUE LILYTURF	12" HT. X 12" SPRD.	CONTAINER	NO
RHI-F	16		RHAPHOLEPIS INDICA	INDIAN HAWTHORN	36" HT. X 36" SPRD.	CONTAINER	NO
SOD							
SOD	53,206 SF		STENOTAPHRUM SECUNDATUM 'PALMETTO'	PALMETTO ST. AUGUSTINE GRASS	FULL, TIGHT COVERAGE	PALLET	NO



PROP SITE LEGEND	
PROPERTY LINE	—
EASEMENT LINE	—
SETBACK LINE	—
INTERIOR PROPERTY LINE	—
LEASE LINE	—
LIMIT OF WORK	—
LIMIT OF DISTURBANCE	—
CURB	—
UTILITY POLE	●
TYPICAL SIGN	▼
BOLLARD	○
UTILITY POLE W/ LIGHT	●—○
TYPICAL LIGHT	●—○
PARKING COUNT	(X)



ISSUED FOR MUNICIPAL & AGENCY REVIEW & APPROVAL

THIS DRAWING IS INTENDED FOR MUNICIPAL AND/OR AGENCY REVIEW AND APPROVAL. IT IS NOT INTENDED AS A CONSTRUCTION DOCUMENT UNLESS INDICATED OTHERWISE.

PROJECT No.: FLA250080.00-0A
DRAWN BY: TM/EP
CHECKED BY: BV/KA
DATE: 9/15/25
CAD ID.: P-CIVL-LAND

PROJECT:
SITE CONSTRUCTION PLANS

FOR
THE HOME DEPOT
THE HOME DEPOT
VENICE

LAUREL ROAD & TWIN
LAUREL BOULEVARD
NOKOMIS, FL 34275
CITY OF VENICE
S 29; T 38 S; R 19 E

BOHLER

600 N. WESTSHORE BLVD. SUITE 950
TAMPA, FLORIDA 33609
Phone: (813) 812-4100
Fax: (813) 812-4101

FLORIDA BUSINESS CERT. OF AUTH. No. 30780


THIS ITEM HAS BEEN DIGITALLY SIGNED AND
SERIALIZED BY GRET MCGEE, W. MCGEE, JR. ON THE
DATE ADJACENT TO THE SIGNATURE. THE SIGNATURE MUST
BE VERIFIED ON ANY ELECTRONIC COPIES.

SHEET TITLE:


LANDSCAPE PLAN

SHEET NUMBER:
L-702

REVISION 1 - 9/11/25

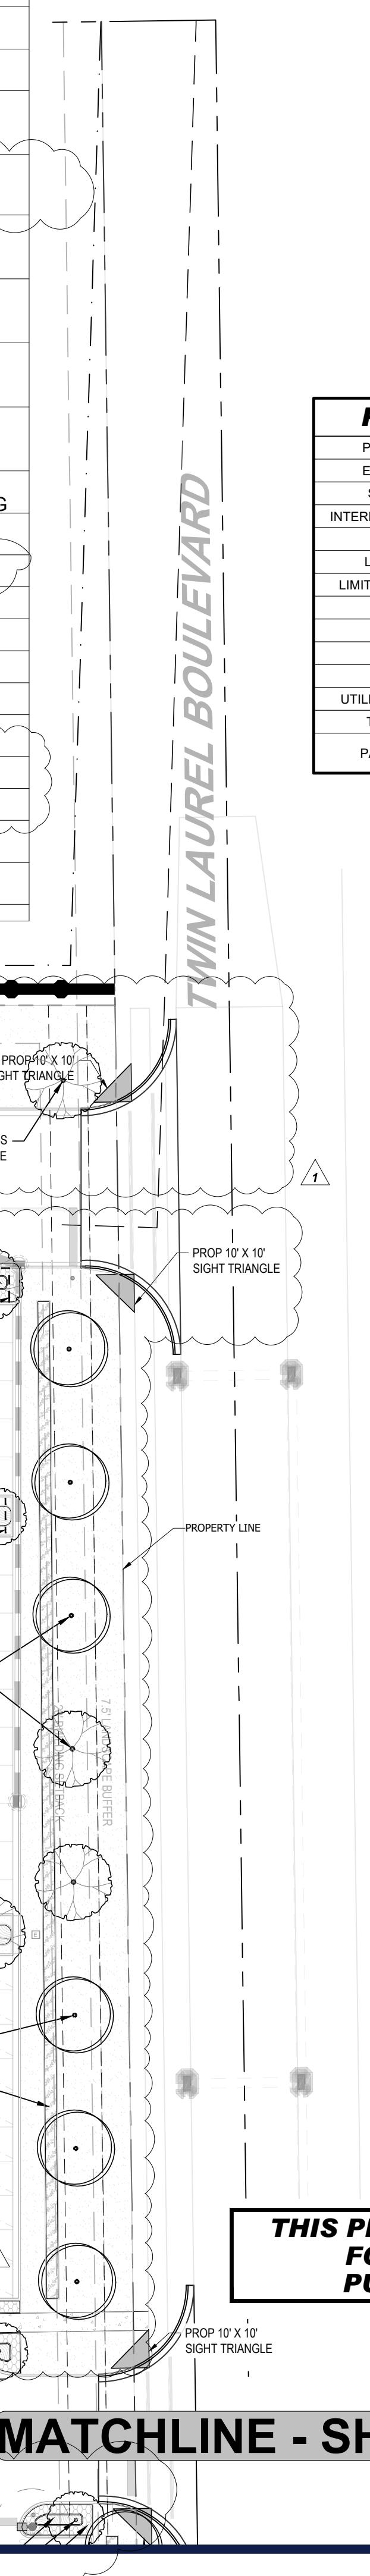

MATCHLINE - SHEET L-703

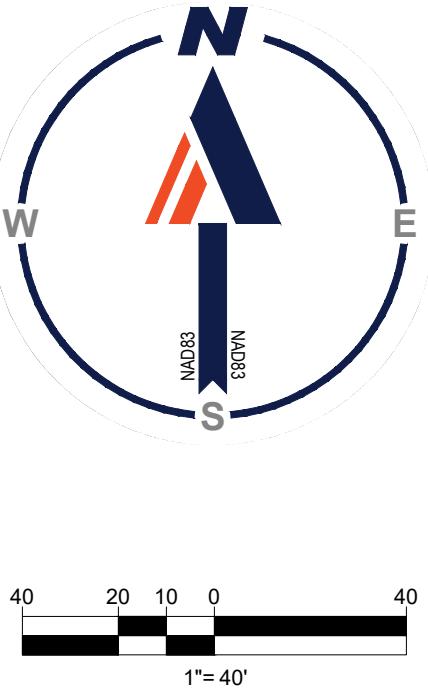

MATCHLINE - SHEET

L-702

BUILDING = 106,651 SF
GARDEN CENTER = 28,156
TOTAL = 134,807 SF
401 PARKING SPACES
FFE = 16.50

PROP SITE LEGEND

PROPERTY LINE	
EASEMENT LINE	
SETBACK LINE	
EXTERIOR PROPERTY LINE	
LEASE LINE	
LIMIT OF WORK	LOW
LIMIT OF DISTURBANCE	LOD
CURB	
UTILITY POLE	
TYPICAL SIGN	
BOLLARD	
UTILITY POLE W/ LIGHT	
TYPICAL LIGHT	
PARKING COUNT	

REVISION




WING IS INTENDED FOR MUNICIPAL AND/OR AGENCY
APPROVAL. IT IS NOT INTENDED AS A CONSTRUCTION
DOCUMENT UNLESS INDICATED OTHERWISE.

T No.: FLA250080.00-0A
BY: TM/EP
D BY: BW/KA
9/15/25

SITE CONSTRUCTION PLANS



LAUREL ROAD & TWIN
LAUREL BOULEVARD
NOKOMIS, FL 34275
CITY OF VENICE
S 29° T 38 S: R 19 E



LANDSCAPE PLAN

NUMBER: _____

L-703

REVISION 1 - 9/11/25

**THIS PLAN TO BE UTILIZED
FOR LANDSCAPE
PURPOSES ONLY**

REVISION 1 - 9/11/25

REVISIONS		
REV	DATE	COMMENT
1	9/11/25	CITY OF VENICE EP KA



ISSUED FOR MUNICIPAL & AGENCY REVIEW & APPROVAL

THIS DRAWING IS INTENDED FOR MUNICIPAL AND/OR AGENCY REVIEW AND APPROVAL. IT IS NOT INTENDED AS A CONSTRUCTION DOCUMENT UNLESS INDICATED OTHERWISE.

PROJECT No.: FLA250080.00-0A
DRAWN BY: TM/EP
CHECKED BY: BV/KA
DATE: 9/1/25
CAD ID.: P-CIVIL-LAND

SITE CONSTRUCTION PLANS



LAUREL ROAD & TWIN
LAUREL BOULEVARD
NOKOMIS, FL 34275
CITY OF VENICE
S 29; T 38 S; R 19 E

BOHLER //
 600 N. WESTSHORE BLVD. SUITE 950
 TAMPA, FLORIDA 33609
 Phone: (813) 812-4100
 Fax: (813) 812-4101
 FLORIDA BUSINESS CERT. OF AUTH. No. 30780


THIS ITEM HAS BEEN DIGITALLY SIGNED AND
SEALED BY GRETCHEN MCGOWAN, W/ SIGNMAN, X, ON THE
DATE ADJACENT TO THE SEAL. THE SIGNATURE MUST
BE VERIFIED ON ANY ELECTRONIC COPIES.

SHEET TITLE:

LANDSCAPE DETAILS


SHEET NUMBER:
L-704

REVISION 1 - 9/11/25

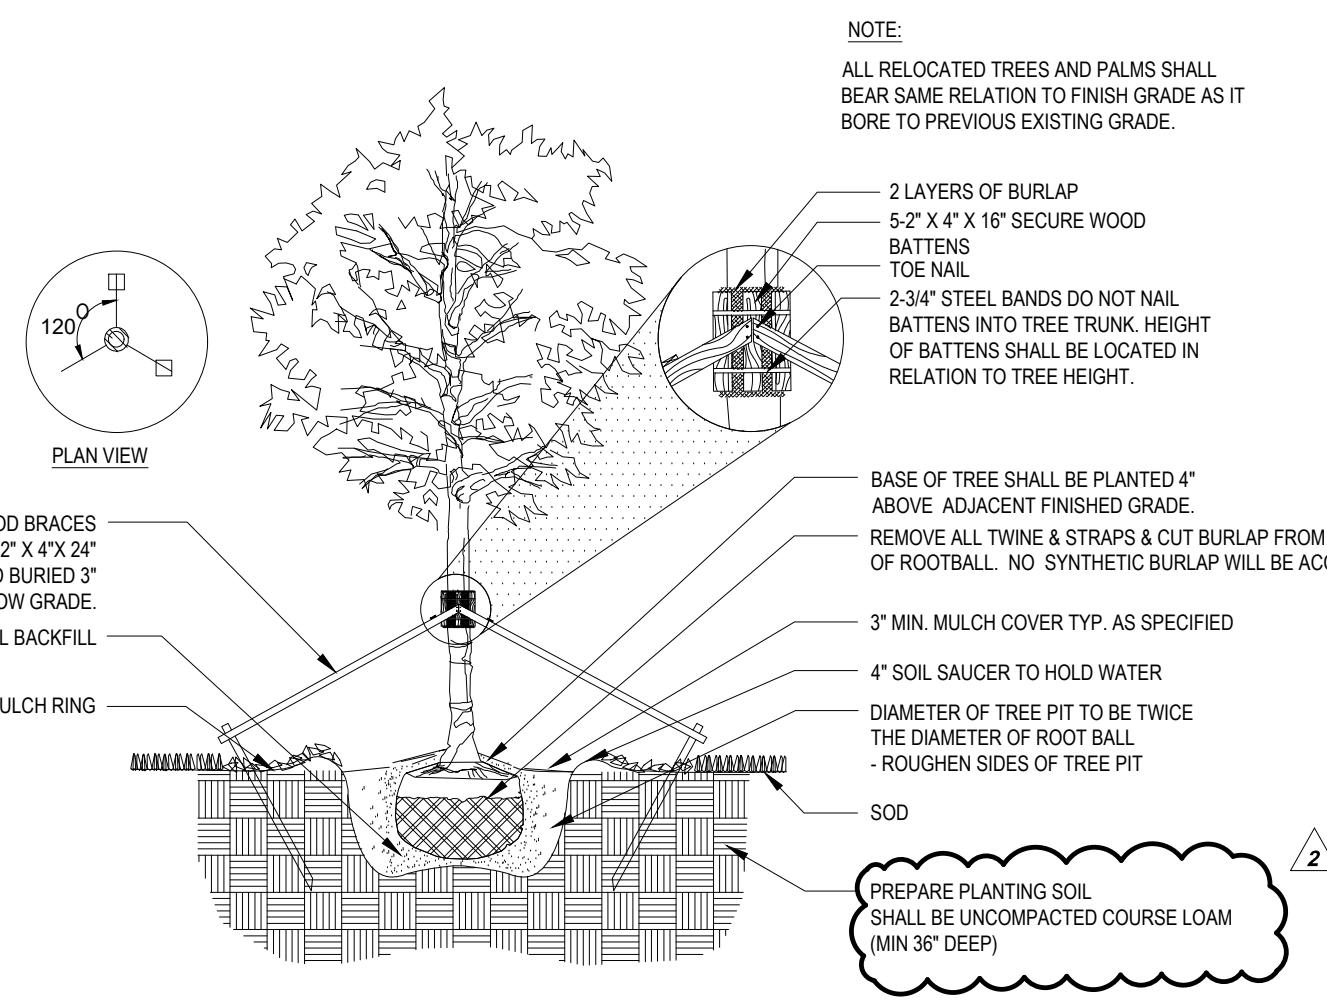


1 TREE INSTALLATION
SECTION

NTS

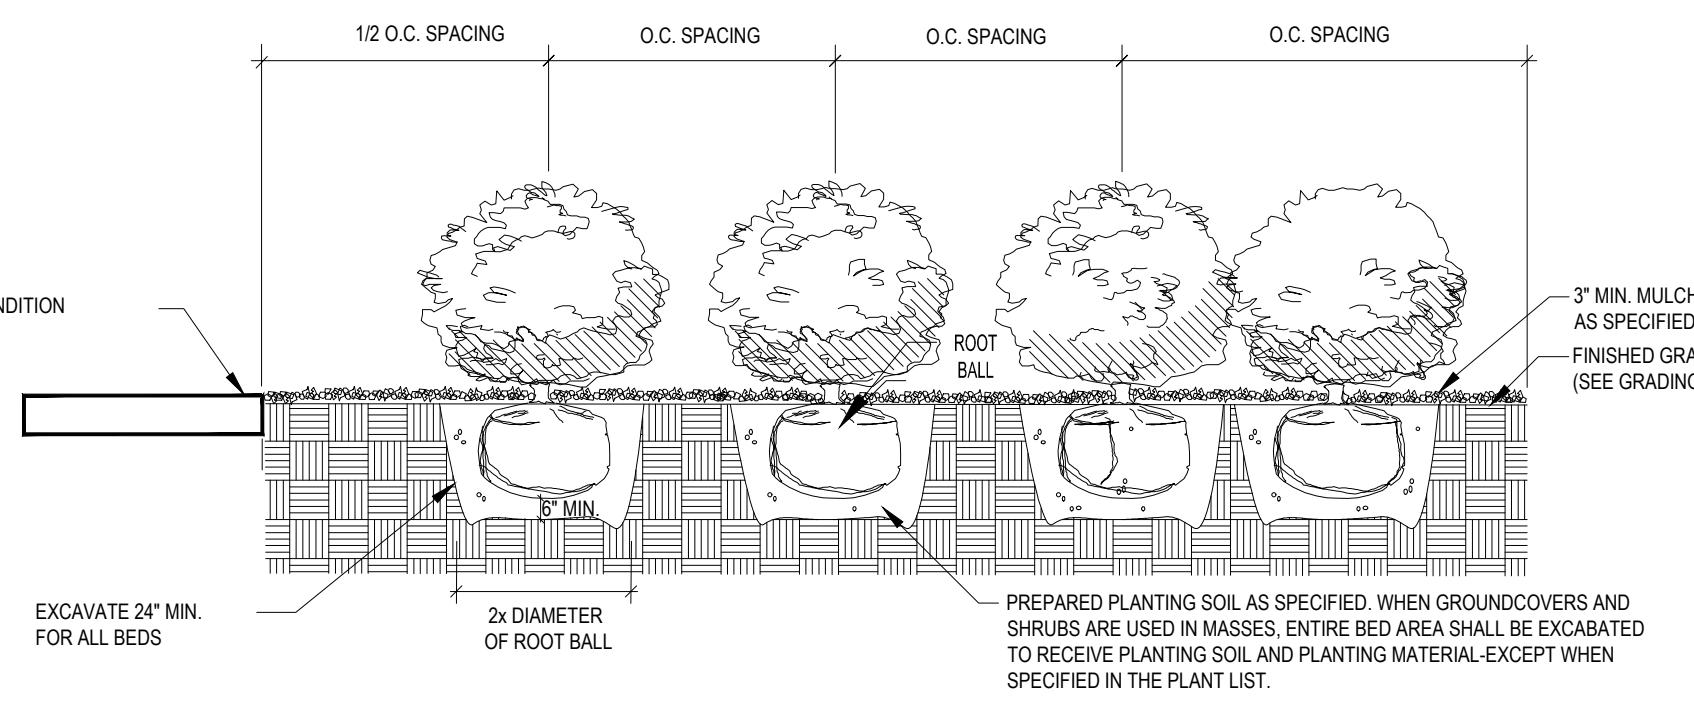


4 SHRUB PLANTING
SECTION

NTS

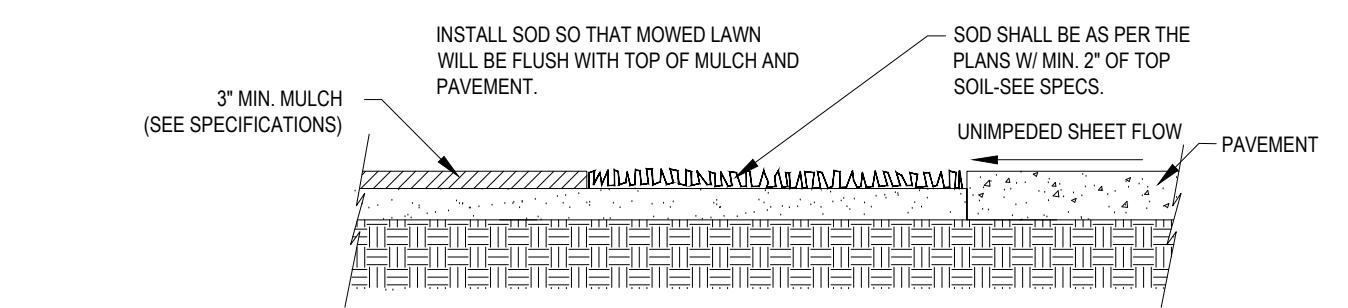


7 SOD INSTALLATION
SECTION

NTS

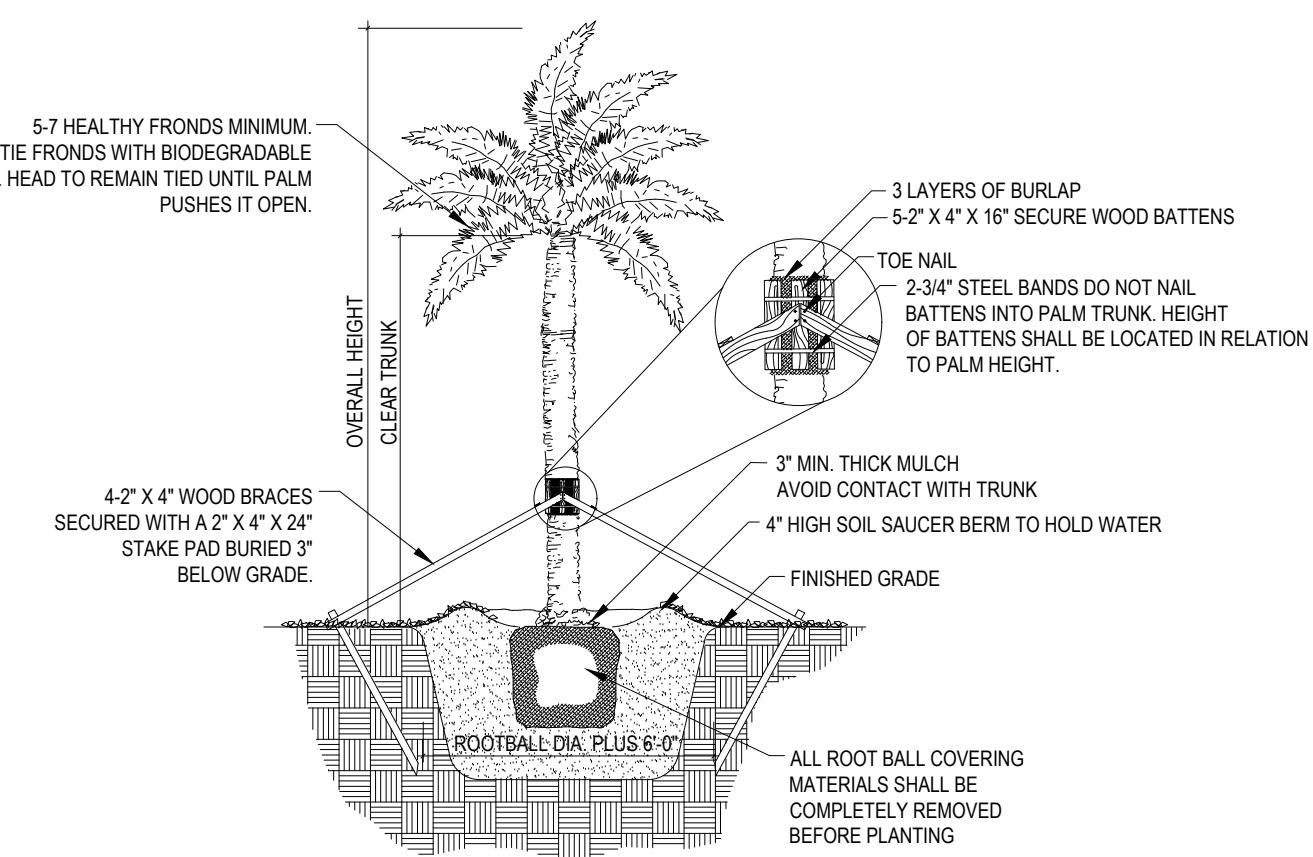


2 PALM INSTALLATION
SECTION

NTS

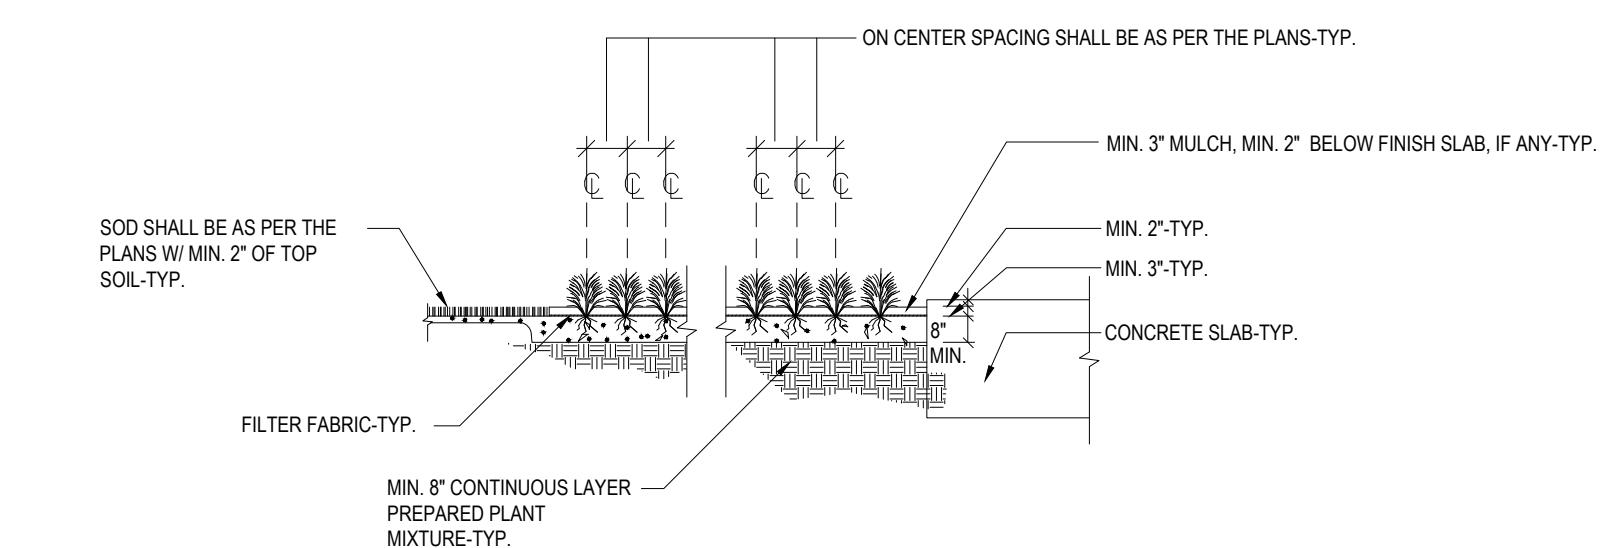


5 GROUNDCOVER PLANTING
SECTION

NTS

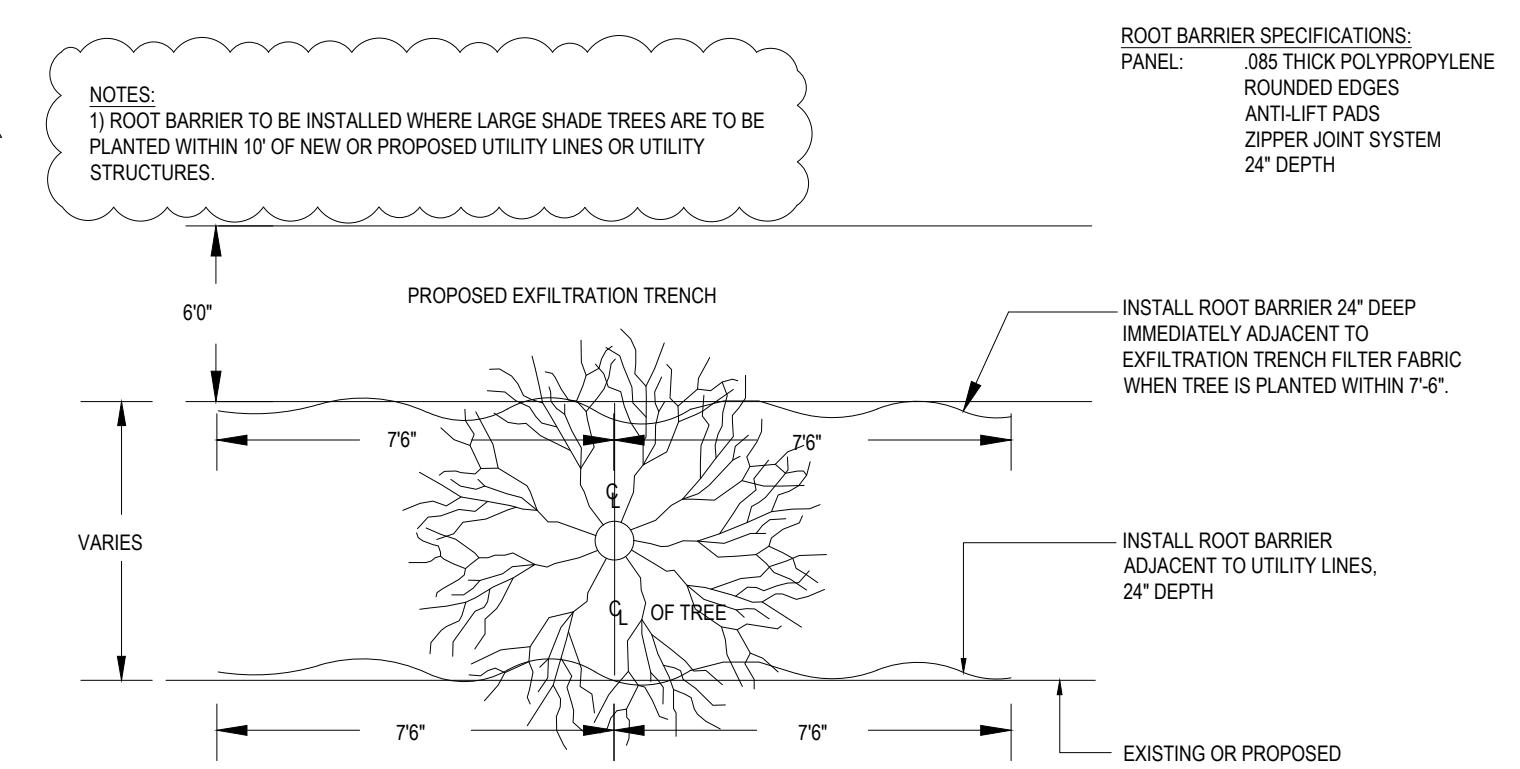


8 ROOT BARRIER
SECTION

NTS

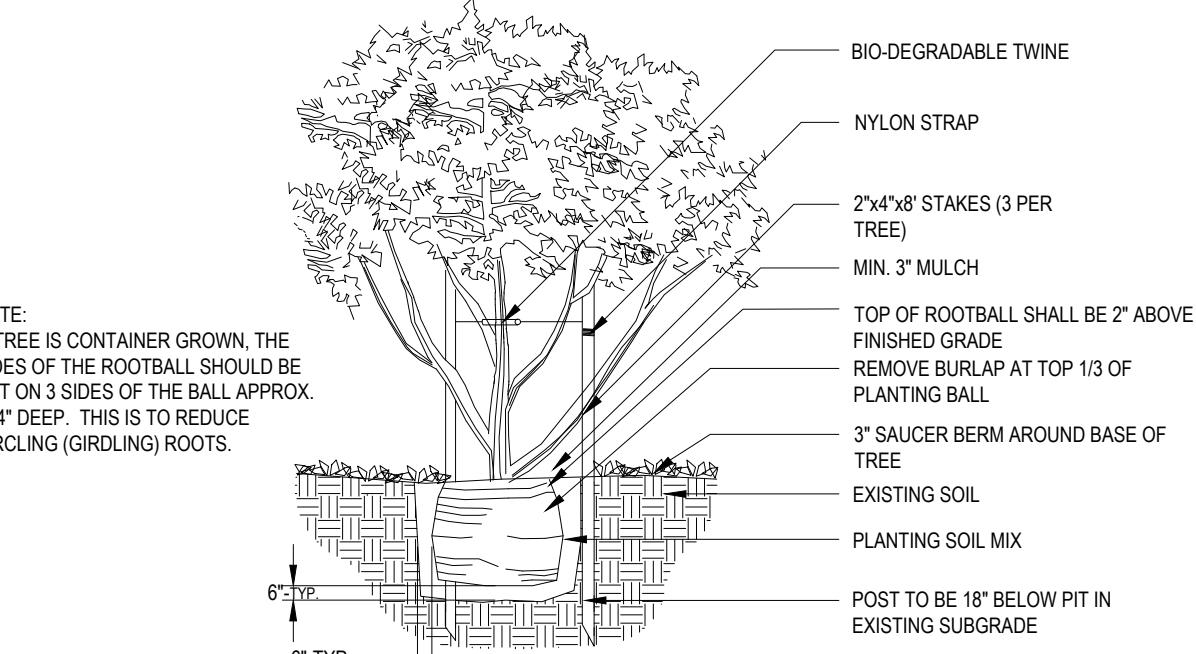

3 SMALL TREE
SECTION

NTS

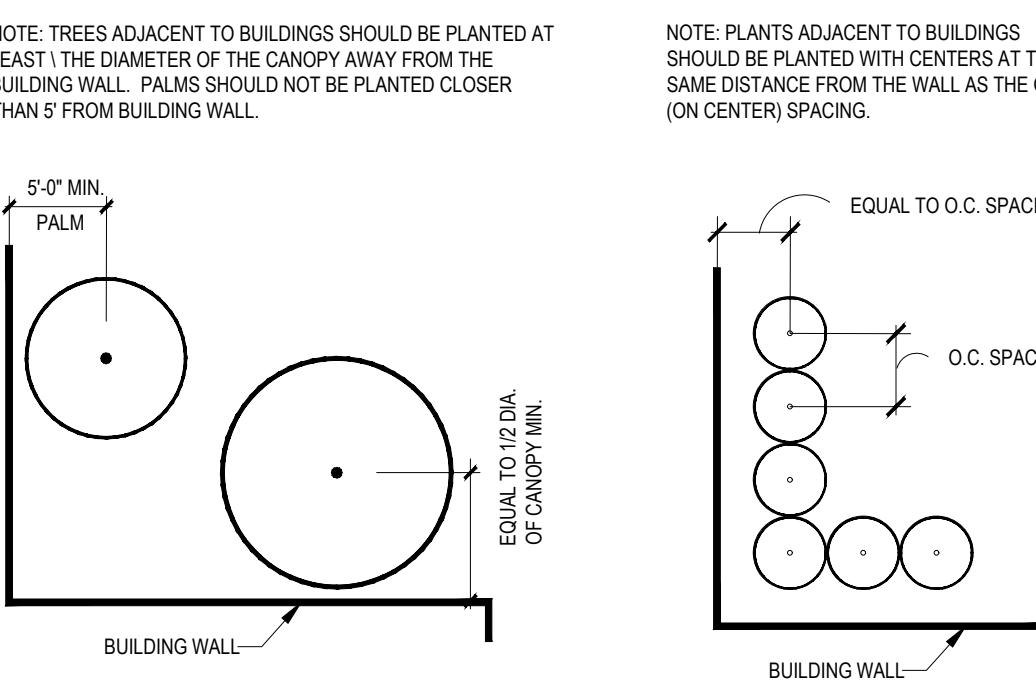

6 PLANTING ADJACENT TO BUILDING
SECTION

NTS



ISSUED FOR MUNICIPAL & GENCY REVIEW & APPROVAL

**S DRAWING IS INTENDED FOR MUNICIPAL AND/OR AGENCY
W AND APPROVAL. IT IS NOT INTENDED AS A CONSTRUCTION
DOCUMENT UNLESS INDICATED OTHERWISE.**

JECT No.: FLA250080.00-0A
WN BY: TM/EP

SITE CONSTRUCTION PLANS



THE HOME DEPOT
VENICE

LAUREL ROAD & TWIN
LAUREL BOULEVARD
NOKOMIS, FL 34275
CITY OF VENICE

Fax: (813) 812-4101

THIS ITEM HAS BEEN DIGITALLY SIGNED AND
SEALED BY BRETT MICHAEL WALDMAN, LA, ON THE
DATE ADJACENT TO THE SEAL. SIGNATURE MUST

ET TITLE:

ET NUMBER:
1.705

10 of 10 | Page

REVISION 1 - 9/11/25

LANDSCAPE NOTES:

1. A PRE-INSTALLATION MEETING WITH THE CITY ARBORIST IS REQUIRED PRIOR TO LANDSCAPING ACTIVITIES INCLUDING REMOVAL OF TREES AND/OR INSTALLATION OF PLANT MATERIAL.

2. ALL EXISTING TREES PROPOSED TO REMAIN ARE TO BE SEPARATED FROM THE LIMITS OF DISTURBANCE OF THE CONSTRUCTION AREA BY TREE PROTECTION FENCING AND SIGNAGE. THE TREE PROTECTION FENCING SHALL BE LOCATED AT THE EDGE OF THE TREE PROTECTION ZONE AS DEPICTED ON THE PLAN OR AT THE EDGE OF THE DRIPLINE(S) IF A TREE PROTECTION ZONE IS NOT DESIGNATED. NO MATERIAL STORAGE OR CONSTRUCTION ACCESS IS PERMITTED WITHIN THE TREE PROTECTION ZONE.

3. ALL EXISTING TREES SHALL BE PRUNED TO ANSI A-300 STANDARDS TO CORRECT POTENTIAL HAZARDS.

4. A TREE REMOVAL PERMIT IS REQUIRED PRIOR TO REMOVAL OR RELOCATION OF ANY TREE OR PALM. CONTACT THE COUNTY TO OBTAIN PERMIT INFORMATION.

5. CONTRACTOR SHALL NOTIFY SUNSHINE ONE CALL OF FLORIDA, INC. AT 1-800-432-4770 A MINIMUM OF 2 FULL BUSINESS DAYS PRIOR TO DIGGING. CONTRACTOR IS RESPONSIBLE FOR AVOIDING DAMAGE TO UTILITIES FROM PLANT INSTALLATION.

6. TREE RELOCATIONS:
 A. EXISTING TREES TO BE RELOCATED SHALL BE ROOT PRUNED A MINIMUM OF 120 DAYS PRIOR TO RELOCATION
 B. MINIMUM ROOT BALL SIZES SHALL BE IN ACCORDANCE WITH ANSI STANDARDS AS FOLLOWS:

CALIPER	MINIMUM ROOT BALL DIAMETER
1	16
2	24
3	32
4	42
5	54
6	60
7	70
8	80
>8	12 INCHES PER INCH OF TRUNK DIAMETER

TRANSPLANTED TREES WITH UNDERSIZED ROOT BALLS MAY BE REJECTED BY THE CITY ARBORIST AND REPLACEMENT TREES MAY BE REQUIRED.

C. A TEMPORARY IRRIGATION SYSTEM SHALL BE PROVIDED DURING AND FOR THE FIRST 40 DAYS AFTER ROOT PRUNING.

7. ALL PLANTING MUST FOLLOW PLANTING SPECIFICATIONS AND DETAILS SHOWN ON THE PLAN.

8. SUBSTITUTIONS OF PLANT SPECIES OR SPECIFICATIONS MUST BE APPROVED IN WRITING BY THE CITY AND COUNTY PRIOR TO USE.

9. ALL INVASIVE EXOTIC VEGETATION SHALL BE DISPOSED OF OR TREATED AS PER THE LOCAL OR REGIONAL GOVERNING AUTHORITIES REQUIREMENTS OR RECOMMENDATIONS.

10. ALL PLANT MATERIAL PLANTED PER THIS LANDSCAPE PLAN SHALL BE FLORIDA GRADE #1 OR BETTER, AS SPECIFIED IN THE CURRENT EDITION OF THE FLORIDA DEPARTMENT OF AGRICULTURE'S GRADES AND STANDARDS FOR NURSERY PLANTS. DAMAGED PLANT MATERIAL SHALL BE REJECTED AND REPLACED PRIOR TO INSTALLATION.

11. ALL SIZES SHOWN FOR PLANT MATERIAL ARE TO BE CONSIDERED MINIMUMS.

12. WHERE QUANTITIES AND/OR SPECIES DIFFER BETWEEN THE PLANTING PLANS AND PLANT LISTS, THE PLANS SHALL TAKE PRECEDENCE.

13. ALL NEW PLANT MATERIAL SHALL BE WARRANTED BY THE CONTRACTOR FOR A MINIMUM PERIOD OF ONE YEAR. THE WARRANTY PERIOD SHALL BEGIN AFTER ACCEPTANCE OF THE PLANTS BY THE CITY AND COUNTY.

14. PLANT BEDS TO BE TREATED WITH PRE-EMERGENT HERBICIDE PRIOR TO PLANTING.

15. ALL TREE AND PALM STAKING AND SUPPORT SHALL BE REMOVED ONE YEAR AFTER INSTALLATION.

16. ALL LANDSCAPE MATERIAL SHALL BE THOROUGHLY WATERED AT THE TIME OF PLANTING, NO DRY PLANTING PERMITTED.

17. CONTRACTOR SHALL BE RESPONSIBLE FOR PROVIDING TEMPORARY WATER PROVISIONS UNTIL SUCH TIME AS THE IRRIGATION SYSTEM IS OPERATIONAL.

18. ALL WIRE GUYS AND/OR FABRIC STRAPS SHALL BE FLAGGED WITH FLORESCENT COLORED TAPE.

19. MULCHING:
 ALL LANDSCAPE AREAS NOT COVERED BY SOD SHALL BE COVERED BY A MINIMUM 3-INCH LAYER OF MULCH.
 D. A MULCH RING WITH A MINIMUM RADIUS OF 24 INCHES (48 INCH DIAMETER), IS REQUIRED AROUND ALL NEWLY INSTALLED TREES AND PALMS.
 E. CYPRESS OR COLORED MULCH SHALL NOT BE USED.
 F. NO MULCH SHALL BE PLACED TOUCHING OR WITHIN SIX INCHES OF THE TRUNK OF A TREE OR PALM.

19. ALL NEWLY LANDSCAPED AREAS SHALL BE EXCAVATED DOWN TO A DEPTH OF 24 INCHES BELOW FINAL GRADE AND BACK FILLED WITH CLEAN DEBRIS-FREE SOIL. EXISTING SOIL MAY BE RE-USED FOR BACKFILLING IF DEBRIS IS REMOVED AND ORGANIC CONTENT IS SUFFICIENT OR SOIL IS AUGMENTED WITH TOPSOIL. CONSTRUCTION ACCESS SHALL BE RESTRICTED FROM THE LANDSCAPE AREA AFTER EXCAVATION AND BACKFILL IS COMPLETE.

20. ALL LANDSCAPE AREAS SHALL BE FINISH GRADED SUCH THAT THEY ARE A MINIMUM OF 3.5 INCHES BELOW SURROUNDING PAVED SURFACES SO AS NOT TO IMPEDE THE FLOW OF DRAINAGE INTO LANDSCAPED AREAS AND TO ALLOW FOR A 3-INCH MULCH LAYER.

21. THE LOCATION OF PLANT MATERIAL AS SHOWN ON THESE PLANS IS FINAL. THE FINAL LOCATIONS CAN BE ADJUSTED ON SITE TO ACCOMMODATE UNFORESEEN FIELD CONDITIONS. THESE CHANGES MUST COMPLY WITH ALL SAFETY SETBACK CRITERIA AND BE DIRECTED OR APPROVED BY THE CONSULTANT AND THE COUNTY CODES.

22. REPORT ANY AND ALL DISCREPANCIES BETWEEN THE CONSTRUCTION DRAWINGS AND FIELD CONDITIONS TO THE CONSULTANT AND COUNTY IMMEDIATELY.

23. THE CONTRACTOR IS RESPONSIBLE FOR VERIFYING ALL PLANT COUNTS AND REPORT ANY DISCREPANCIES TO THE CONSULTANT AND COUNTY PRIOR TO CONSTRUCTION.

24. BEFORE CONSTRUCTION BEGINS THE CONTRACTOR IS RESPONSIBLE FOR LOCATING ALL UNDERGROUND UTILITIES AND SHALL AVOID DAMAGE TO ALL UTILITIES DURING CONSTRUCTION. IF SUCH DAMAGE OCCURS THE CONTRACTOR IS RESPONSIBLE FOR ANY NECESSARY REPAIRS AND THEY SHOULD BE MADE IMMEDIATELY AT THE CONTRACTOR'S EXPENSE.

25. ALL WORK MUST COMPLY WITH THE FLORIDA STATE STATUTE 553.81- "PROTECTION OF UNDERGROUND PIPELINES."

27. THE LOCATION OF ALL THE UTILITIES SHOWN ON THE PLAN IS APPROXIMATE. THE EXACT LOCATION SHALL BE DETERMINED BY THE CONTRACTOR ON SITE. ALL PLANTING MAY BE ADJUSTED TO AVOID CONFLICTS WITH UTILITIES AND/OR EXISTING ABOVE GROUND ELEMENTS. ANY ADJUSTMENTS GREATER THAN 10 FEET SHALL BE DONE ONLY WITH THE APPROVAL OF THE CONSULTANT AND THE COUNTY.

28. CAUTION SHOULD BE EXERCISED WHEN WORKING NEAR EXISTING PLANTING AND ANY FURNISHING THAT IS TO REMAIN ON SITE TO PREVENT ANY DAMAGE. ANY SIGNS, STRUCTURES, OR PLANTING SHALL BE REPLACED AT THE CONTRACTOR'S EXPENSE IF DAMAGED BEYOND USE. DAMAGED BEYOND USE WILL BE DETERMINED BY THE CONSULTANT AND THE COUNTY.

29. ANY PUBLIC LAND CORNER WITHIN THE LIMITS OF CONSTRUCTION IS TO BE PROTECTED. IF A CORNER MONUMENT IS IN DANGER OF BEING DESTROYED AND HAS NOT BEEN PROPERLY REFERENCED, THE CONTRACTOR SHALL NOTIFY THE DISTRICT LOCATION SURVEYOR IMMEDIATELY.

30. MAINTENANCE OF TRAFFIC FOR THIS PROJECT SHALL BE IN ACCORDANCE WITH THE MANUAL OF UNIFORM TRAFFIC CONTROL DEVICES FOR STREETS AND HIGHWAYS (U.S. DEPARTMENT OF TRANSPORTATION, F.H.W.A.). ATTENTION IS DIRECTED TO STANDARD INDEX NUMBER 623 OF THE ROADWAY AND TRAFFIC DESIGN STANDARDS.

31. THE CONTRACTOR SHALL INSURE THAT INSTALLATION OF ALL PLANTING IN MEDIAN AND RIGHT OF WAYS CONFORMS TO CRITERIA SET FORTH IN F.D.O.T. ROADWAY AND TRAFFIC DESIGN STANDARDS AND IN F.D.O.T. MAINTENANCE RATING PROGRAM.

32. ANY MAINTENANCE THAT INVOLVES TRAFFIC ACTIVITY SHALL BE COORDINATED WITH THE COUNTY BEFORE AND DURING CONSTRUCTION ACTIVITIES.

33. CONTRACTOR IS RESPONSIBLE FOR CLEANING ALL WORK AREAS AT THE END OF EACH WORKING DAY. ANY DEBRIS SHALL BE COLLECTED AND DEPOSITED APPROPRIATELY OFF SITE DAILY. ALL MATERIALS, PRODUCTS, AND EQUIPMENT SHALL BE STORED IN AN ORGANIZED FASHION.

34. THE CONTRACTOR IS RESPONSIBLE FOR OBTAINING ALL PERMITS THAT ARE REQUIRED BY THE CITY FOR TREE REMOVAL, RELOCATION, TREE PROTECTION OR INSTALLATION BEFORE BEGINNING WORK.

35. ALL EXISTING TREES TO REMAIN SHALL BE PROTECTED BY INSTALLING PROTECTIVE BARRIERS AROUND THE DRIP LINE OF TREES. THESE PROTECTIVE BARRIERS SHALL BE SEEN EASILY BY OPERATORS OF TRUCKS AND OTHER EQUIPMENT. THEY SHALL BE CONSTRUCTED OF STURDY MATERIALS (NOT FLAGGING OR RIBBON) AND SHALL BE INSTALLED PRIOR TO AND DURING CONSTRUCTION.

36. DO NOT STORE OR USE ANY MATERIALS OR EQUIPMENT WITHIN THE DRIP LINE OF ANY TREE THAT IS TO BE RELOCATED OR PROTECTED IN PLACE UNLESS THE ACTIVITY IS BEING DONE TO PROTECT THE TREES.

37. DO NOT DISCHARGE OR CONTAMINATE THE SOIL WITHIN THE DRIP LINE OF ANY OF THE TREES TO BE RELOCATED OR PROTECTED IN PLACE. THIS INCLUDES SUBSTANCES SUCH AS PAINT, OIL, SOLVENTS, PETROLEUM PRODUCTS, ASPHALT, CONCRETE, MORTAR, OR ANY OTHER MATERIAL THAT MAY CAUSE DAMAGE TO THE TREE'S ROOT SYSTEM.

38. CLEARING OF VEGETATION WITHIN THE DRIP LINE OF THE TREES DESIGNATED TO BE PROTECTED IN PLACE OR RELOCATED SHALL BE PERFORMED CAUTIOUSLY WITH HAND TOOLS TO MINIMIZE ANY DAMAGE TO THE TREE'S ROOT SYSTEM.

39. DO NOT ATTACH ANYTHING TO TREES THAT ARE TO REMAIN ON THE SITE UNLESS IT IS SOMETHING THAT WILL PROTECT AND NOT DAMAGE THE TREE.

40. KEEP A NATURAL GRADE ABOVE THE DRIP LINE ON ANY TREE THAT IS TO BE PROTECTED IN PLACE. ANY PRESERVED TREES DISTURBED DURING CONSTRUCTION MUST BE RETURNED TO ITS ORIGINAL GRADE AFTER CONSTRUCTION.

41. ALL LANDSCAPE AND PLANTING SHALL COMPLY WITH COUNTY LAND USE POLICY AND WITH CHAPTER 62B-55 OF THE FLORIDA ADMINISTRATIVE CODE.

42. ALL PLANT MATERIAL FURNISHED BY THE CONTRACTOR UNLESS OTHERWISE SPECIFIED SHALL BE FLORIDA NO. 1 GRADE OR BETTER, AND SHALL BE INSTALLED AS SPECIFIED IN "GRADES AND STANDARDS FOR NURSERY PLANTS," PUBLISHED BY THE FLORIDA DEPARTMENT OF AGRICULTURE AND CONSUMER SERVICES. ALL PLANT MATERIAL MUST BE HEALTHY, VIGOROUS MATERIALS, FREE OF PESTS AND DISEASES.

43. ALL SIZES SHOWN FOR PLANT MATERIAL ON THE PLAN ARE TO BE CONSIDERED AS MINIMUMS. ALL PLANT MATERIAL MUST MEET OR EXCEED THESE MINIMUM REQUIREMENTS FOR BOTH HEIGHT AND SPREAD. ANY OTHER REQUIREMENTS FOR SPECIFIC SHAPE OR EFFECT AS NOTED ON THE PLAN OR SPECIFICATIONS WILL ALSO BE REQUIRED FOR ACCEPTANCE. ANY SUBSTITUTIONS MUST BE APPROVED BY THE CONSULTANT AND THE COUNTY.

44. THE CONTRACTOR IS RESPONSIBLE FOR ALL PLANTING MEETING SPECIFICATIONS AS NOTED BEFORE INSTALLATION. CONTRACTOR SHALL IMMEDIATELY REMOVE ALL PLANTING THAT DOES NOT MEET SPECIFICATIONS AND BE HELD RESPONSIBLE TO REPLACE IT WITH APPROPRIATE PLANTING.

45. IN THE EVENT OF A VARIATION BETWEEN THE PLANT LISTS AND THE ACTUAL QUANTITY OF PLANTS SHOWN, THE PLANS HOLD TRUE.

46. ALL ROOT BALLS SHALL CONFORM TO THE SIZE STANDARDS SET FORTH

47. ALL PLANT MATERIALS MUST BE PROTECTED DURING TRANSPORT AND DELIVERY TO THE JOB SITE WITH SHADE CLOTH OR OTHER ACCEPTABLE MEANS OF WINDBURN PREVENTION.

48. CONTRACTORS SHALL FIELD VERIFY ALL INFORMATION PRIOR TO INITIATING PLANTING INSTALLATION. ALL EXISTING PLANTING SHALL REMAIN INTACT AND UNDISTURBED UNLESS OTHERWISE NOTED ON THE PLANS.

49. CONTRACTOR SHALL FIELD STAKE THE LOCATION OF ALL PLANT MATERIAL PRIOR TO INSTALLATION FOR THE REVIEW AND APPROVAL OF THE CONSULTANT.

50. ALL TREES MUST BE FLORIDA #1, STRAIGHT TRUNKED, FULL HEADED, AND MEET ALL REQUIREMENTS SPECIFIED.

51. CONTRACTOR TO REPLACE REJECTED PLANT MATERIAL WITHIN ONE WEEK OF NOTICE.

OIL PREPARATION, SOIL MIX, FERTILIZER, & MULCH NOTES:

1. ENSURE THAT ALL PLANTING SOIL IS FERTILE, FRIABLE, NATURAL LOAM SURFACE SOIL, REASONABLY FREE OF SUBSOIL, CLAY LUMPS, WEEDS AND OTHER LITTER, AND FREE OF ROOTS, STUMPS AND STONES LARGER THAN ONE INCH IN ANY DIMENSION, AND OTHER EXTRANEOUS OR TOXIC MATTER HARMFUL TO PLANT GROWTH. SHOULD ANY SOIL AMENDMENT BE NECESSARY, THE CONTRACTOR SHALL BRING THIS TO THE ATTENTION OF THE CONSULTANT AND THE COUNTY.
2. APPLY APPROVED HERBICIDE- ACCORDING TO MANUFACTURERS RATE AND SPECS WITHIN LIMITS OF ALL AREAS TO BE PLANTED. PROTECT EXISTING PLANTS TO REMAIN FROM OVERSPRAY OR SPRAY WITHIN ROOT ZONE. CONTRACTOR AND COUNTY TO ENSURE TOTAL WEED ERADICATION.
3. SCARIFY SUBSOIL TO A DEPTH OF 3 INCHES.
4. PLANTING MIX FOR TREES, SHRUBS, AND GROUNDCOVERS SHALL CONSIST OF A THOROUGHLY BLENDED MIXTURE OF:
 - A. 20% TOPSOIL
 - B. 10% PEAT OR COMPOST
 - C. 70% SAND
5. PLANTING MIX FOR BACKFILL AROUND ROOT BALLS OF PALMS:
 - A. 90% NATIVE SAND FROM ON SITE OR APPROVED SUBSTITUTE
 - B. 10% TOPSOIL
6. FERTILIZE ALL TREES, SHRUBS AND GROUNDCOVER WITH PLANTING TABLETS 20-20-5 FORMULA, 21 GRAM.
7. ALL SHRUB BEDS SHALL BE EXCAVATED TO A MINIMUM DEPTH OF 24" AND BACK FILLED WITH THE SPECIFIED MIXTURE.
8. SMOOTH ALL PREPARED TOPSOIL TO 3" EXCEPT WITHIN DRIP LINES OF EXISTING TREES AND 4" BELOW TOP OF SURROUNDING PAVING EDGES. REMOVE ALL ROCKS AND OTHER OBJECTS OVER 1" IN DIAMETER.
9. FINISH GRADE ALL PREPARED TOPSOIL AREAS TO A SMOOTH, EVEN SURFACE ASSURING POSITIVE DRAINAGE AWAY FROM THE STRUCTURES AND ELIMINATE ANY LOW AREAS WHICH MAY COLLECT WATER.
10. TOPSOIL SHALL NOT BE EXTREMELY ACIDIC OR ALKALINE, NOR CONTAIN ANY TOXIC SUBSTANCE WHICH MAY BE HARMFUL TO PLANT GROWTH. THE PH SHALL BE IN THE RANGE OF 5.5-6.5.
11. CONTRACTOR SHALL MULCH ALL PLANTING MATERIAL THROUGHOUT AND COMPLETELY TO A 3 INCH DEPTH WITH CLEAN, WEED FREE FLORAMULCH

REVISIONS

IRRIGATION NOTES:

1. XERISCAPE PRINCIPLES HAVE BEEN APPLIED TO THIS LANDSCAPE PLAN AS SPECIFIED IN SFWMD's XERISCAPE PLANT GUIDE II AND SHALL BE APPLIED ALL THROUGHOUT LANDSCAPE INSTALLATION AND MAINTENANCE.
2. THE CONTRACTOR SHALL MAINTAIN TEMPORARY IRRIGATION OR PROVIDE HAND WATERING FOR ALL RELOCATED TREES AND PALMS FROM NOTICE TO PROCEED UNTIL PERMANENT IRRIGATION SYSTEM IS OPERABLE.
3. THE IRRIGATION SYSTEM SHALL BE CONFIGURED TO ACCOMMODATE EXISTING TREES AND PALMS PER PLANS.
4. ALL LANDSCAPED AREAS MUST BE IRRIGATED IN ACCORDANCE WITH ALL LOCAL/ COUNTY REQUIREMENTS.
5. REMOVE EXISTING IRRIGATION EQUIPMENT WHICH INTERFERES WITH ANY CONSTRUCTION. THIS INCLUDES, BUT IS NOT LIMITED TO, CONTROLLERS, SPRINKLER HEADS, PIPE, QUICK COUPLERS, BACKFLOW PREVENTERS, CONTROL WIRE AND CONDUITS. ADDITIONALLY THE CONTRACTOR IS RESPONSIBLE FOR MAINTAINING THE EXISTING SYSTEM THROUGHOUT THE CONSTRUCTION PROCESS.
6. CONTRACTOR SHALL COORDINATE ALL PLANTING WORK WITH IRRIGATION WORK. INSPECT IRRIGATION SYSTEM AND INSURE THAT ADEQUATE WATER IS AVAILABLE BEFORE BEGINNING PLANTING OPERATIONS. IRRIGATION SYSTEMS WILL NOT PROVIDE SUFFICIENT QUANTITIES OF WATER FOR NEWLY PLANTED MATERIALS. THE LANDSCAPE CONTRACTOR IS RESPONSIBLE FOR DEEP ROOT HAND WATERING.

H:\102025\FLA250080.00\CAIDRAWINGS\PLAN SETS\CIVIL PLANS\IP-CIVIL-LAND-FLA250080.00-0A----->LAYOUT: L-705 LANDSCAPE NOTES